

10.2.04
19.3.04
17.3.04
8.6.04


PROFILE No #2 & 121.

SCALE $\frac{1}{8}'' = 1 \text{ FOOT}$

DIMENSIONS 360'0" x 48'0" x 30'10" MLD

NOTE: FRAME MARKED X TO BE
PUNCHED FOR BATTEN CLEATS
TO HEIGHT OF UPPER DECK.

SKETCH SHOWING CHANNEL CONNECTIONS
TO HATCH END BEAMS & BULKHEADS.






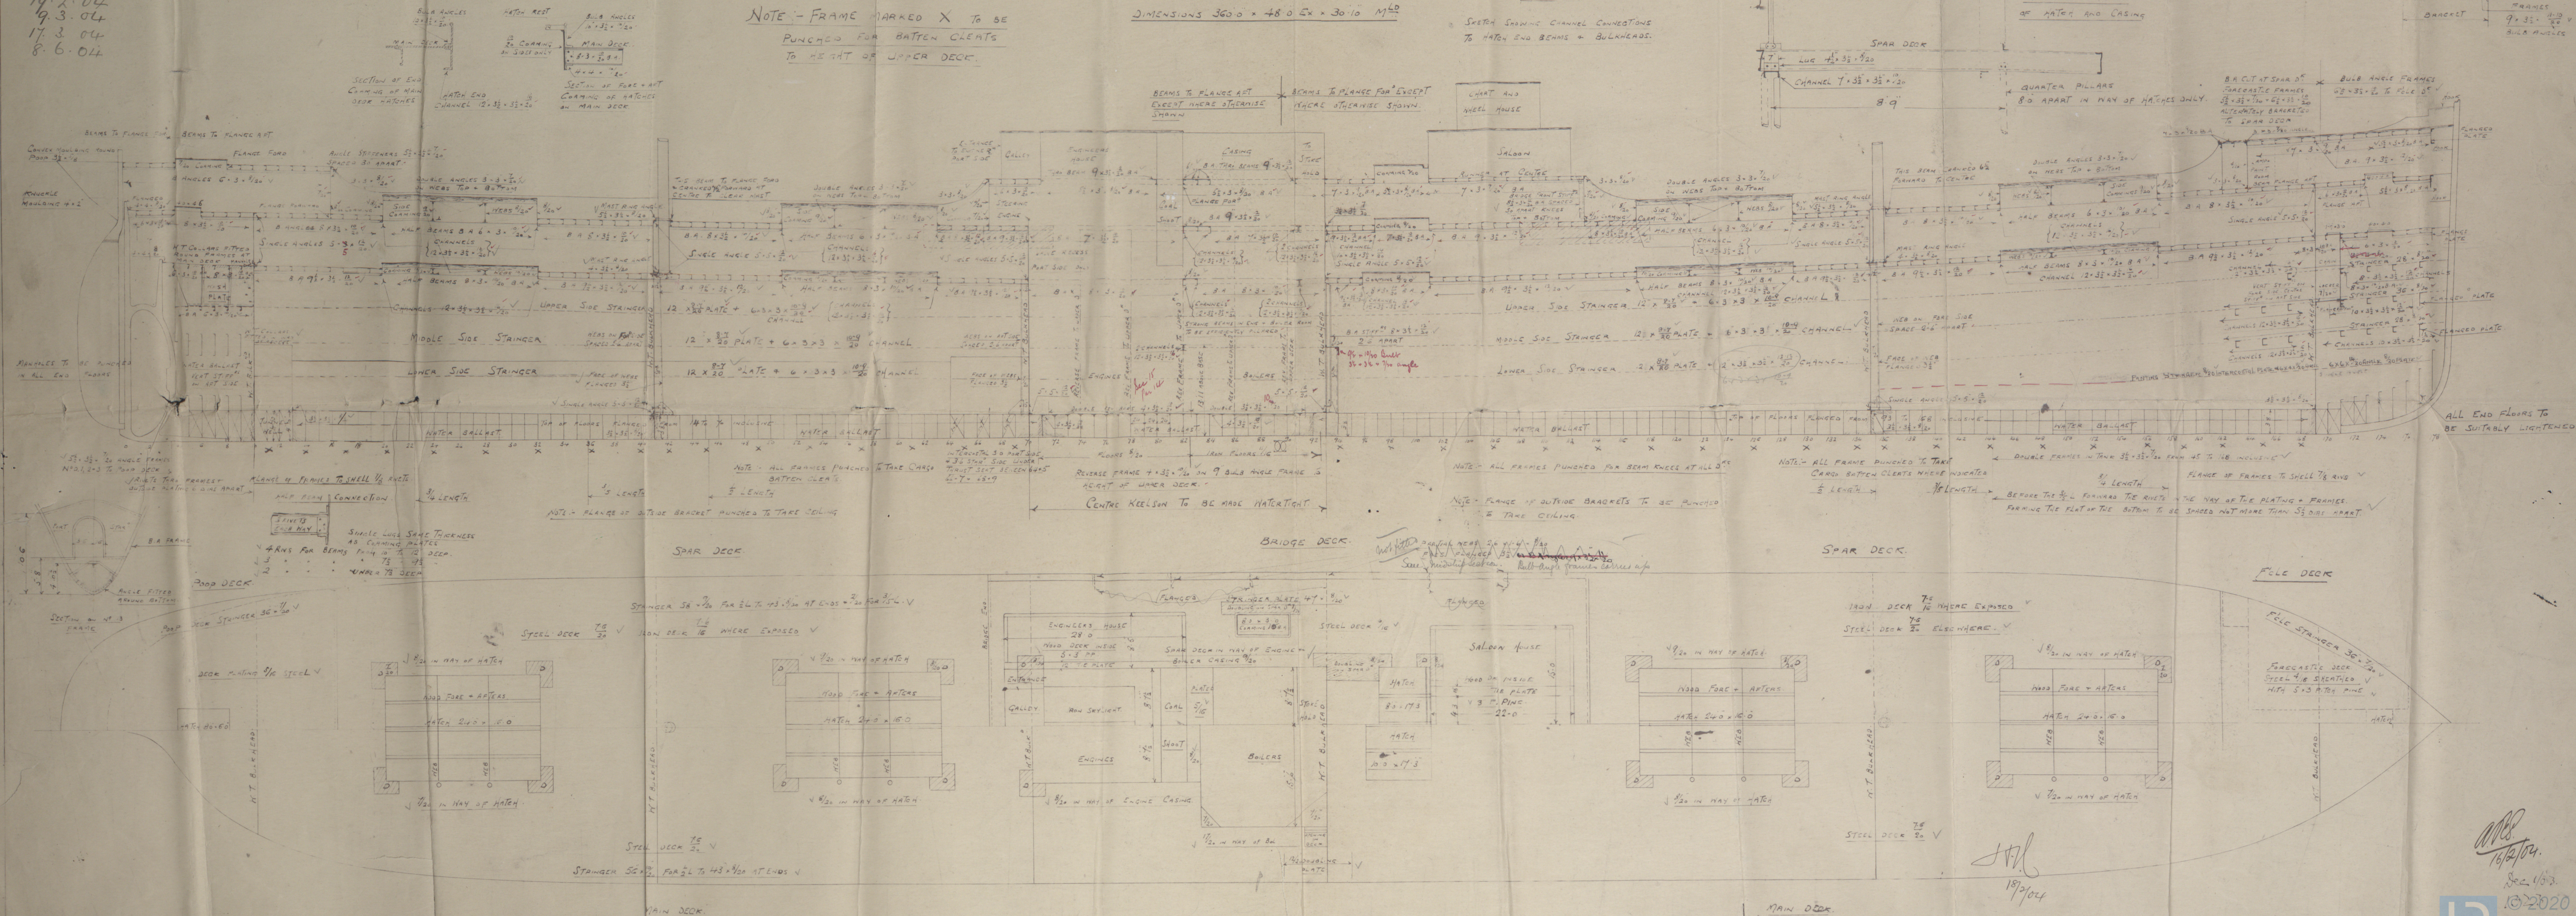


Northumberland S. Co.
S.S. No 121

Profile

36'0" x 48'0" x 30'10" Mld.

Spur Sk.

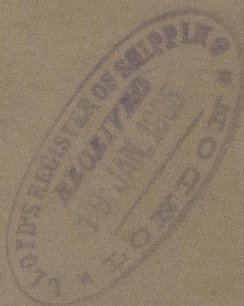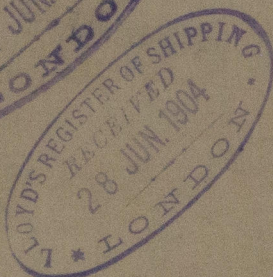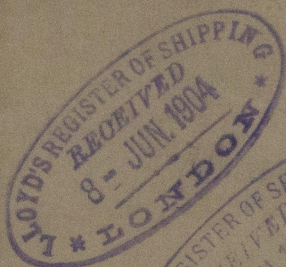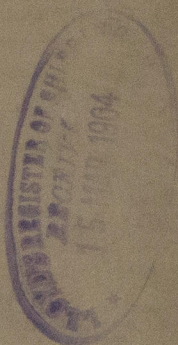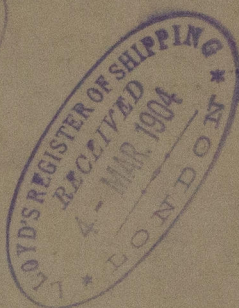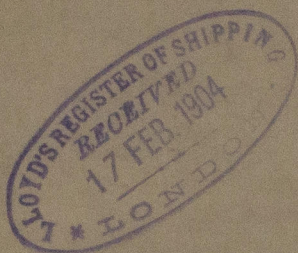


120
13

J. P. Newton

Newcastle Report

No 48,353

RETAIN

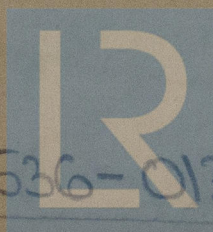

© 2020

W536-0133

Lloyd's Register
Foundation