



23.6.14
31.7.14
13.8.14
27.8.14
11.9.14

N.V. SCHEEPSWERF
"DORDRECHT"
N^o 1434 DATUM 18/6.14

Midship Section

twin screw Motor tank vessel, classed

500 A1

Scale $\frac{1}{2}'' = 1'0''$

Dimensions.

Length p.p.	563'-0"
Breadth mls.	28'-5 $\frac{1}{2}$ "
Depth	32'-0"
Draught loaded	30'-0"

Equipment.

3 BOWERS STOCKLESS	12 $\frac{1}{2}$ CWTs	TOTAL WEIGHT	35 $\frac{1}{2}$ CWTs.
1 STREAM	4 CWTs	EXCL STOCK.	
1 KEDGE	1 $\frac{3}{4}$ "	"	"
195 FATH.	1 $\frac{3}{16}$ "	"	"
60 "	2 $\frac{3}{4}$ "	"	"
75 "	2 $\frac{3}{4}$ "	"	"
90 "	6 "	"	"


Scantlings.

1 st DB ²	= L (B+D) =	6593.3
2 nd "	= B+D =	40.45
	L:D =	13.58

Equipment DB²

L (B+D) =	6593.3
R.G. Deck =	60 x 4'0" = 240.-
Fore Castle =	3'4" x 23'4" = 120.7
	<u>6954</u>

71115 Equip No.




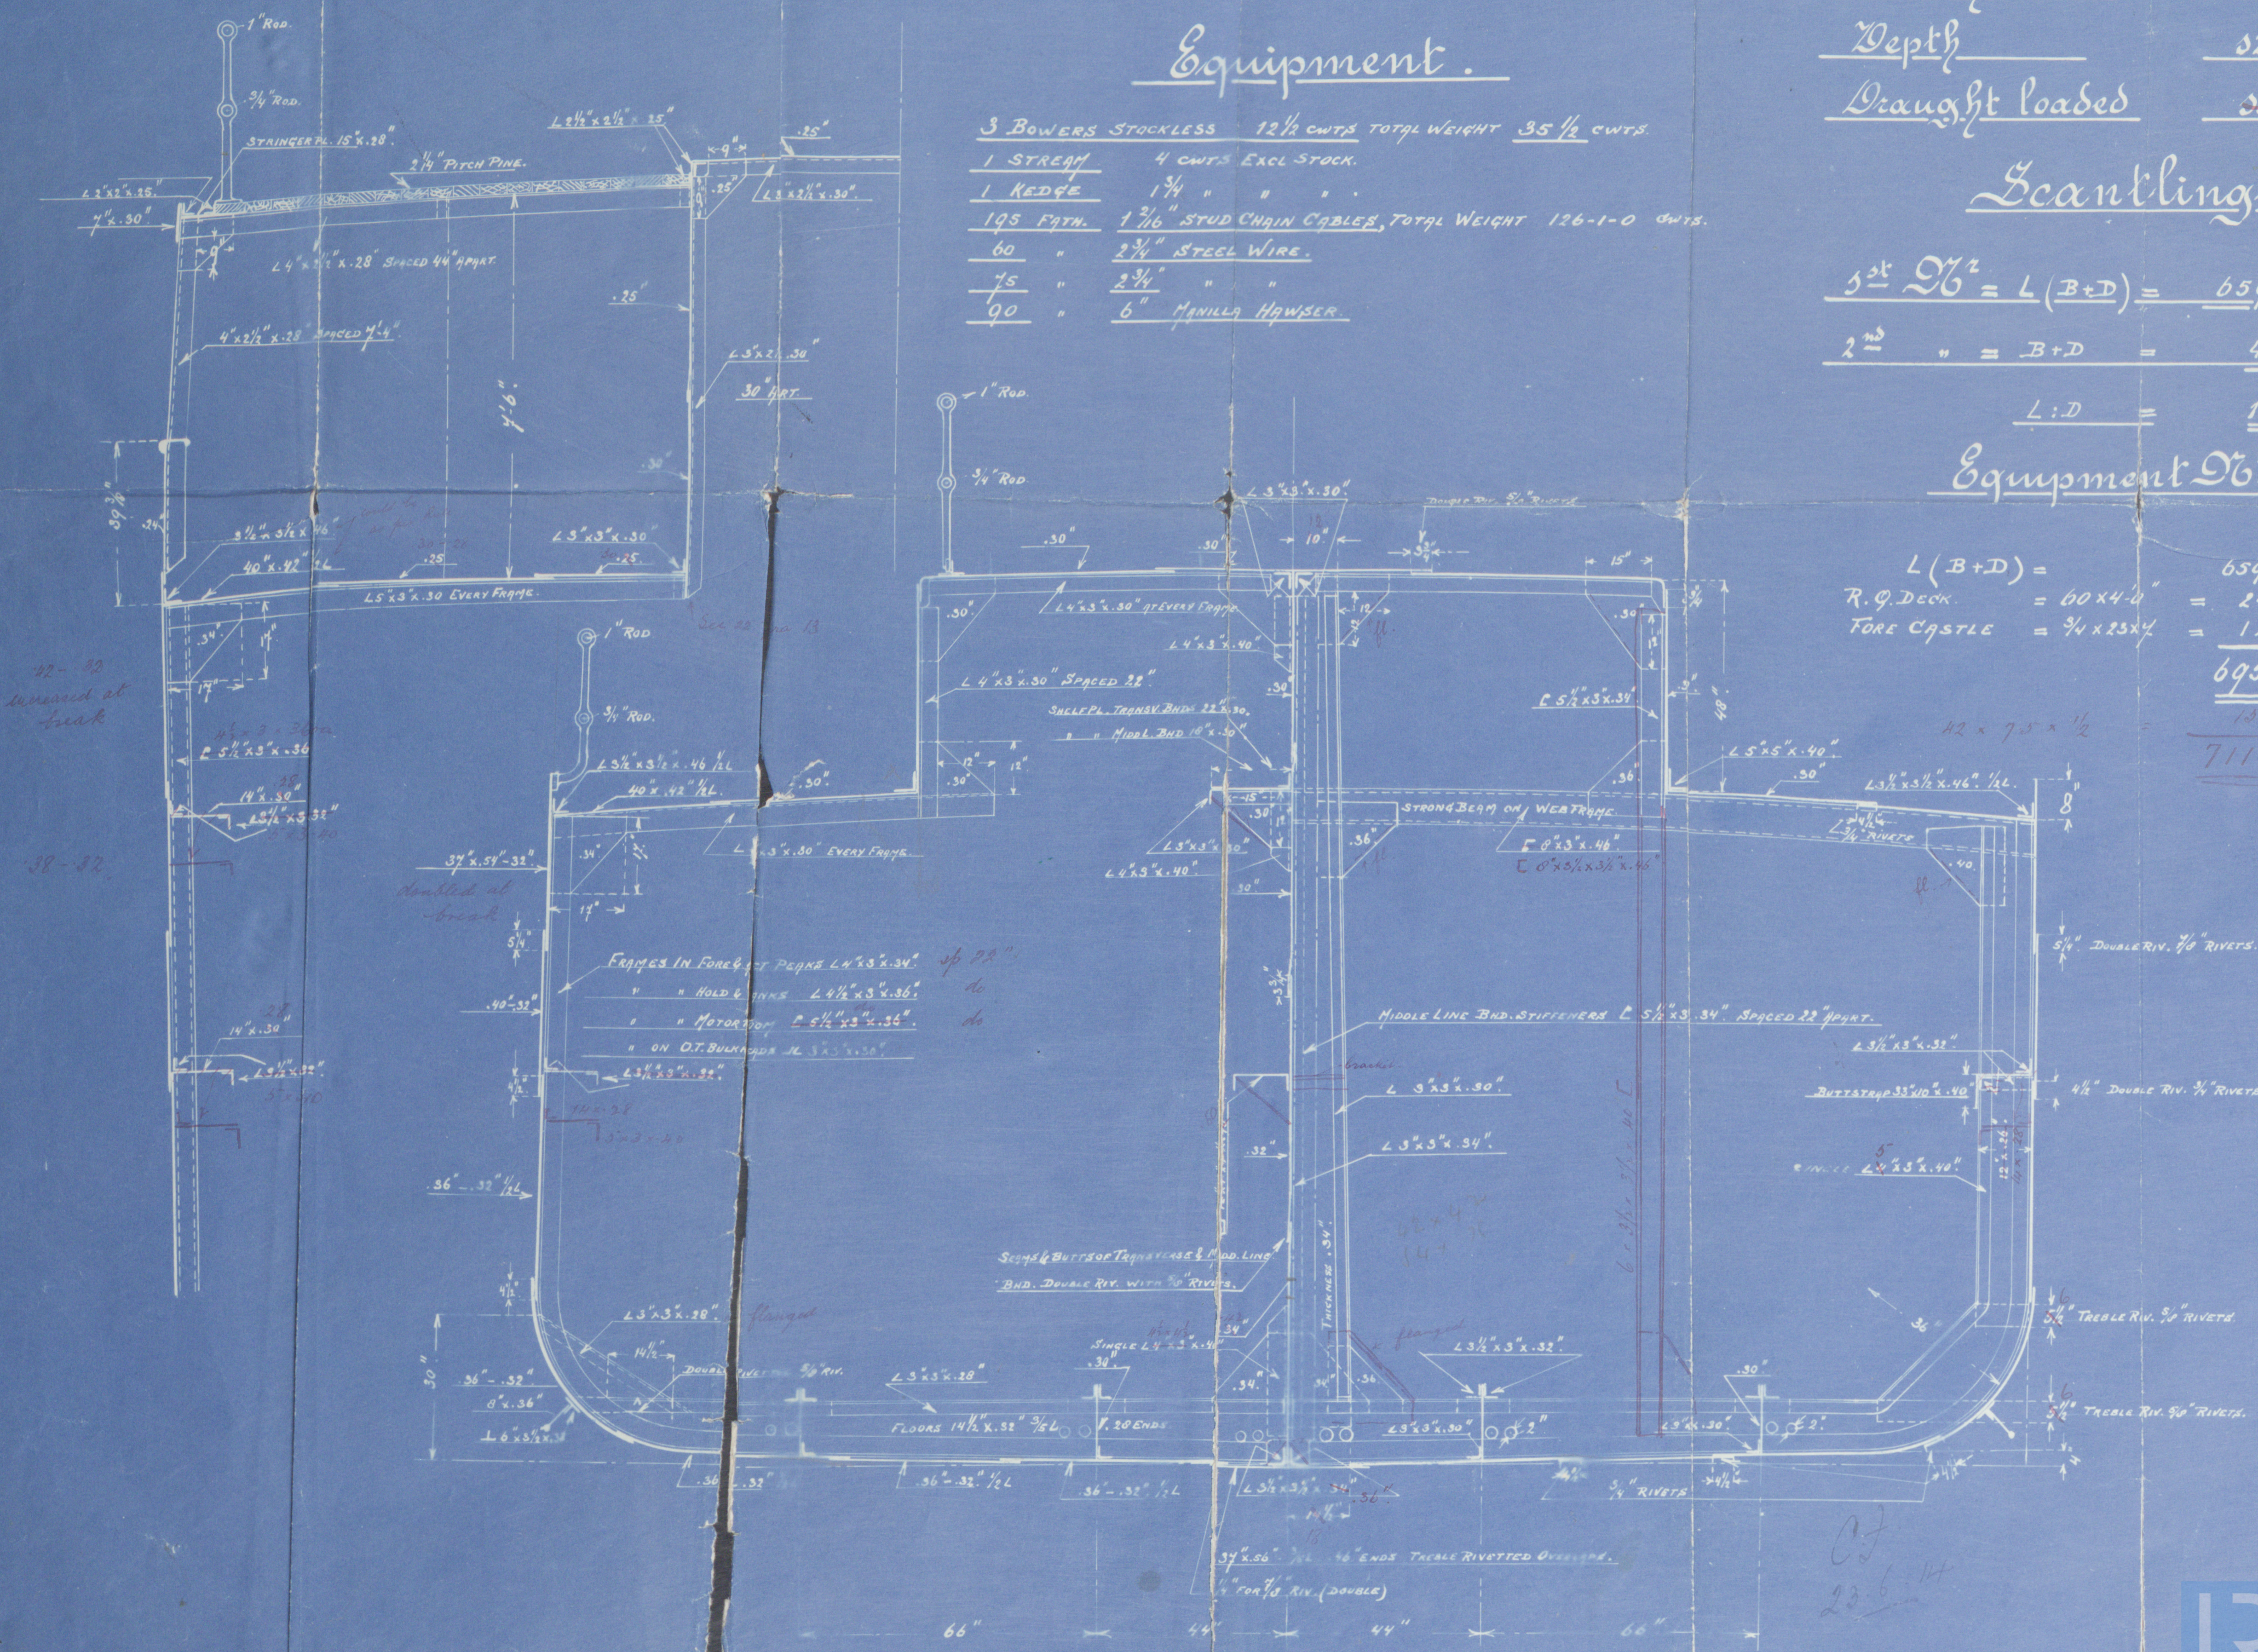





Rotterdam Report No. ¹¹ 9490

Motorship "Hera"
Hull No. 2

Midship Section

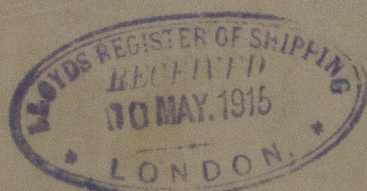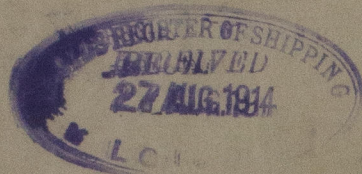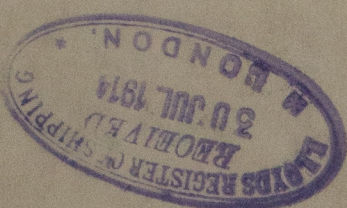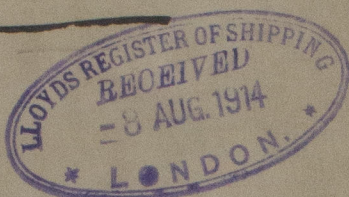

W 536 - 0255

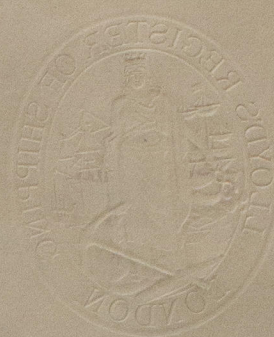

© 2020

Lloyd's Register
Foundation