


CONSTRUCTION PLAN OF S. S. KIRISHIMA MARU. SCALE $\frac{1}{8}$ TO 1 FOOT.

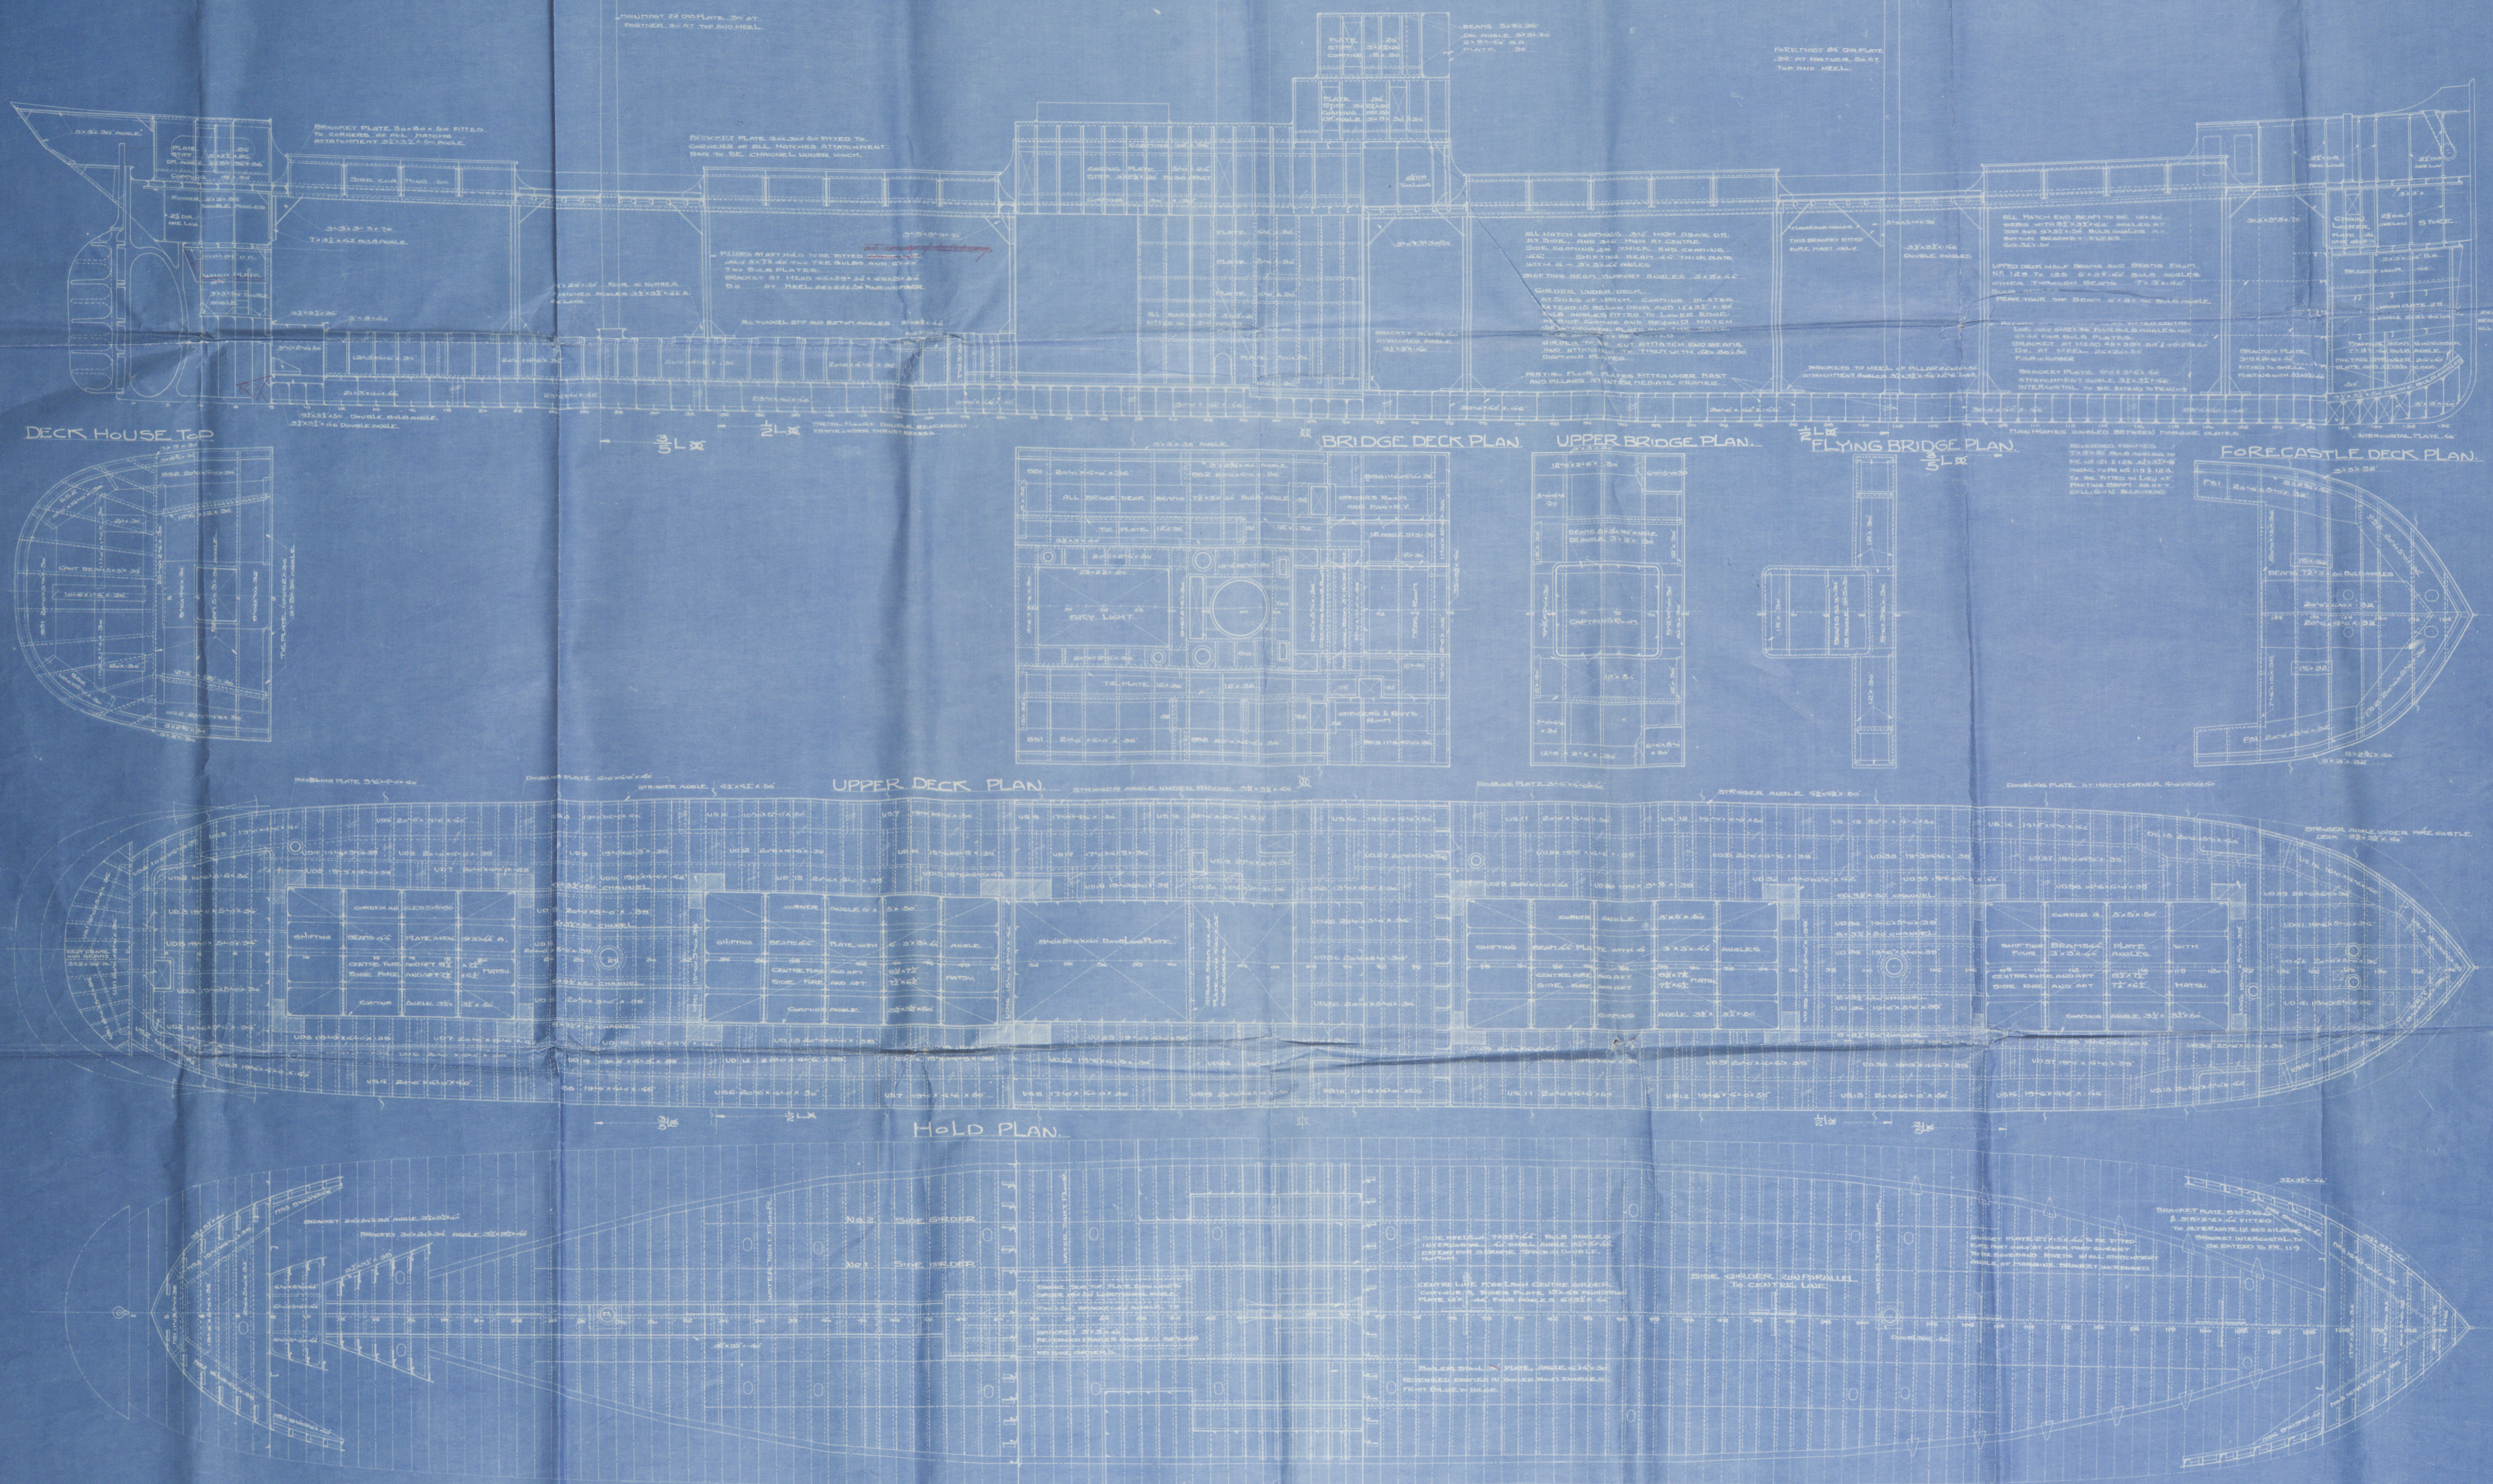

FUJINAGATA Dock YARD, OSAKA.

Fujinagata No 21

S.S. ~~Kirishima Maru~~


"Wagland"

Construction Plan

Kobe Report No 1954



W536-0409

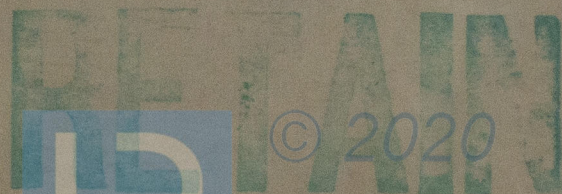

© 2020

Lloyd's Register
Foundation