

8-10-08

SCALE $\frac{1}{8}$ INCH = ONE FOOT.

WOOD DECK ALL FORE & AFT.

" SHELTER DECK

STRINGER 40 \times ¹⁰20 To 30 \times ⁷20 ✓
STRINGER BUTTS TREBLE FOR $\frac{3}{4}$ L.
DOUBLE AT ENDS
DECK LAPS DOUBLE FOR $\frac{1}{2}$ L ✓
 " " SINGLE AT ENDS ✓

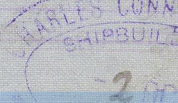
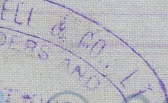
 

UPPER DECK

STRINGER 15×20 TO 37×80
 STRINGER BUTTS TREBLE FOR $\frac{3}{4}$ L.
 DOUBLE AT ENDS
 DECK LAPS DOUBLE FOR $\frac{1}{2}$ L.
 " " SINGLE AT ENDS

MAIN DECK

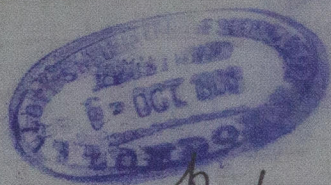
STRINGER 41 x $\frac{1}{2}$ TO 32 x $\frac{1}{2}$ ✓
STRINGER BUTTS DOUBLE RIVETED
DECK PLATING LAPS SINGLE

C.B.
8.10.08

C Council &
Deck Plans

N^o 325 ^S/_S
MINDEROO



Glasgow Report

No. 24642.



© 2020

Lloyd's Register
Foundation

W537-039