

DETAIL OF SHELL RIVETTING, SCALE $\frac{1}{2}$.

RIVETTING & C

339

2 MAIN BOILERS FOR N^o 339.

Dunsmuir & Jackson



339. W.P. 200

amended plan

^{808m}
S/S "Munderwood"

Glasgow Report

Nº 24642

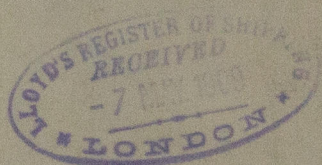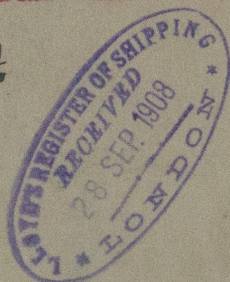

RETAILED



WS37-20312

Lloyd's Register
Foundation