


6. 2. 03

Midship Section No. 223.

Length B.P. 228'-0"

Breadth Mld^d 34'-9"Depth Mld^d to main Wk 16'-9"

Scale 1/2" = 1 Foot.

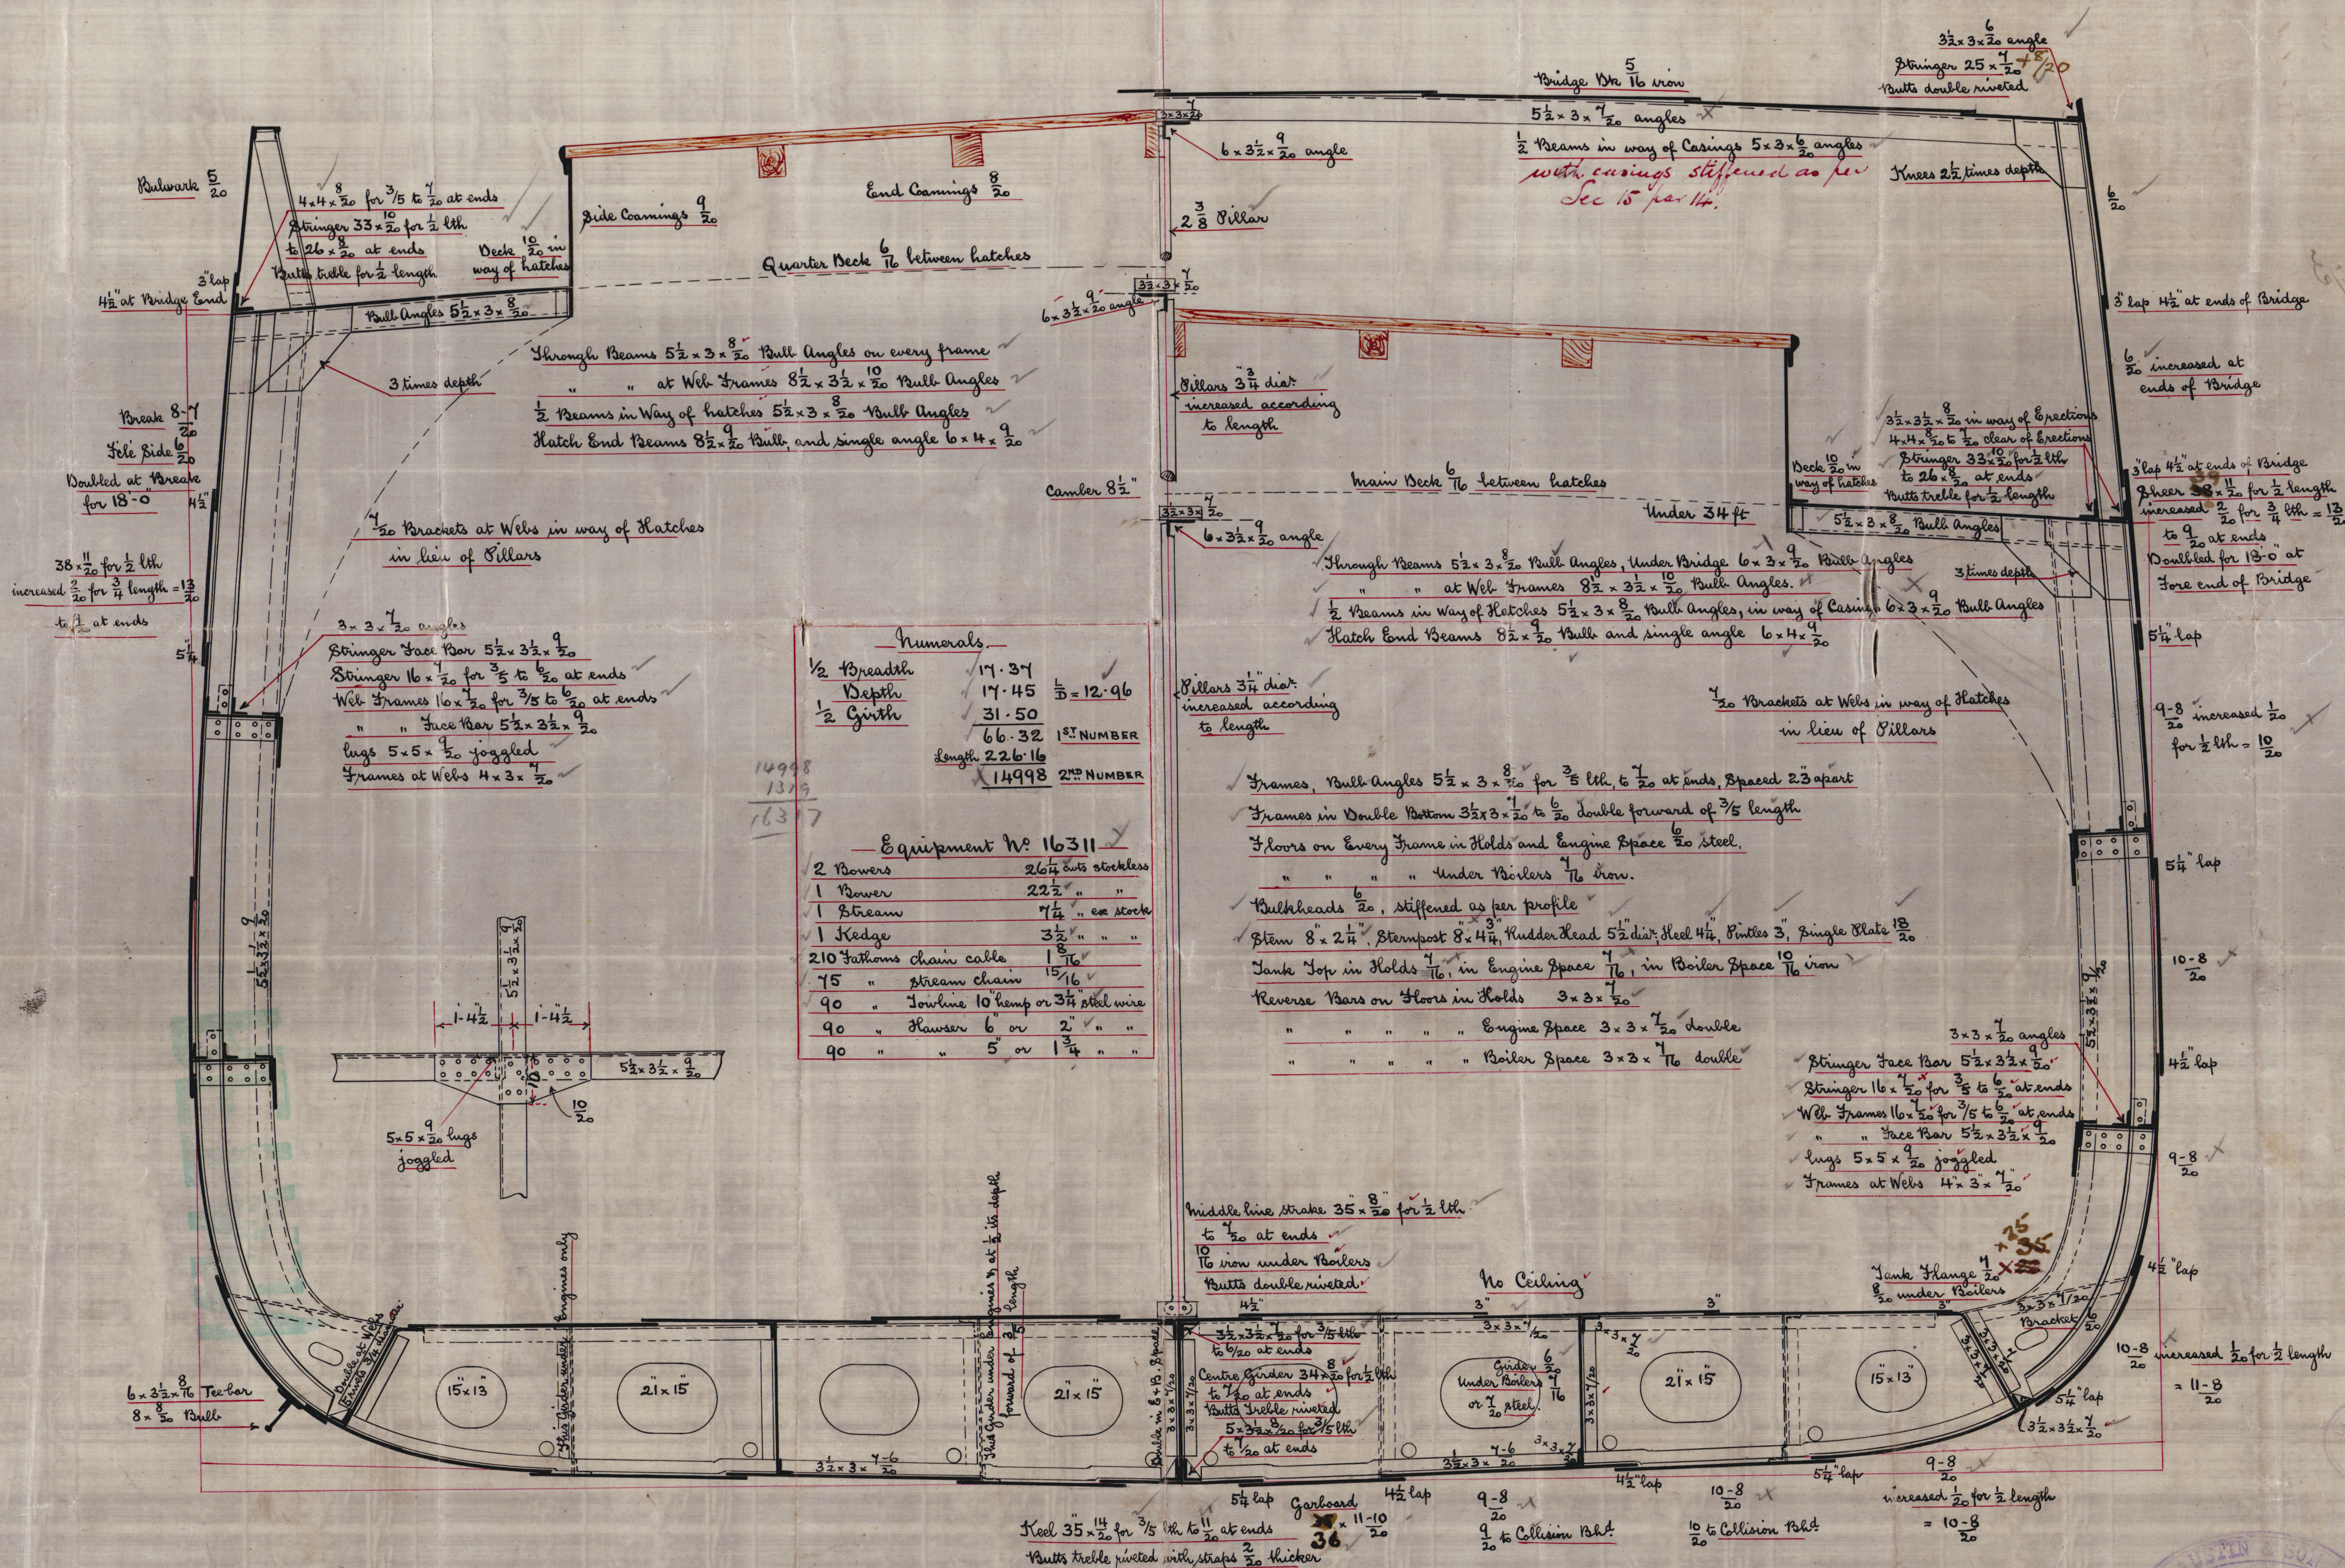

Butts of Shell lapped and treble riveted for 1/2 length, double at ends
Where outside strakes exceed 46, and inside strakes exceed 54, Butts quadruple for 1/2 length treble at ends
All parts of Double Bottom increased 1/16 in Boiler Space.

2/2/03
STEEL & IRON SHIPBUILDERS
AND
REPAIRERS
J.S.S.

© 2021

Lloyd's Register
W53870311pn

No. 223
SS St. Agnes
Marine
Section


Sld for No 21456

6-2-03

Sunderland H.E. 214/3

W538-0311

1. 2×2
 2. 2×2
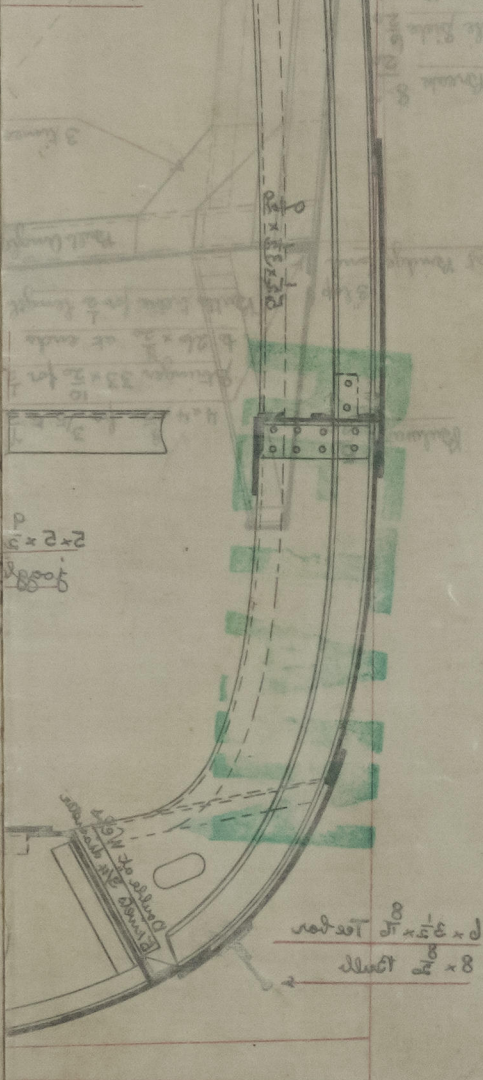


W538-0311