


with Freeboard

TO CLASS ✕ 100A1/LLOYDS

11.12.22

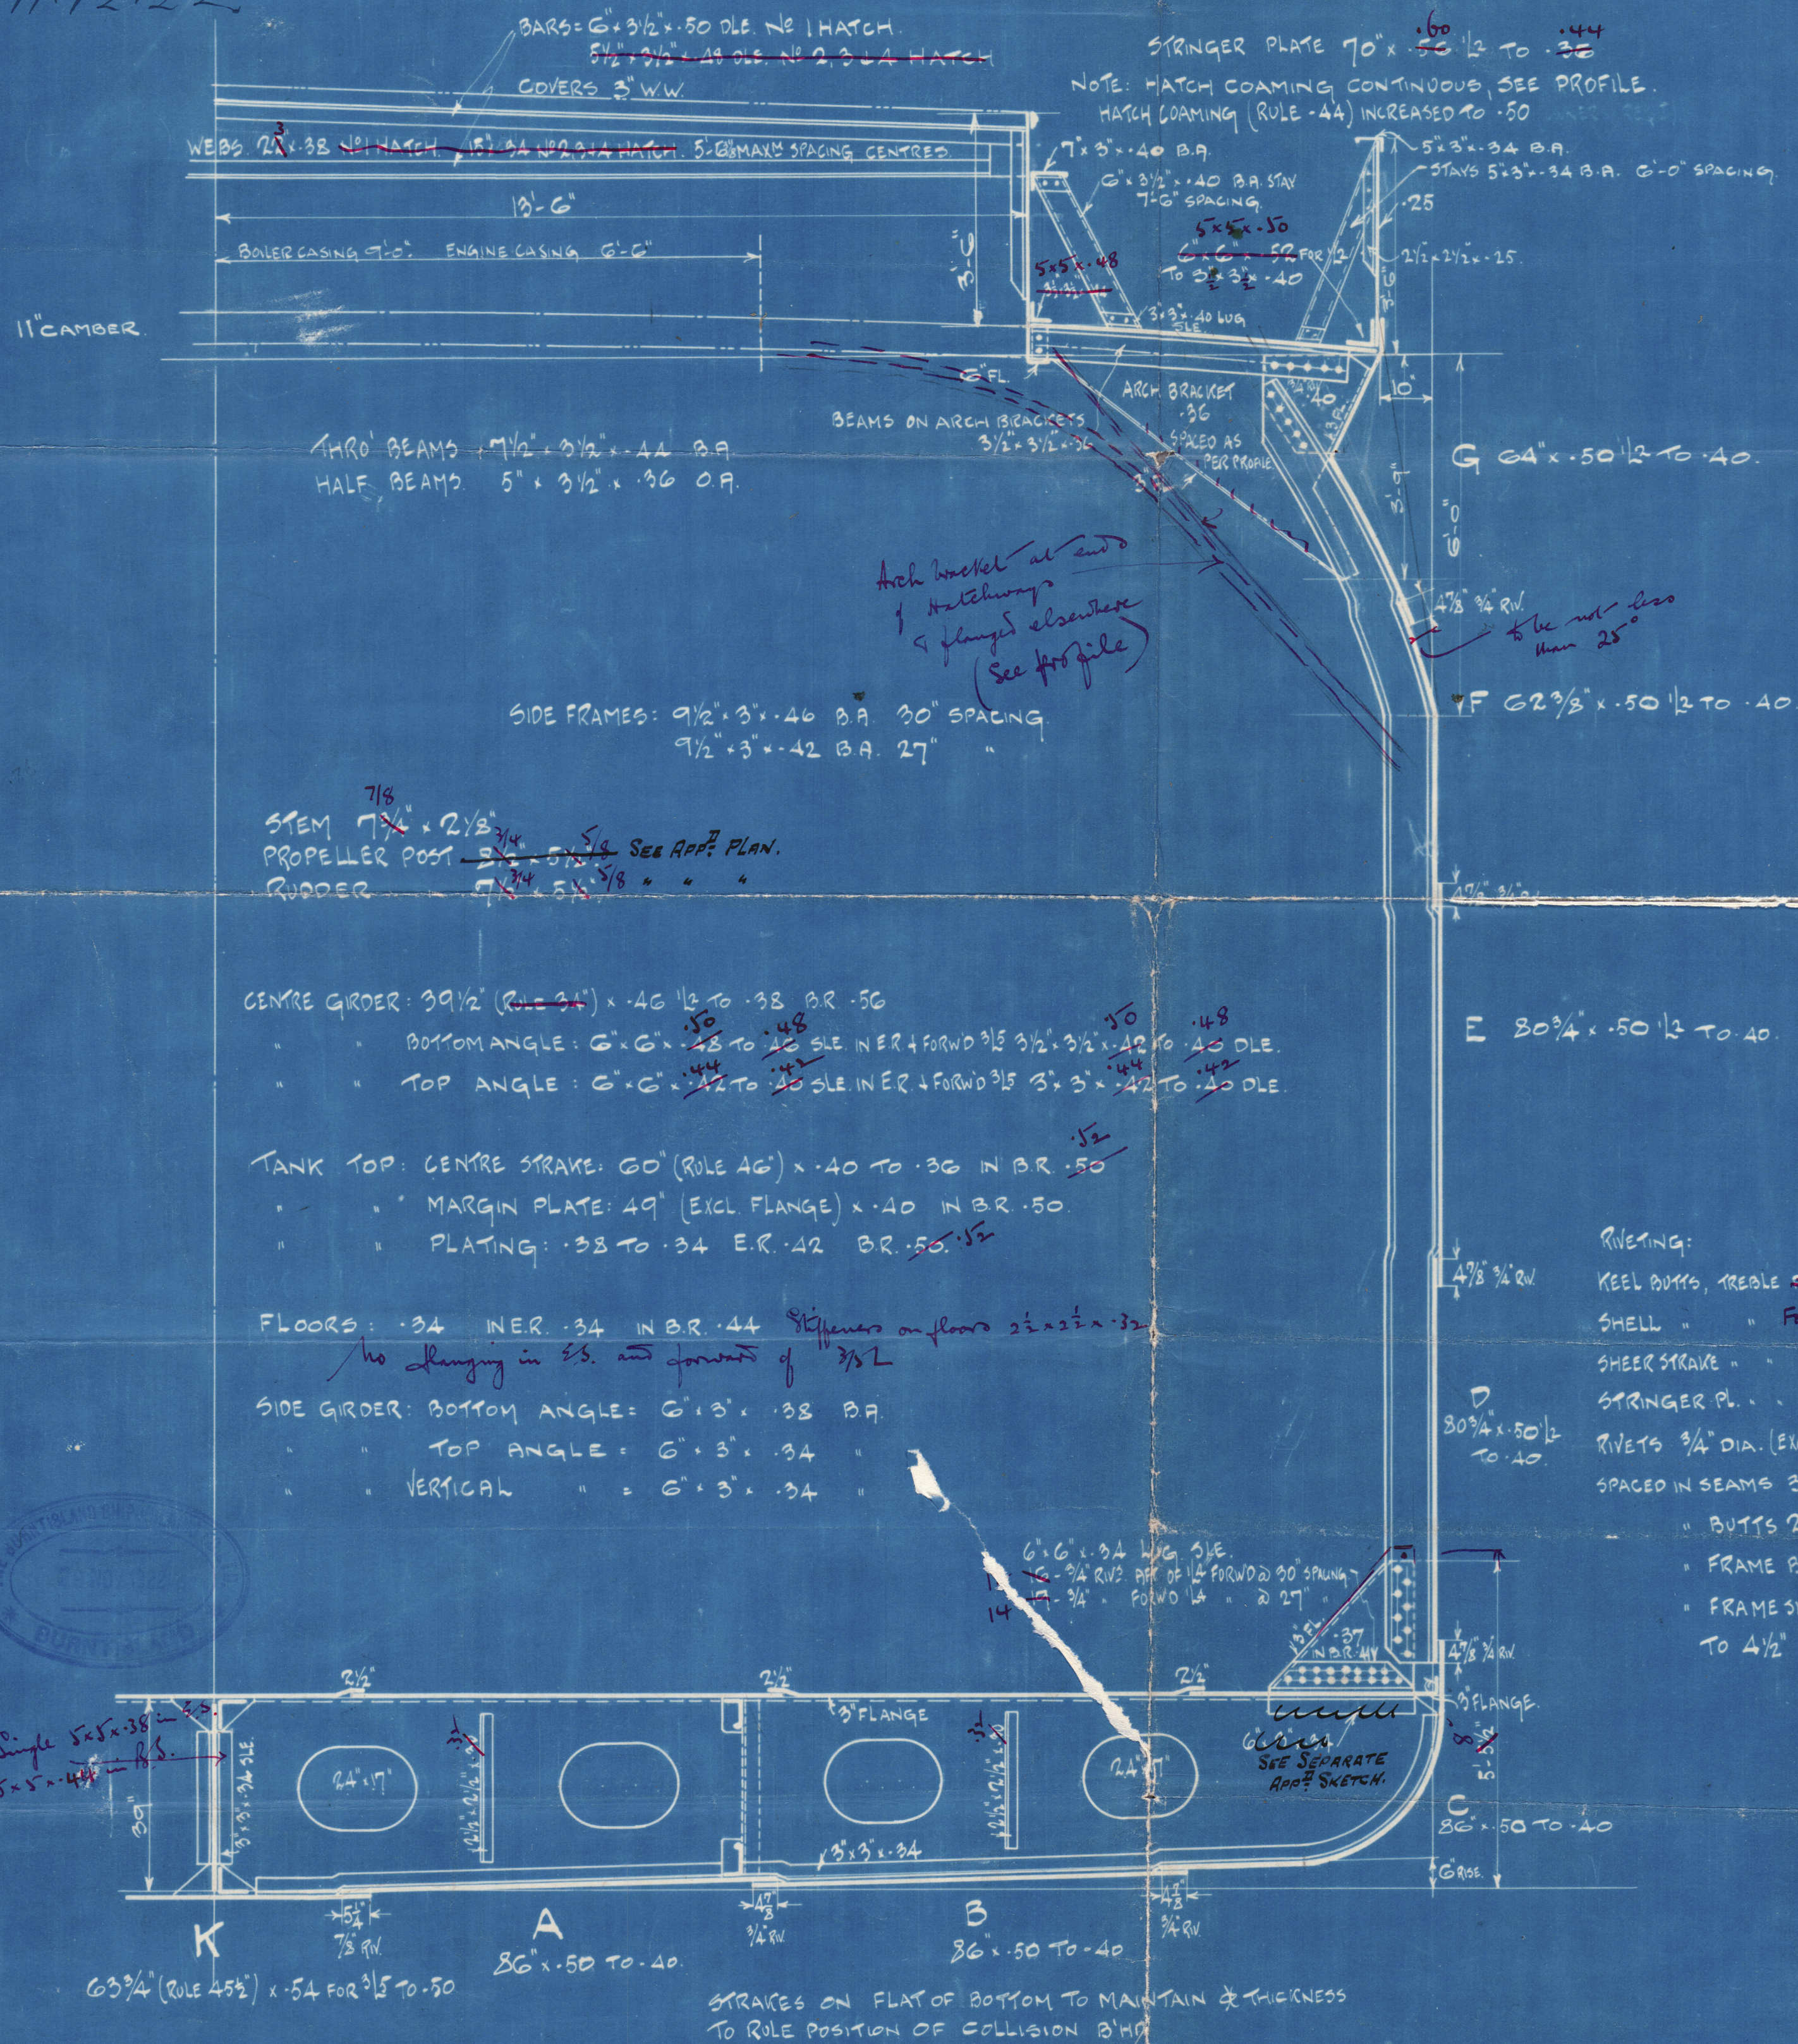

EQUIPMENT.

3 BOWER ANCHORS, STOCKLESS
COLLECTIVE WEIGHT 101 CWT.

1 STREAM ANCHOR EKL STOCK 9 1/4 "

240 FATH. 1 1/2" / 6" STUD CHAIN CABLE.

1275 FATH. 4" STEEL WIRE.

1290 " 3 1/2 " "

2 HAWSEBS 290 FATH. EACH. 2 1/2" STEEL WIRE

2 WARPS 290 " " 1 3/4 " "

RIVETING:

KEEL BUTTS, TREBLE ~~FOR 1/2~~ TO DOUBLE SHELL " " FOR $\frac{1}{2}$ L To Double

SHEER STRAKE " " " " " "

STRINGER PL. " " " " " "

RIVETS $\frac{3}{4}$ " DIA. (EXCEPT KEEL

SPACED IN SEAMS 3" MULTIPLES.

" BUTTS $2\frac{5}{8}$ " " "

" FRAME BOTTOM $5\frac{1}{4}$ " " "

" FRAME SIDE EQUIVALENT

TO $4\frac{1}{2}$ " SPACING.

PLAN N° 418.
PRINT N° 932.

LR 10.1.2021
9.12.22
Lloyd's Register
Foundation

WS 38-0497

Brunswick S.F. Co.


No. 123.

Midship Section.

"Sheaf Brook"

Lth 16515

RETAIN

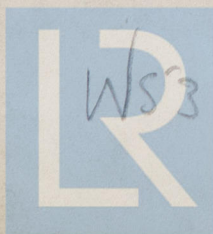

© 2021

WS38-0497

Lloyd's Register
Foundation