

SHIP N° 123. PROFILE & DECKS.




SCALE $\frac{1}{8}$ " = ONE FOOT.

DIMENSIONS:- 283'-6" B.P. x 40'-2" MLD. x 25'-5" MLD. TO ARCH DECK.




SUMMER LOAD DRAFT = 18'-7 $\frac{1}{2}$ " MLD.

POOP SIDE PLATING: 36"
FRAMES 5 $\frac{1}{2}$ " x 30" B.A. AT FRAMES MARKED X
INTERMEDIATE: 4 $\frac{1}{2}$ " x 32" O.A. NO BOTTOM CONNECTION.


POOP FRONT PLATING: 36"
COAMING: 38"
STRENGTHENERS 5 $\frac{1}{2}$ " x 30" O.A.

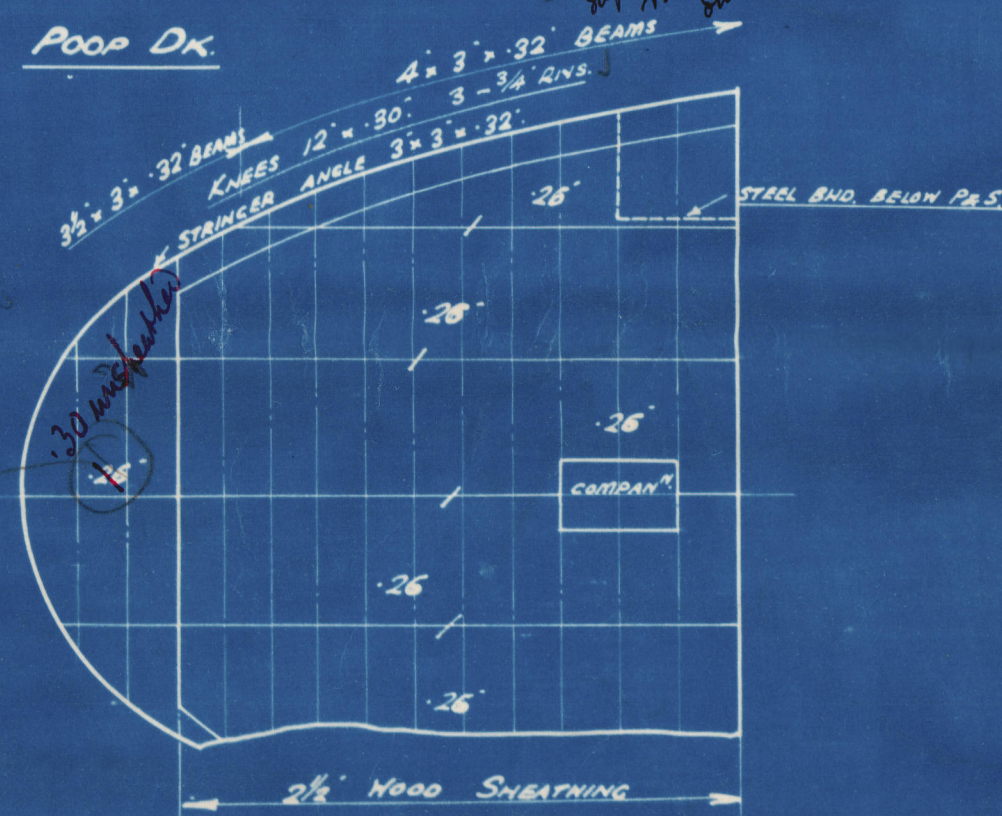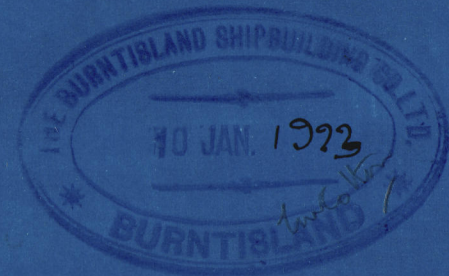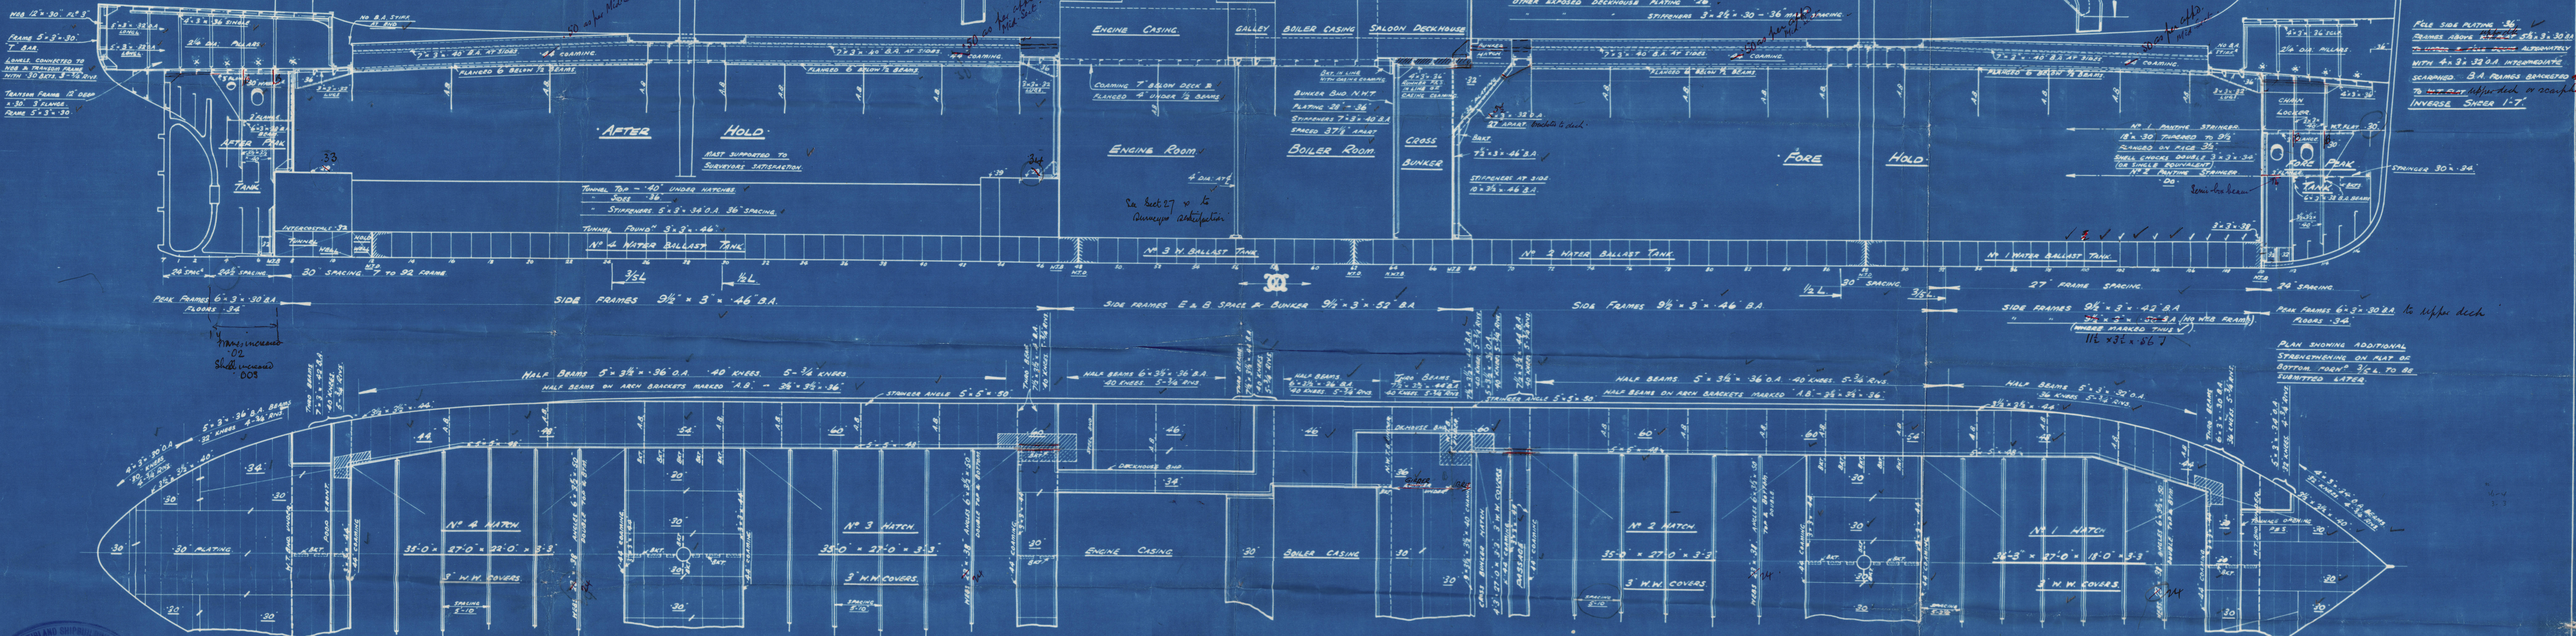

ITEM	BULK. N° 8	BULK. N° 47	BULK. N° 67	BULK. N° 100
BULKHEAD FRAME	5 $\frac{1}{2}$ " x 40" B.A.	3 $\frac{1}{2}$ " x 44"	2 $\frac{1}{2}$ " x 44"	5 $\frac{1}{2}$ " x 44"
TANK BAR	3 $\frac{1}{2}$ " x 44"	3 $\frac{1}{2}$ " x 44"	3 $\frac{1}{2}$ " x 44"	3 $\frac{1}{2}$ " x 44"
BEAM	3 $\frac{1}{2}$ " x 36"	3 $\frac{1}{2}$ " x 36"	3 $\frac{1}{2}$ " x 36"	3 $\frac{1}{2}$ " x 36"
PLATING	36" - 38"	26" - 32"	26" - 32"	26" - 32"
STRENGTHENERS	7 $\frac{1}{2}$ " x 48" B.A.	10 $\frac{1}{2}$ " x 48" B.A.	10 $\frac{1}{2}$ " x 48" B.A.	7 $\frac{1}{2}$ " x 48" B.A.
SPACER	24"	30 $\frac{1}{2}$ "	30 $\frac{1}{2}$ "	24"
KNEES	17 $\frac{1}{2}$ " x 4 $\frac{1}{2}$ " B.A.	25 $\frac{1}{2}$ " x 25 $\frac{1}{2}$ "	25 $\frac{1}{2}$ " x 25 $\frac{1}{2}$ "	18 $\frac{1}{2}$ " x 4 $\frac{1}{2}$ " B.A.
COAMING	—	36" x 38"	36" x 44"	37" x 38"

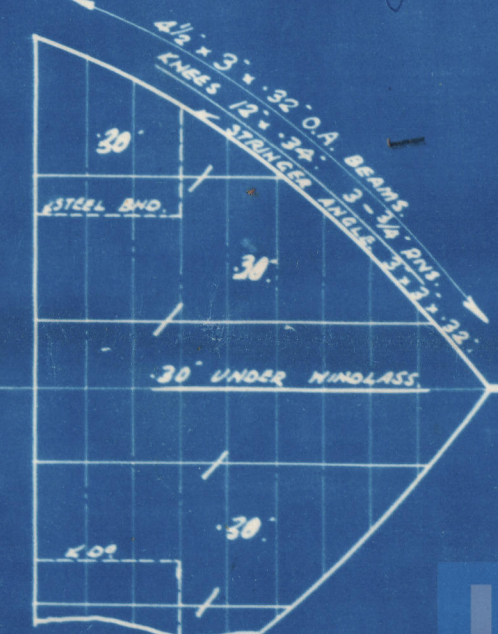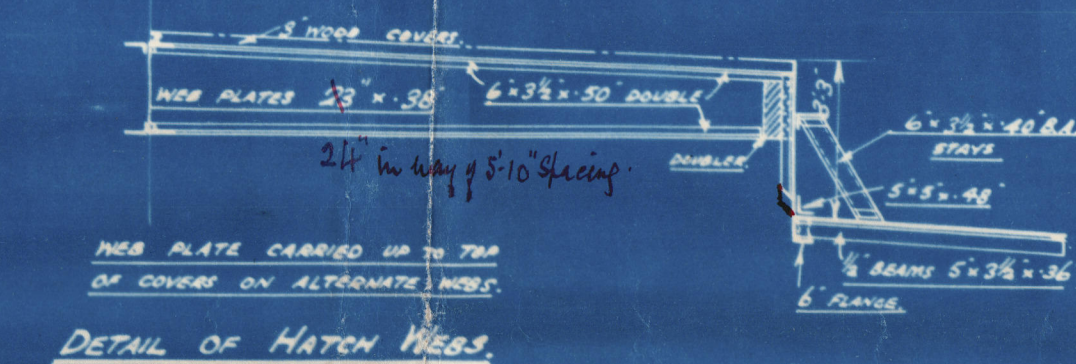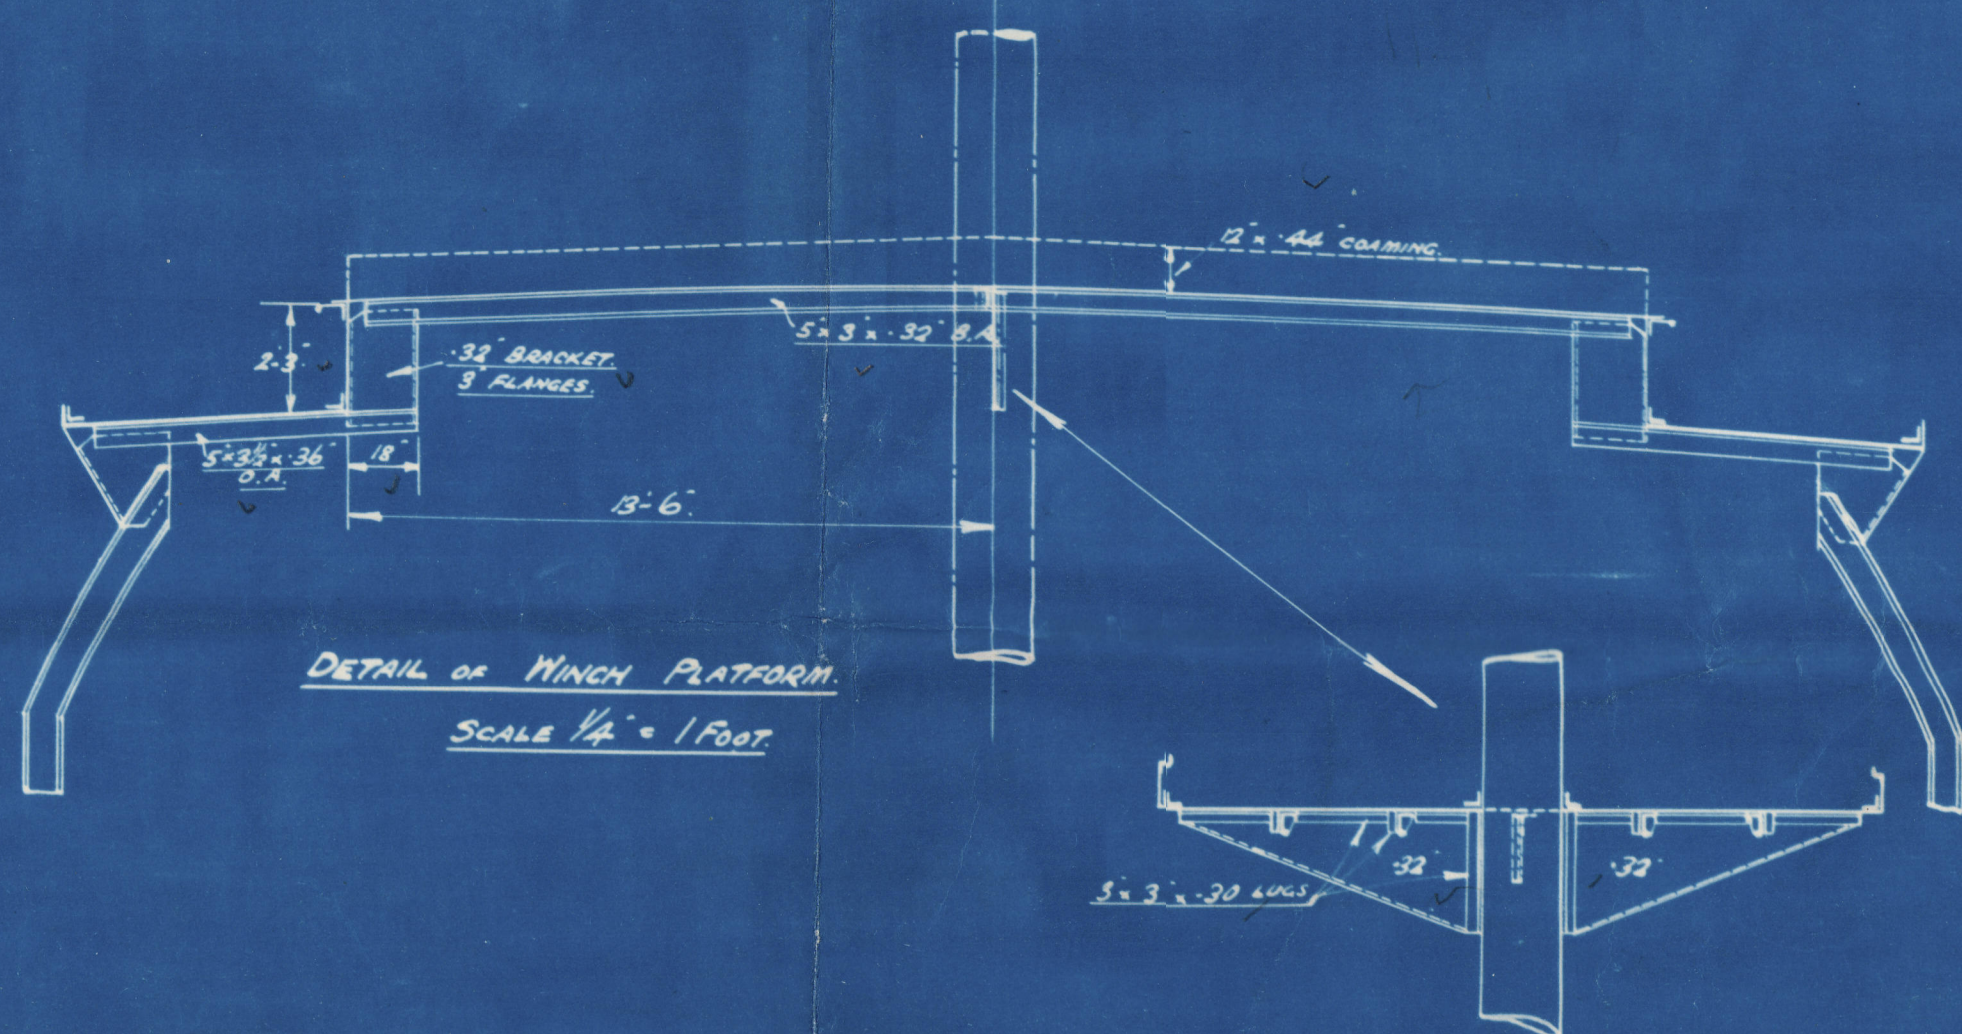

APPROVED
LOYD'S REGISTER OF SHIPPING
19-1-23

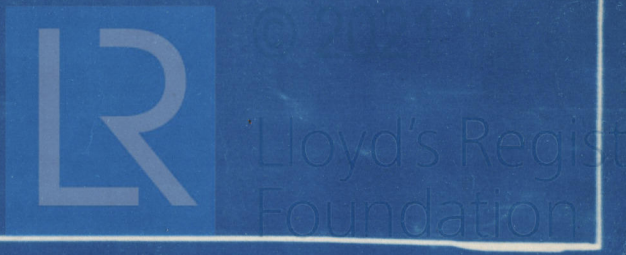

W538-0498


U.S. 123.


Amended Profile.

"Sheep Brook"

Lth 16515

RETAIN

WS38-042928

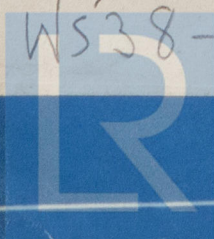

Ed. 1
Foundation