

SUNDERLAND

THE WEAR SHIPYARD

PROFILE & DECK PLAN  
(AS BUILT)

S.S. "NALGORA"

No. 946

SUNDERLAND RPT. NO. 28377





© 2019

Lloyd's Register  
Foundation

W54-0024

# PROFILE

PLAN AND SECTION  
SCALE: 1/8" = 1'-0"

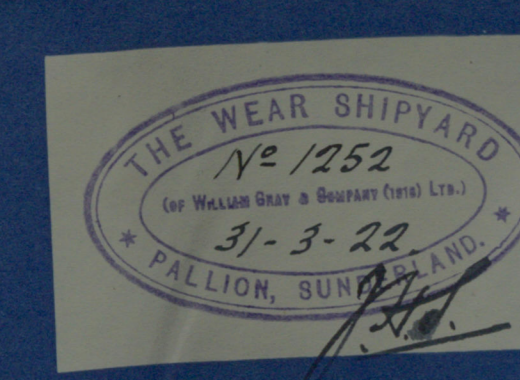 

W54-0021

