

MIDSHIP SECTION.

S.S. No 506 - 525'62"6" x 44'6" x 7'8"

SCALE 1/2" = 1'00"


NUMERALS

8+0.625+43.75-8 = 28.25
 2(8+0.625+98.25 = 201.50
 2.815 BR 1275 ER 15 ROD 120.215 RT
 EQUIPMENT: 51.581+31.50+17.73+13.88 = 205.69

TO CLASS AT LLOYD'S 100 A1.

SHELTER DECK.

DEPTH TO LENGTH BRIDGE DECK: 12.00
 " " " SHELTER DECK: 12.00
 BREASTING TO LENGTH: 8.40

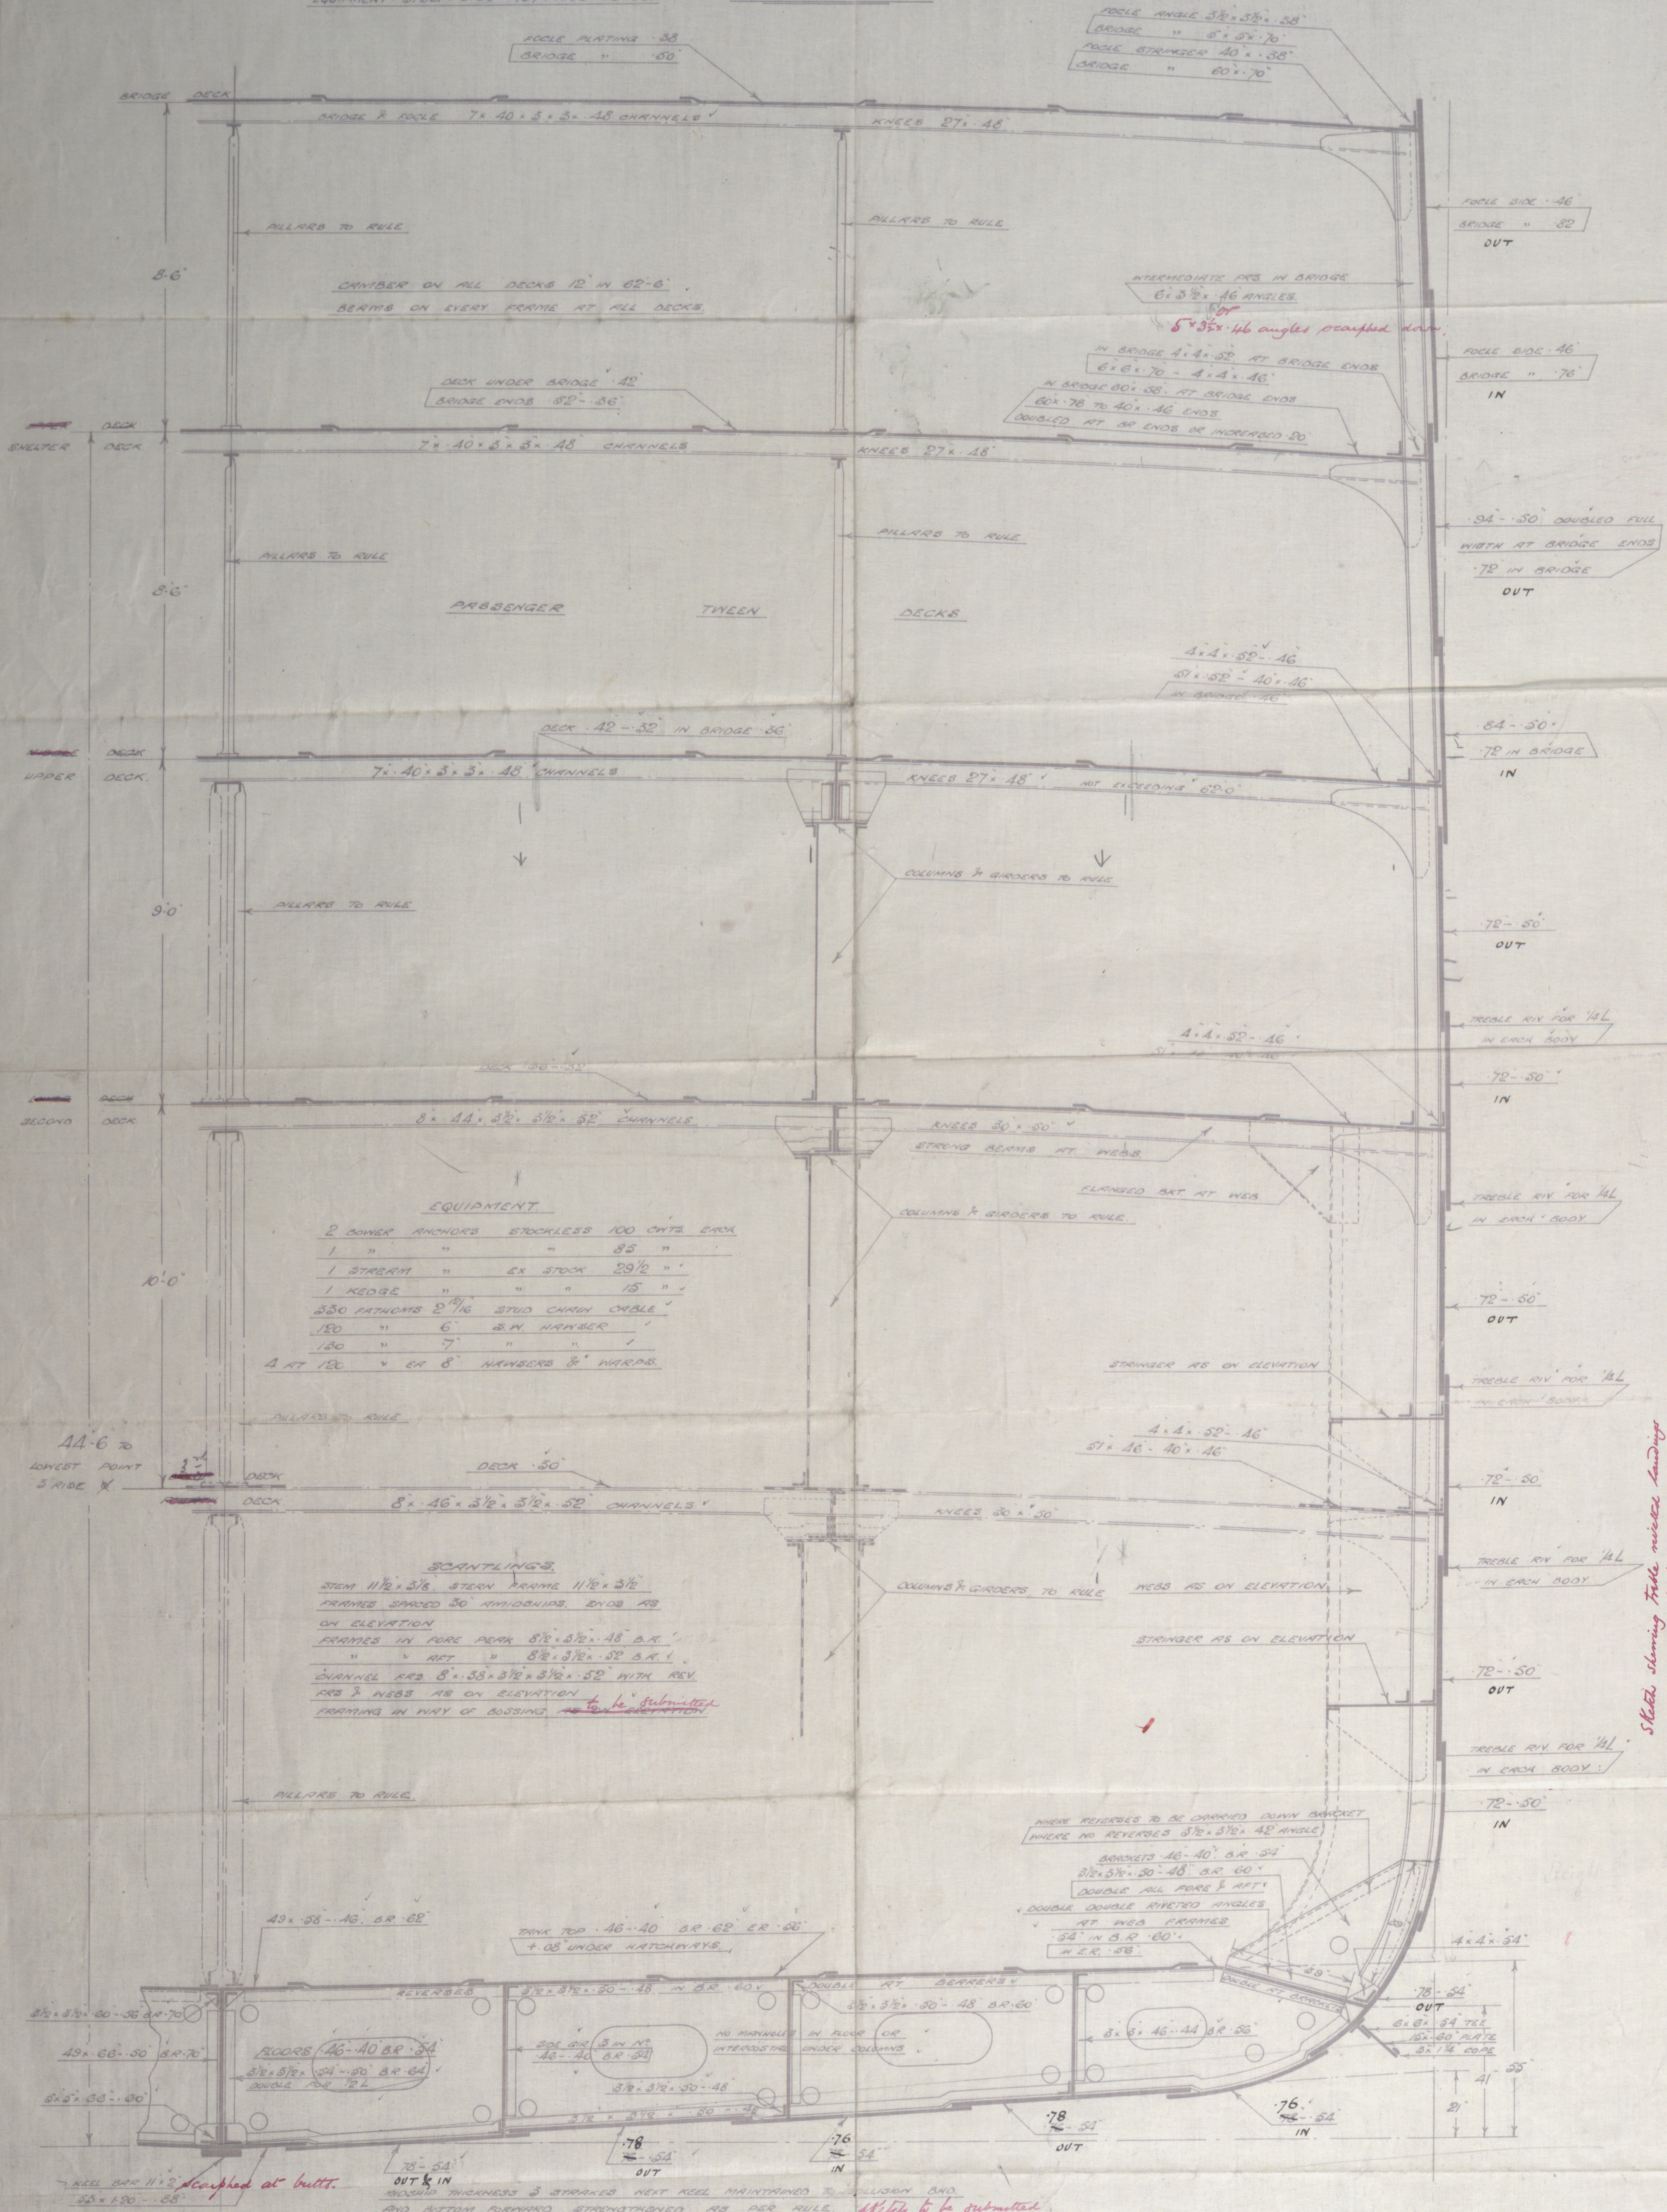

Sketch showing full water loading to be submitted




Harland & Wolff Ltd.

Nº 506.

Midship Section. Amended.


S/O Croya
Del 8892

RECEIVED
JAN 15 1917
No.

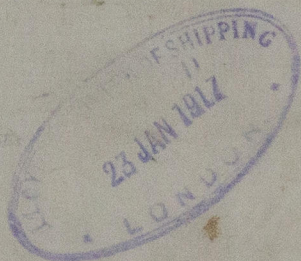

RETAIN

W540-0182

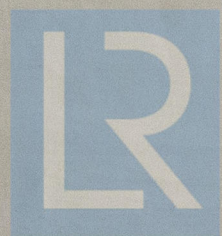

© 2019

Lloyd's Register
Foundation