
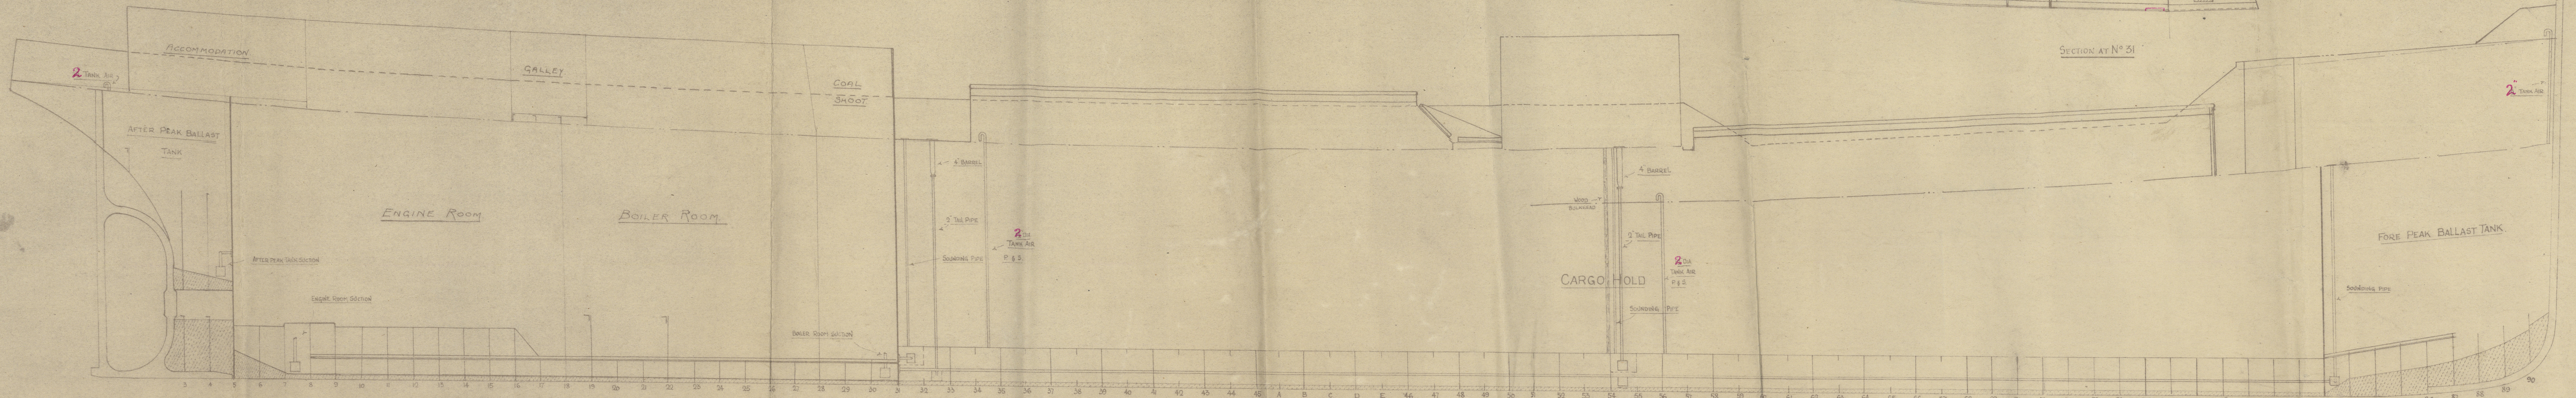


N° 502


PUMPING PLAN

SCALE: 1" = ONE FOOT.

20/12/19

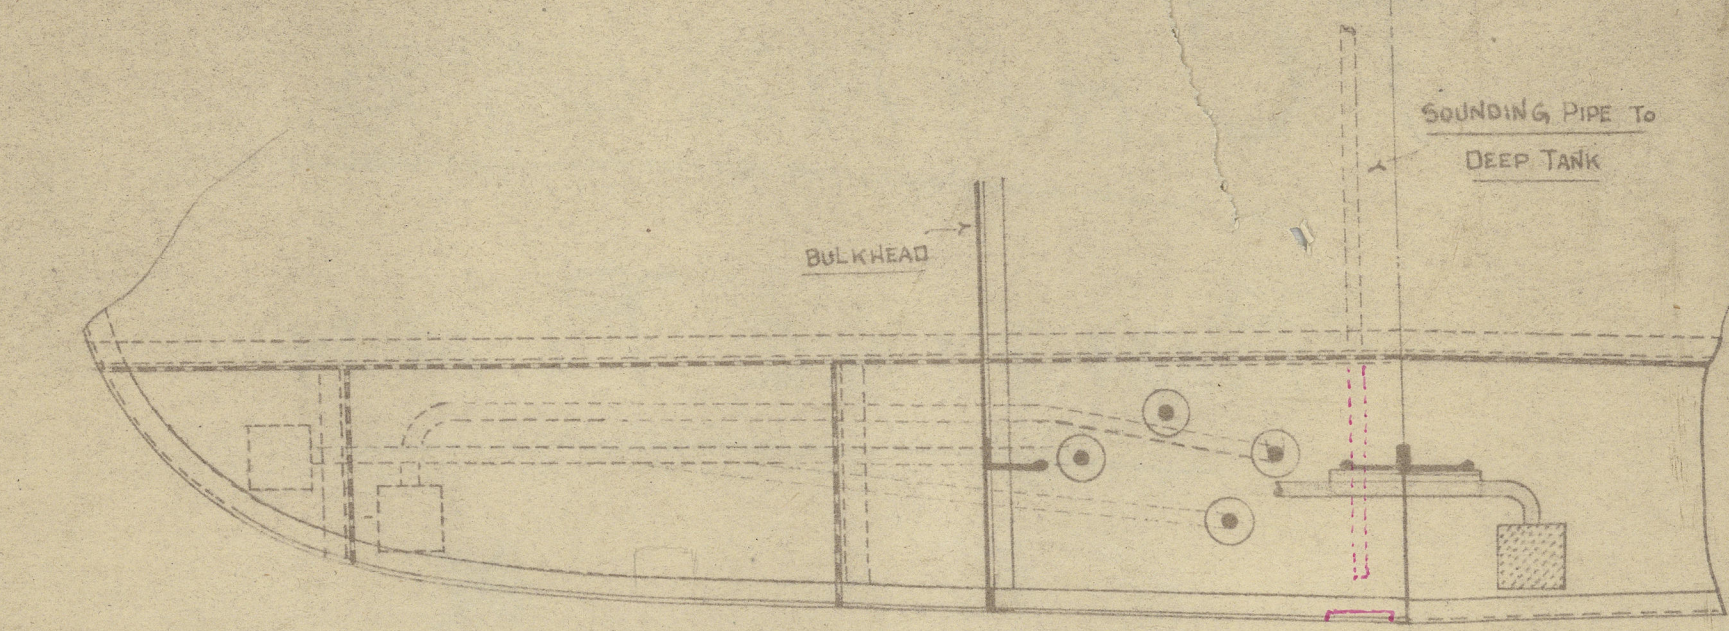

SUCKING PIPES THROUGHOUT TO BE OF CAST IRON WITH LEAD BENDS
AND THOSE IN WAY OF BALLAST TANK TO BE RUN THRO' MANHOLE IN
FLOOR

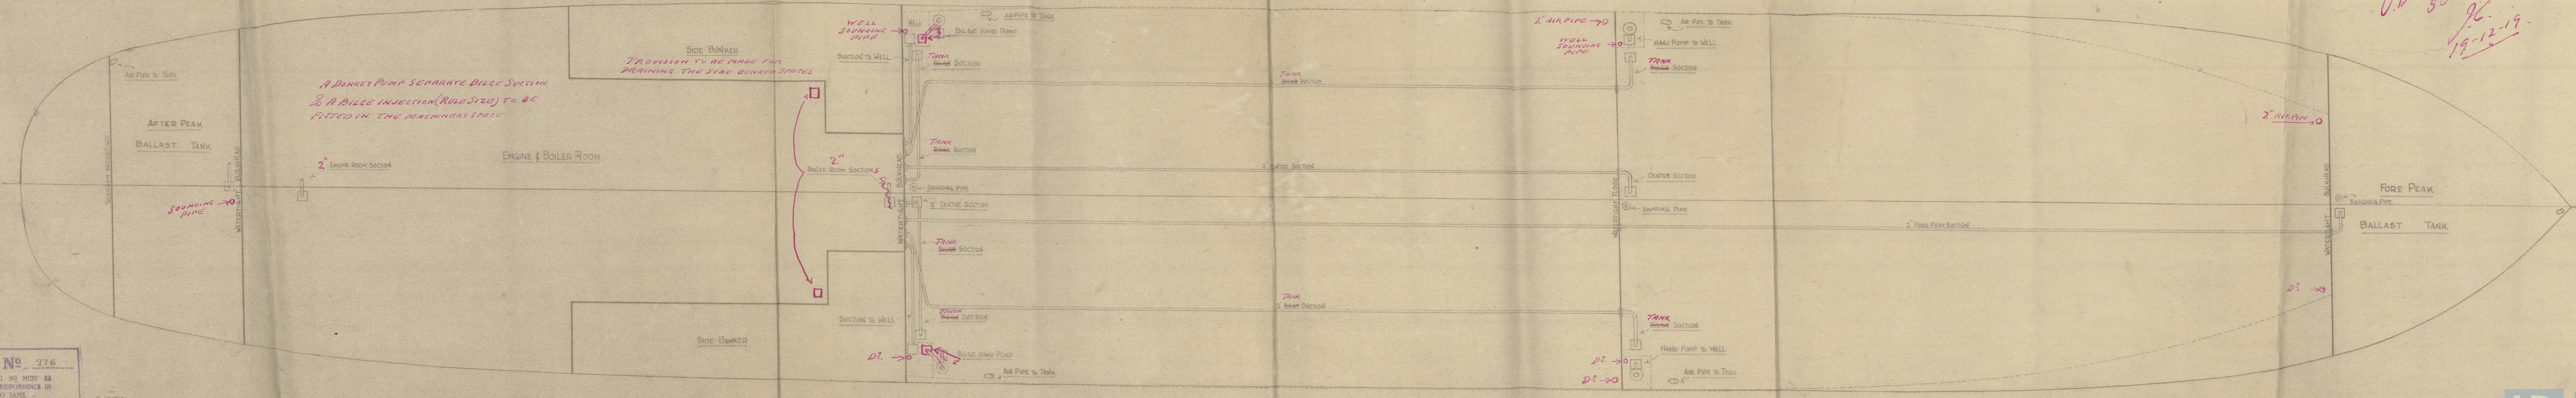

J C HAMBERS

PUMPING PLAN

S.S. 502-X

Lon. Rpt. No. 84041

S.S. "Emlynton"

Wreck Box 122

done up by H. A. S. J.
S. C. Thompson

W 542-0028



© 2020

Lloyd's Register
Foundation