

Mat. steel.

| | | |
|------------------------|--------------------------|---------|
| 43.5 | 56'-5" | 16500 ✓ |
| R.O.D. | 56'-5" 14'-0" | 744 ✓ |
| Top castle | 20'-5" x 8'-0" 14' | 724 ✓ |
| Bridge B-B | 20' x 1 3/4' 14' | 83 ✓ |
| Engine and boiler room | 45'-0" x 8'-0" x 12' | 196 ✓ |
| Engine number | | 12669 |
| | | 17607 |

Constr: of double bottom at alternate frame

Jun
9. 6. 18

North

Midship Section

RETAIN



W 542-0055

© 2020

Lloyd's Register
Foundation

130

Locher & Stams

Midship book



S.S. Maria

Nord

Rotterdam report

No - 10134

Plan of midship book

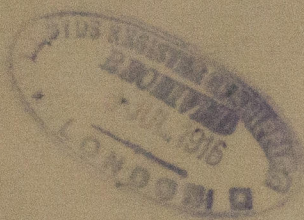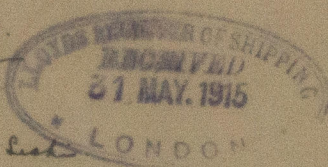

W542-0055



© 2020

Lloyd's Register
Foundation