


LOYD'S 3 DK. RULE.





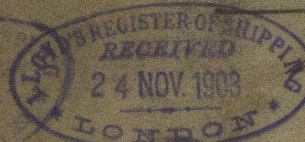


Fairfield Ship C^o



P.O. No 424




Profile (amended)

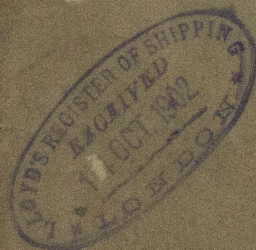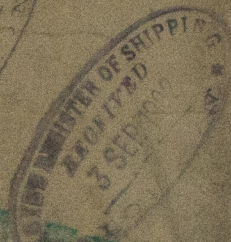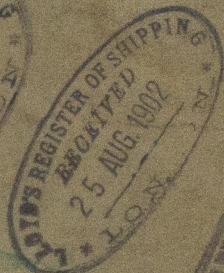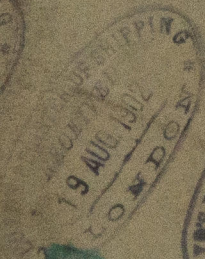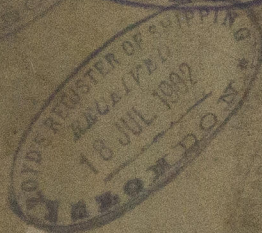

GLASGOW REPORT No 39115

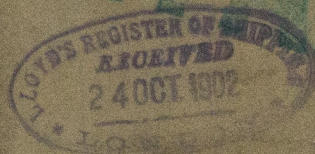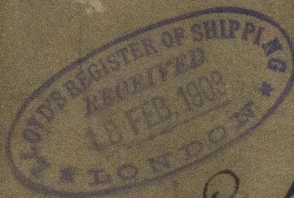

See Profile as built for
correct position of bulkhead
with frames etc.

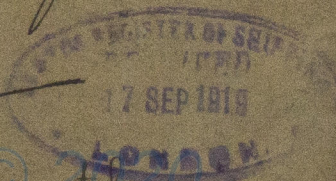

Armada Castle

Sh. H. 31318's Register
542-0136