

T.S.S. N^o 424.

MAIN AND UPPER DECK.

SCALE: $\frac{1}{8}$ " & $\frac{1}{2}$ " - ONE FOOT.

PROMENADE DECK.


UPPER DECK.

7'6" x 12'0" FRAME.


MAIN DECK.

SKETCH OF PARTIAL BHDS. BFT. MAIN & UPPER DECK.

SCALE $\frac{1}{2}$ " = 1 FOOT.

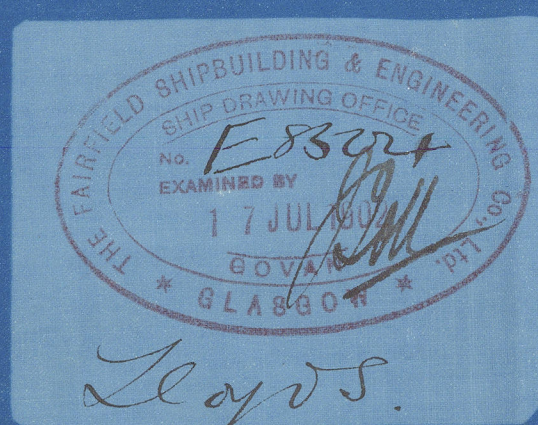


UPPER DECK PLAN.

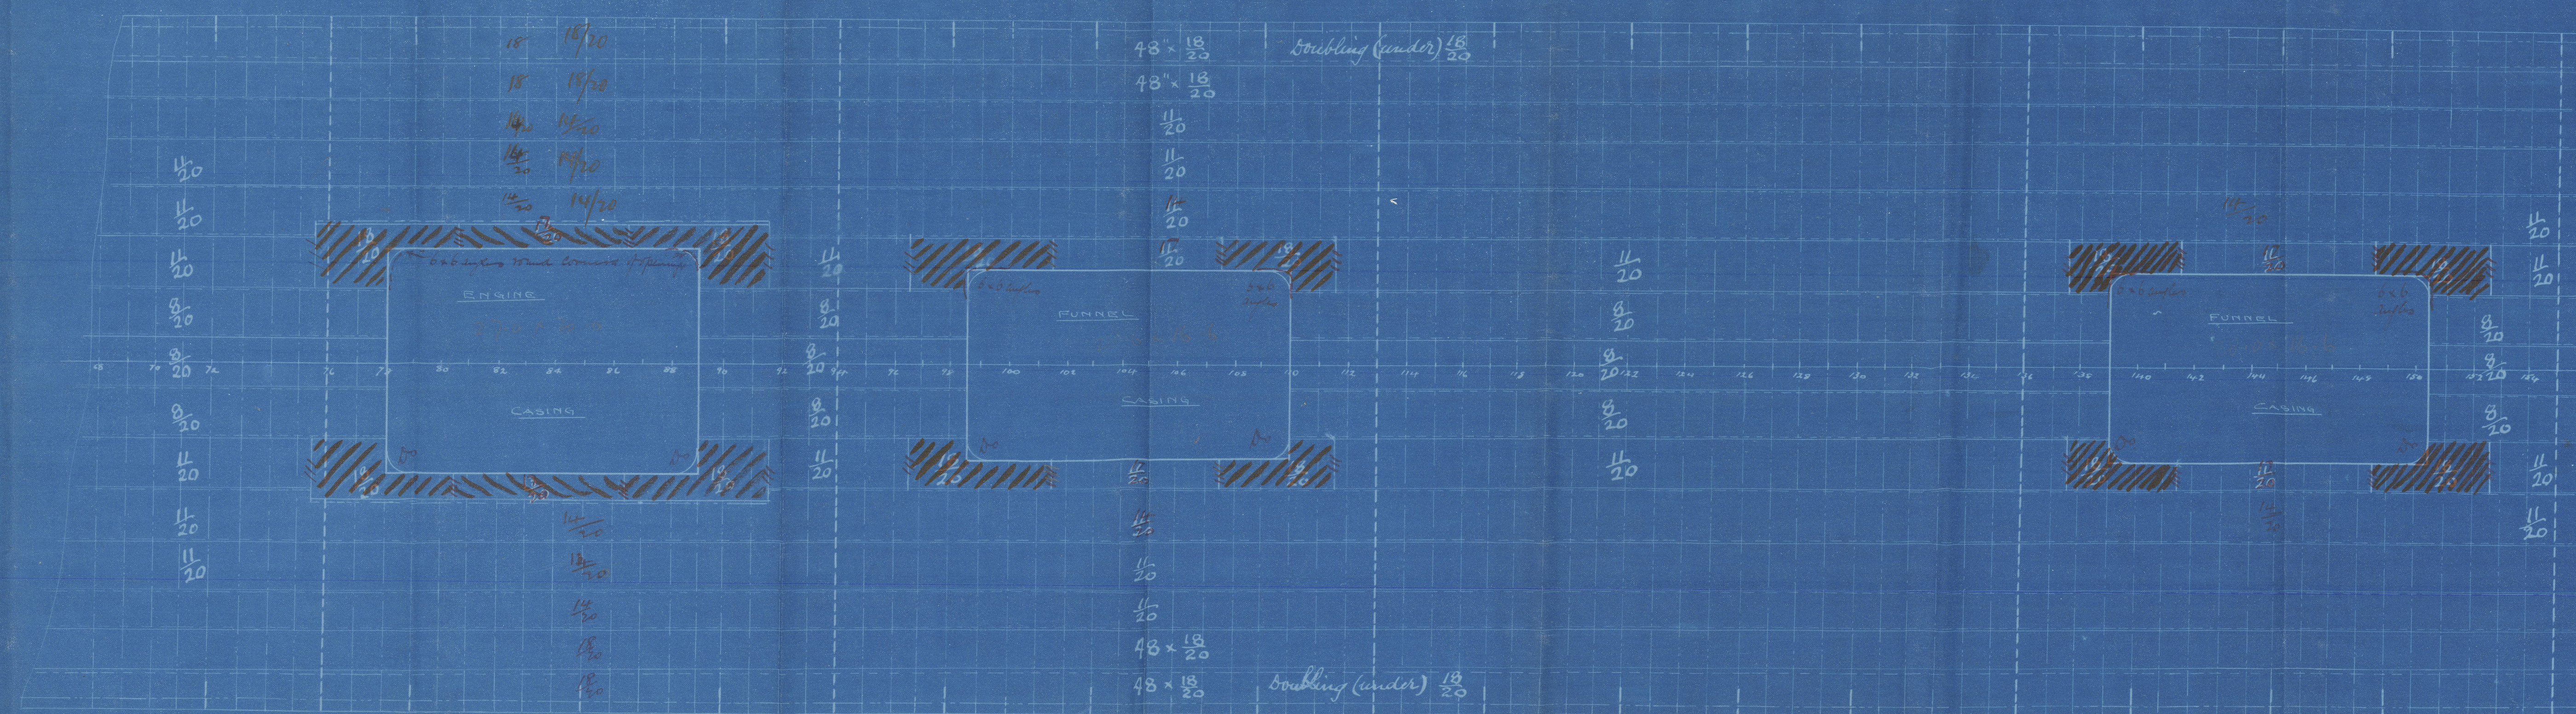




Note - Parts tinted are increased in thickness

MAIN DECK PLAN.

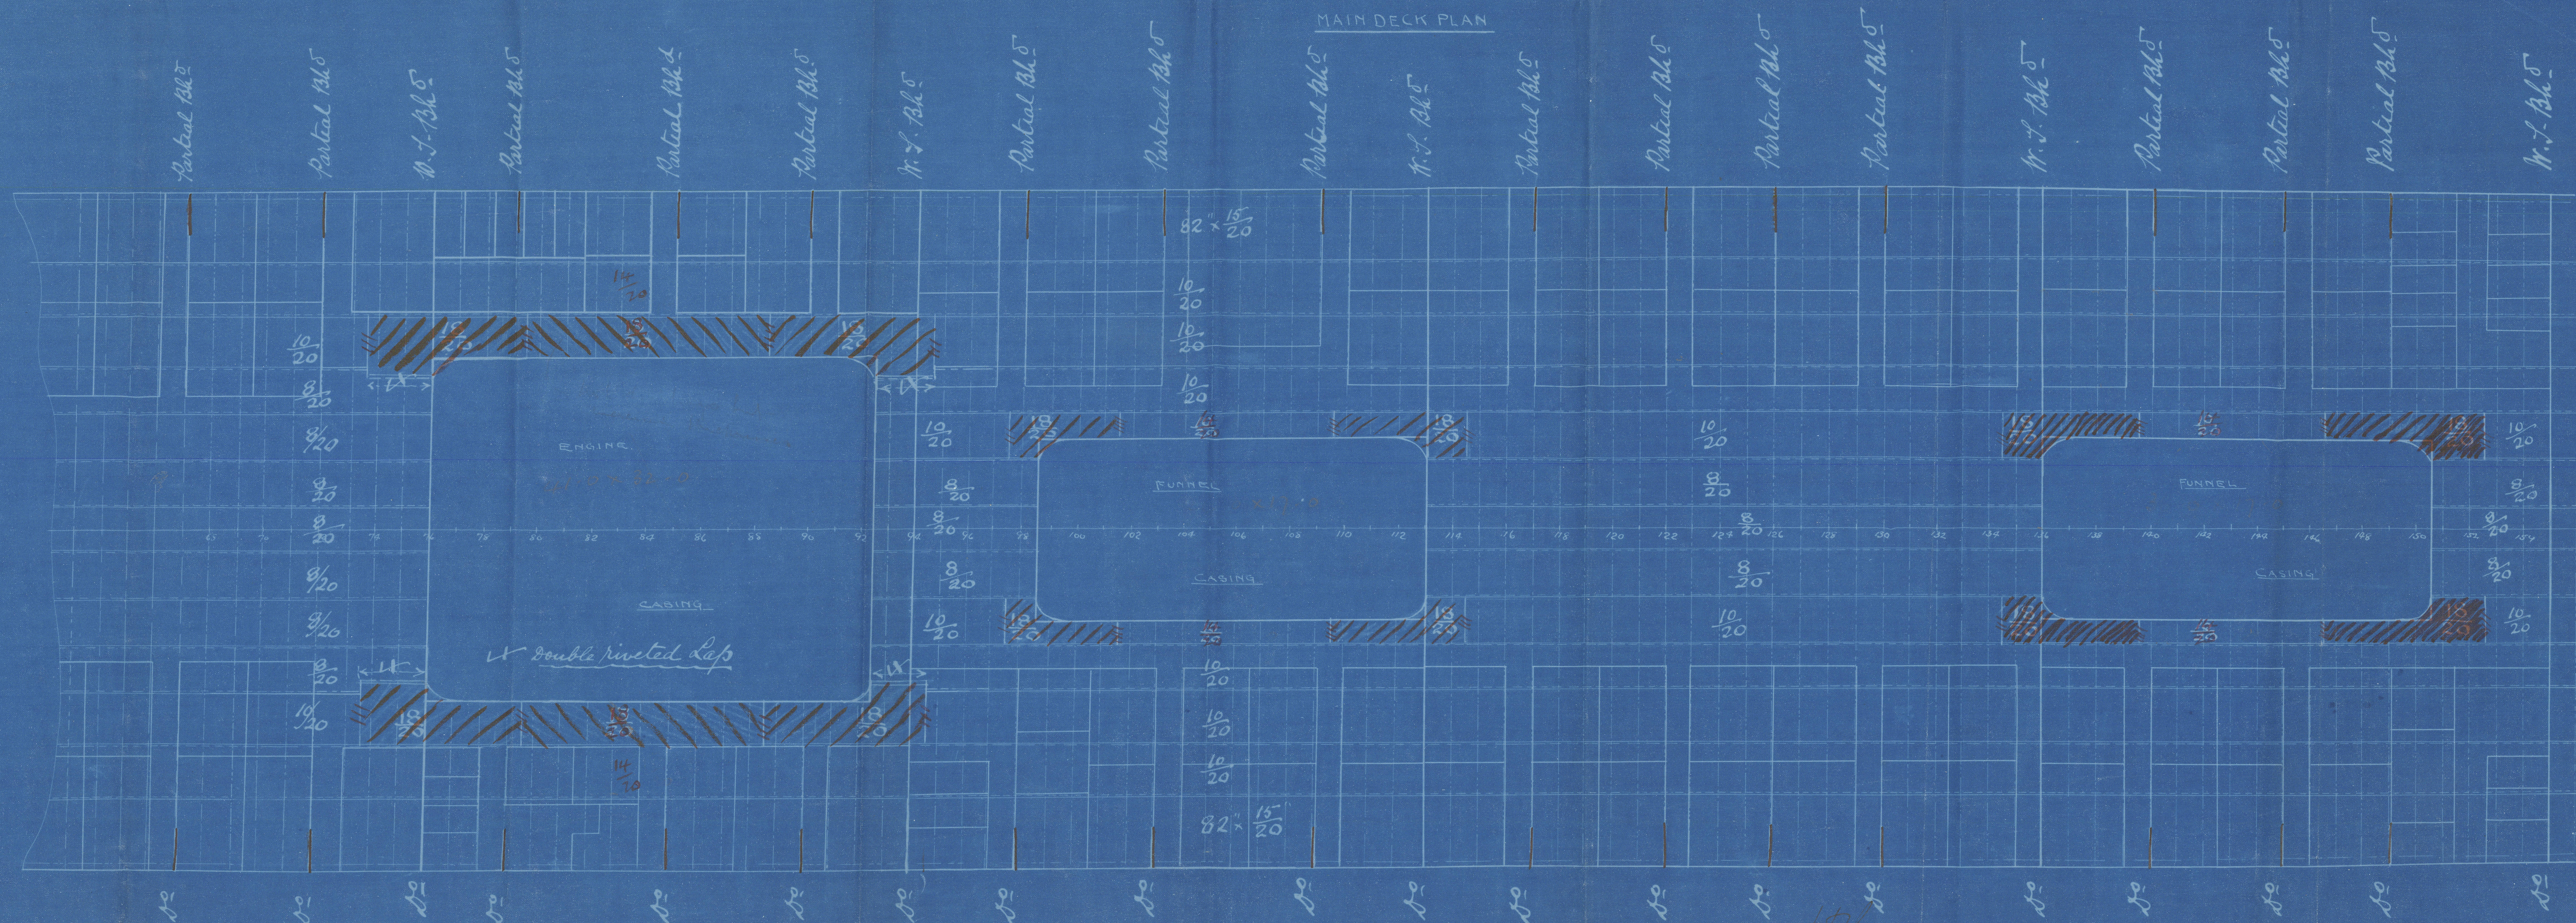


Fairfield Bros
h:424

main & upper decks
in E & B. space.

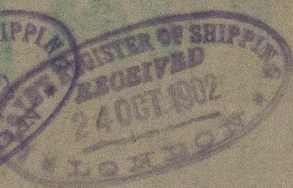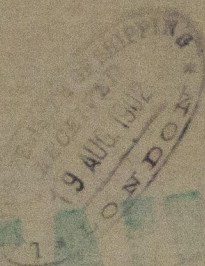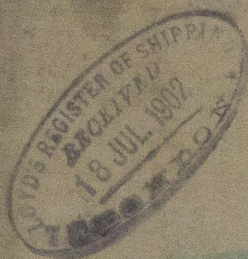

Armada Castle
Shipt. No. 21318

GLASGOW REPORT No. 39115.

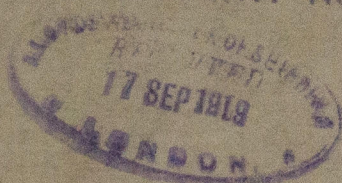

© 2020

Lloyd's Register
Foundation

W542-0137