

"SHERWOOD SYSTEM" (PATENT)

SECTION IN ENGINE & BOILER SPACE



EQUIPMENT № 22488.

C. R. Jm.  
28.2.13 28.2.13



⊗ x

Osaka Lhks 1/2

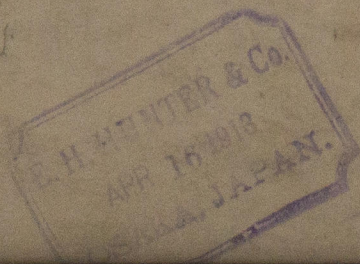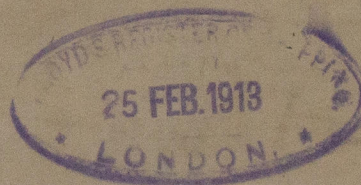

© 2020

Lloyd's Register  
Foundation



Mids hip Section


S.S. Peking Maru.

O. I. Wks No 806

Kobe Report No 1498

RETAIN

WS 43-0198

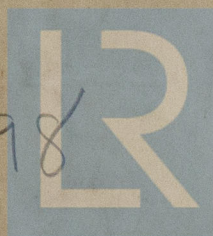

© 2020

Lloyd's Register  
Foundation