


PRINCIPAL DIMENSIONS
 LENGTH B.P. 395.0
 BREADTH EXT 50.0
 " MLD 49.8 1/2
 DEPTH MLD (SPAR DECK) 29.3

S.S. N° 437.

SCALE 1/2" = ONE FOOT.

POOP DECK 5/16
 BRIDGE " 6/16
 FOLE " WOOD

NUMERALS:-		ASSUMING 8.0 TWEEN DECKS	NUMERALS TO SPAR DECK LESS 7.0
HALF BREADTH M-F	24.85		24.85
HALF GIRTH	42.80		50.80
DEPTH AS PER RULE	22.25		30.25
	89.90 FRAME N°		105.90
LENGTH AS PER RULE	393		LESS 7.00
	35330.70 PLATING N°		98.90
			393
			38867.70

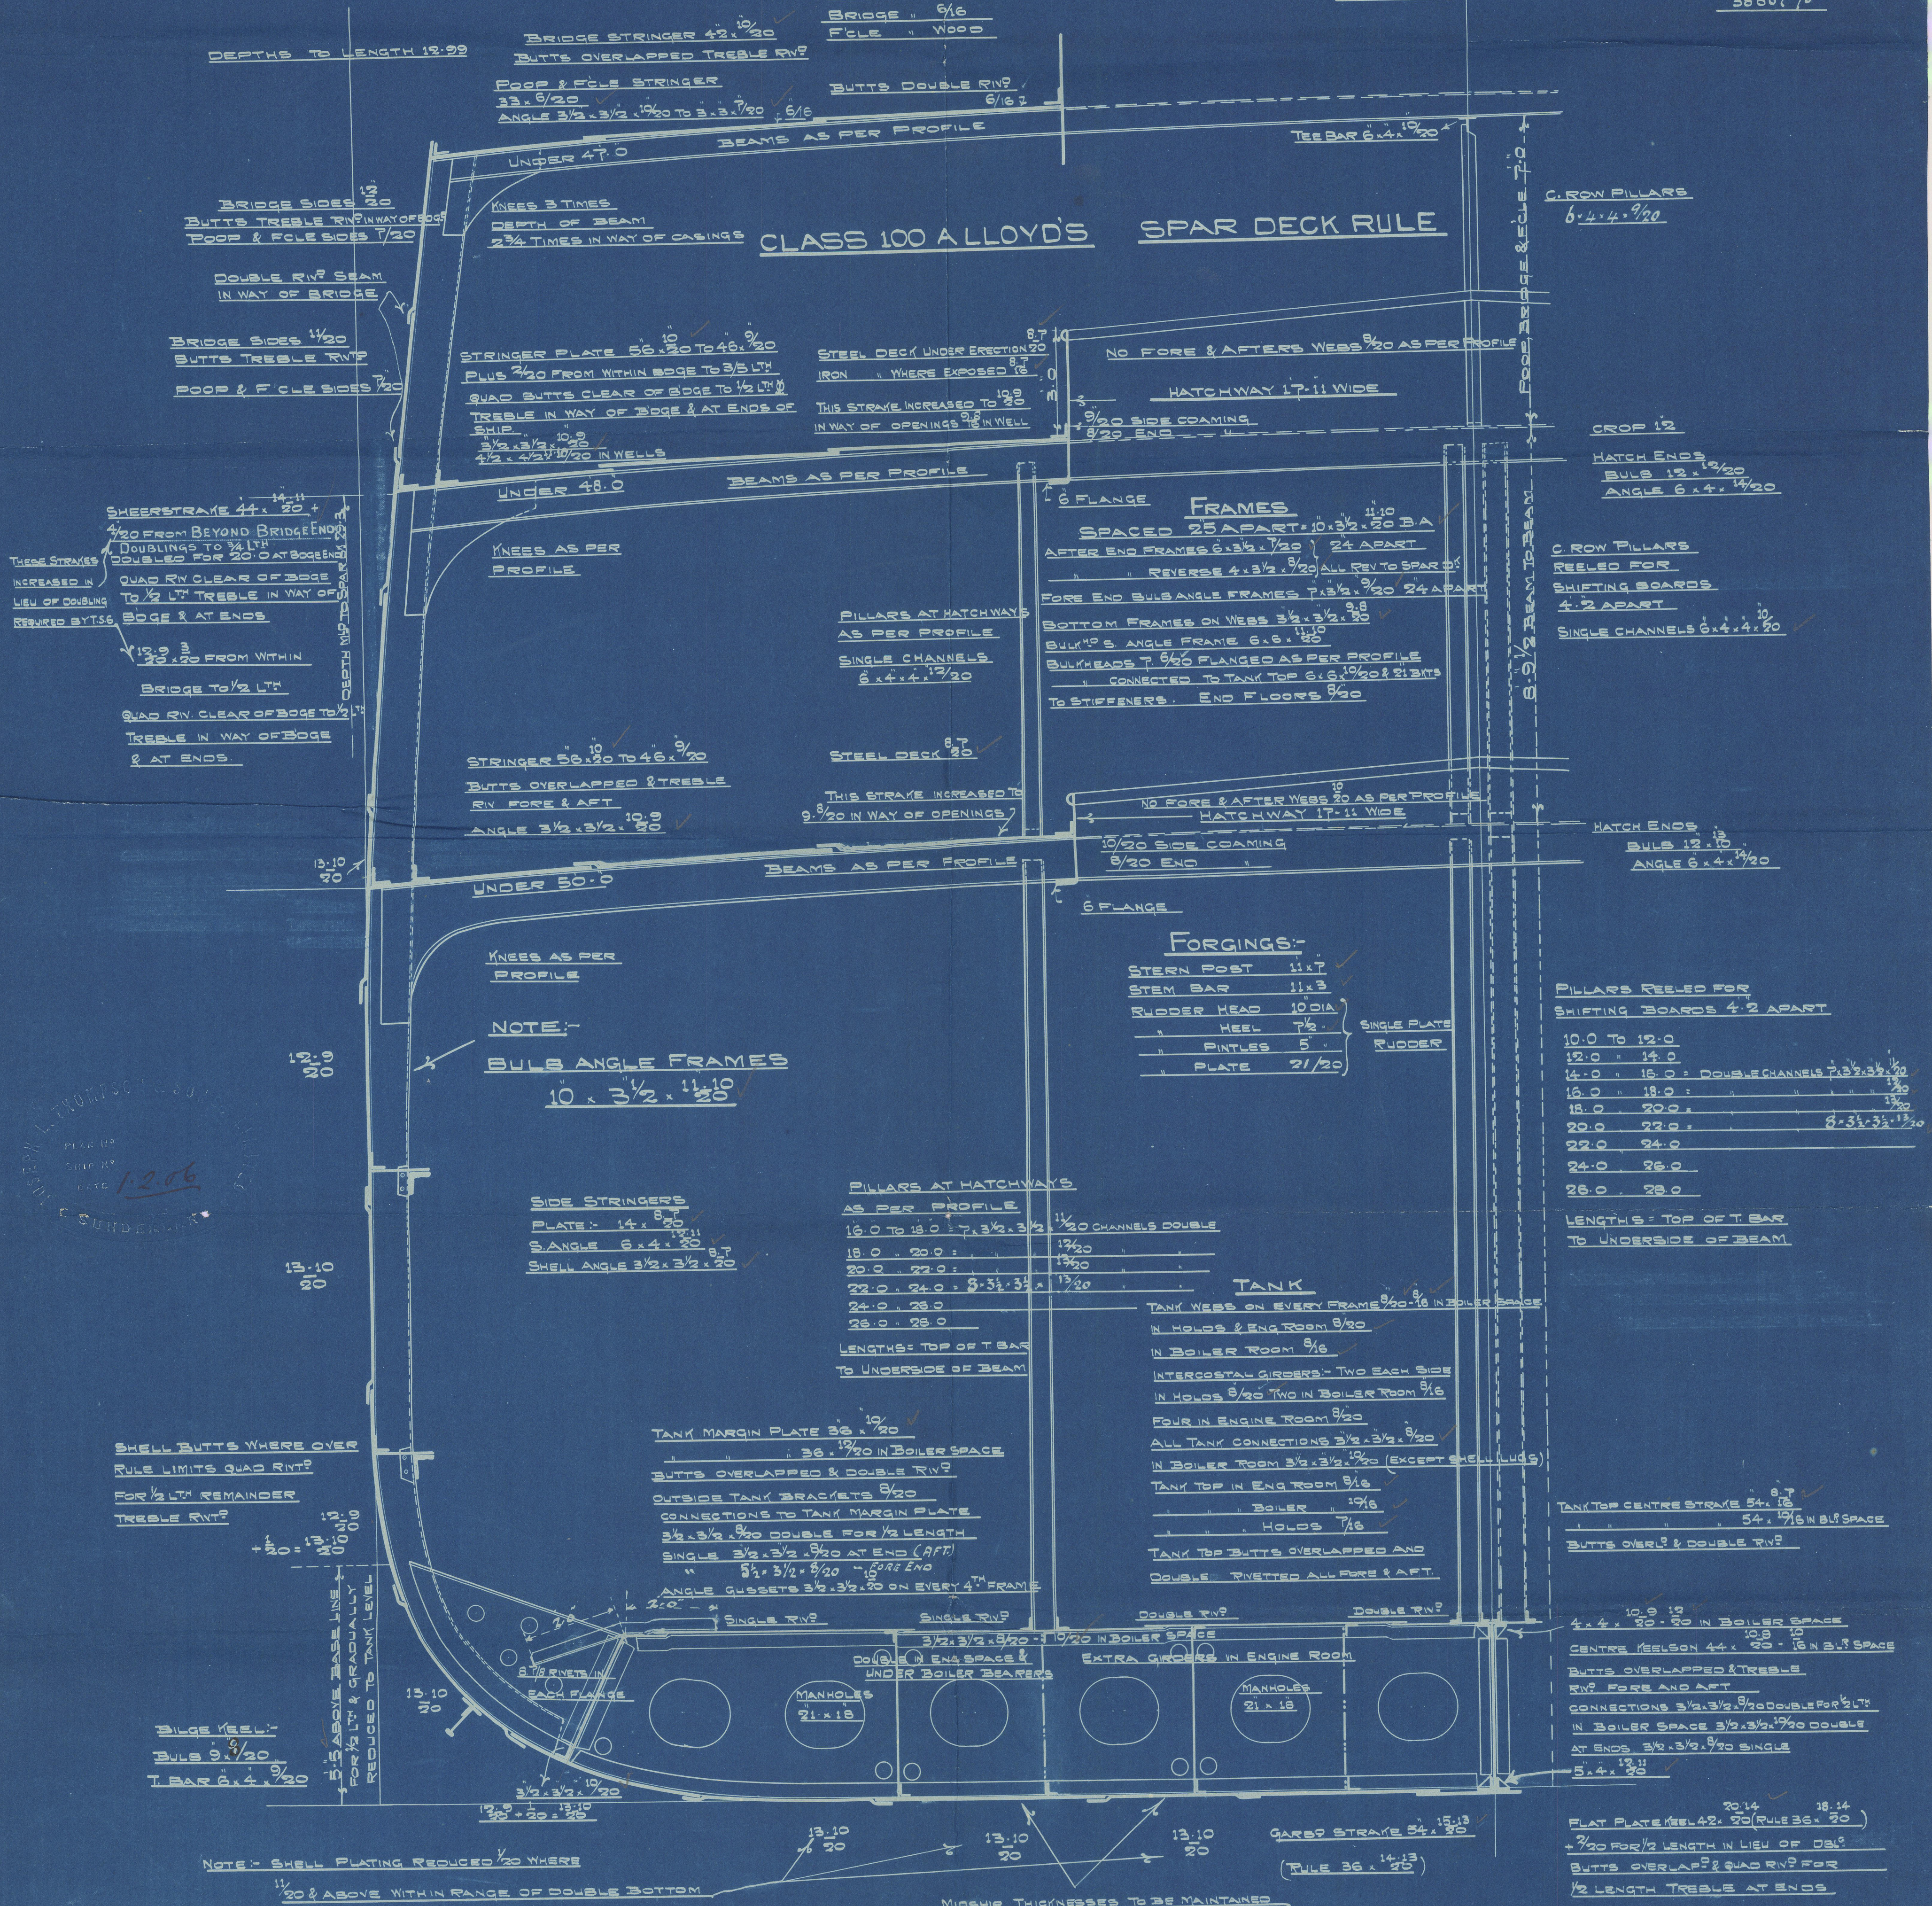


PLAN NO. 1206
 DATE 12/06
 SUNDERS

Messrs J. L. Thompson & Son
No. 437

Trading Section (as built)

S.S. "SIAM"

Old. 22604

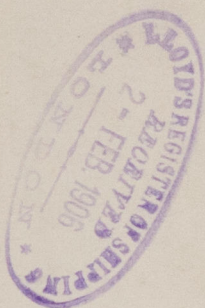

RETAIN



© 2020

Lloyd's Register
Foundation

W545-0190