
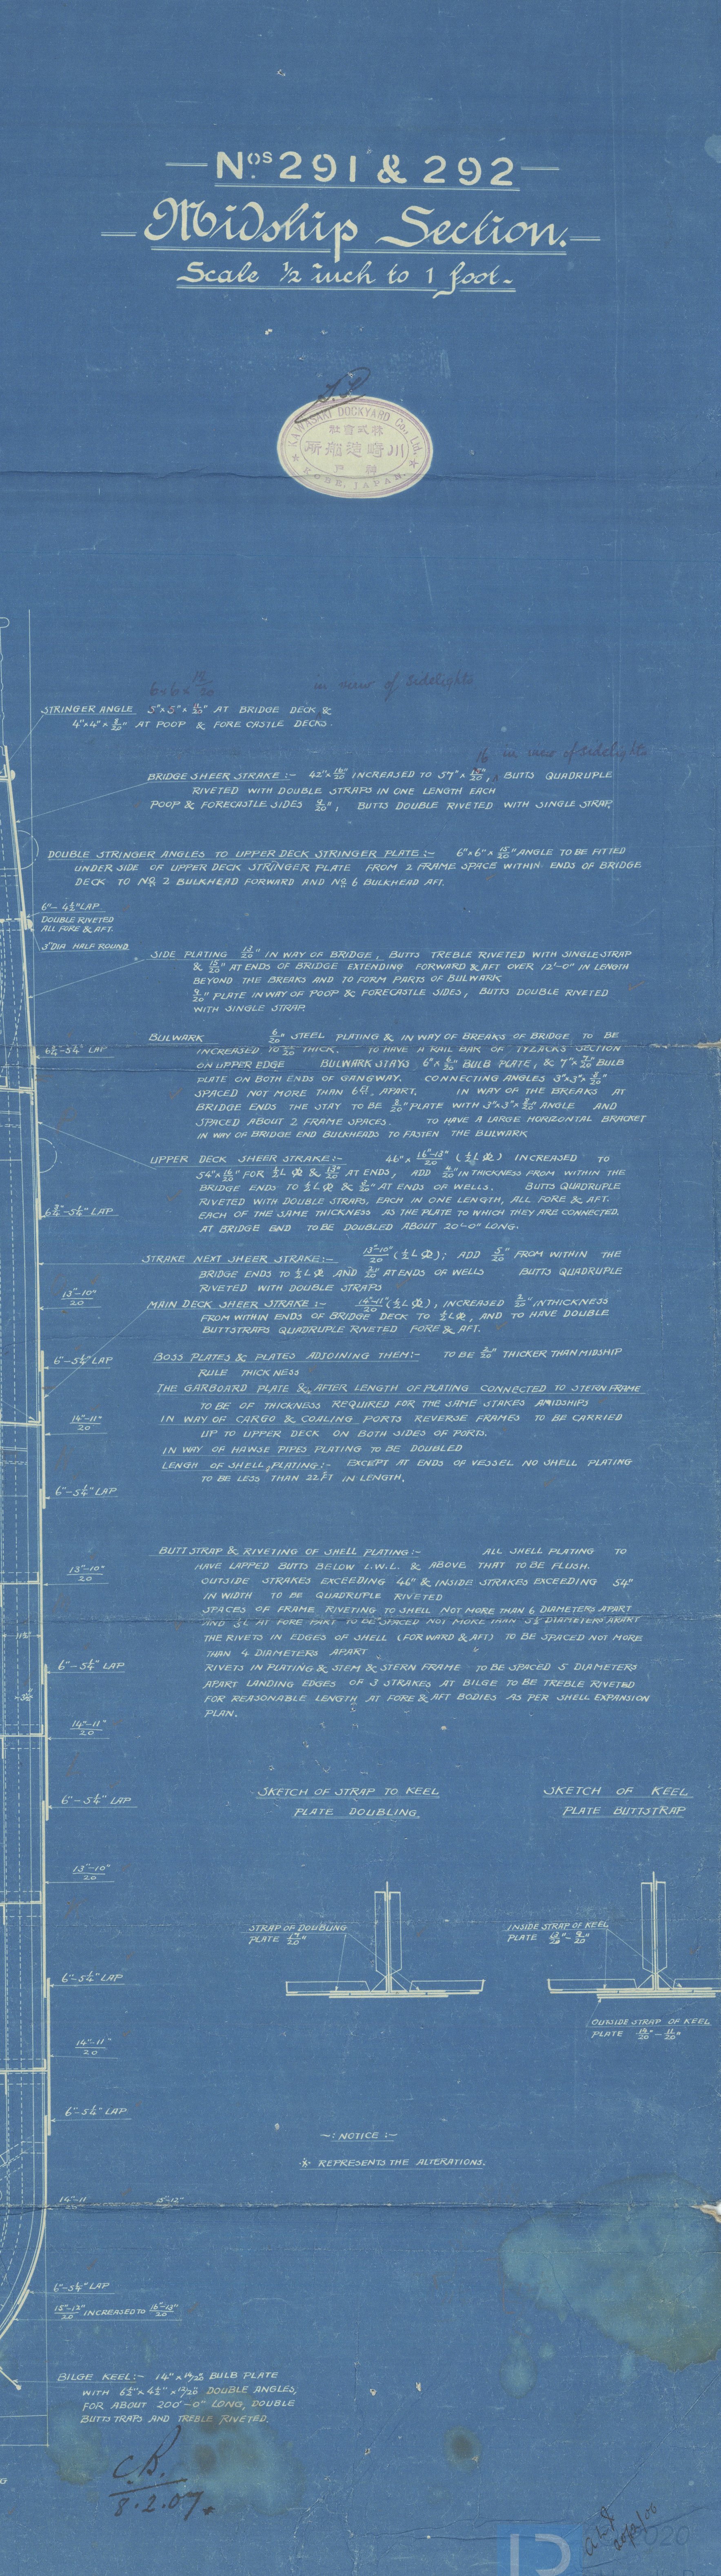


Nos 291 & 292 Bidship Section Scale 1/2 inch to 1 foot.

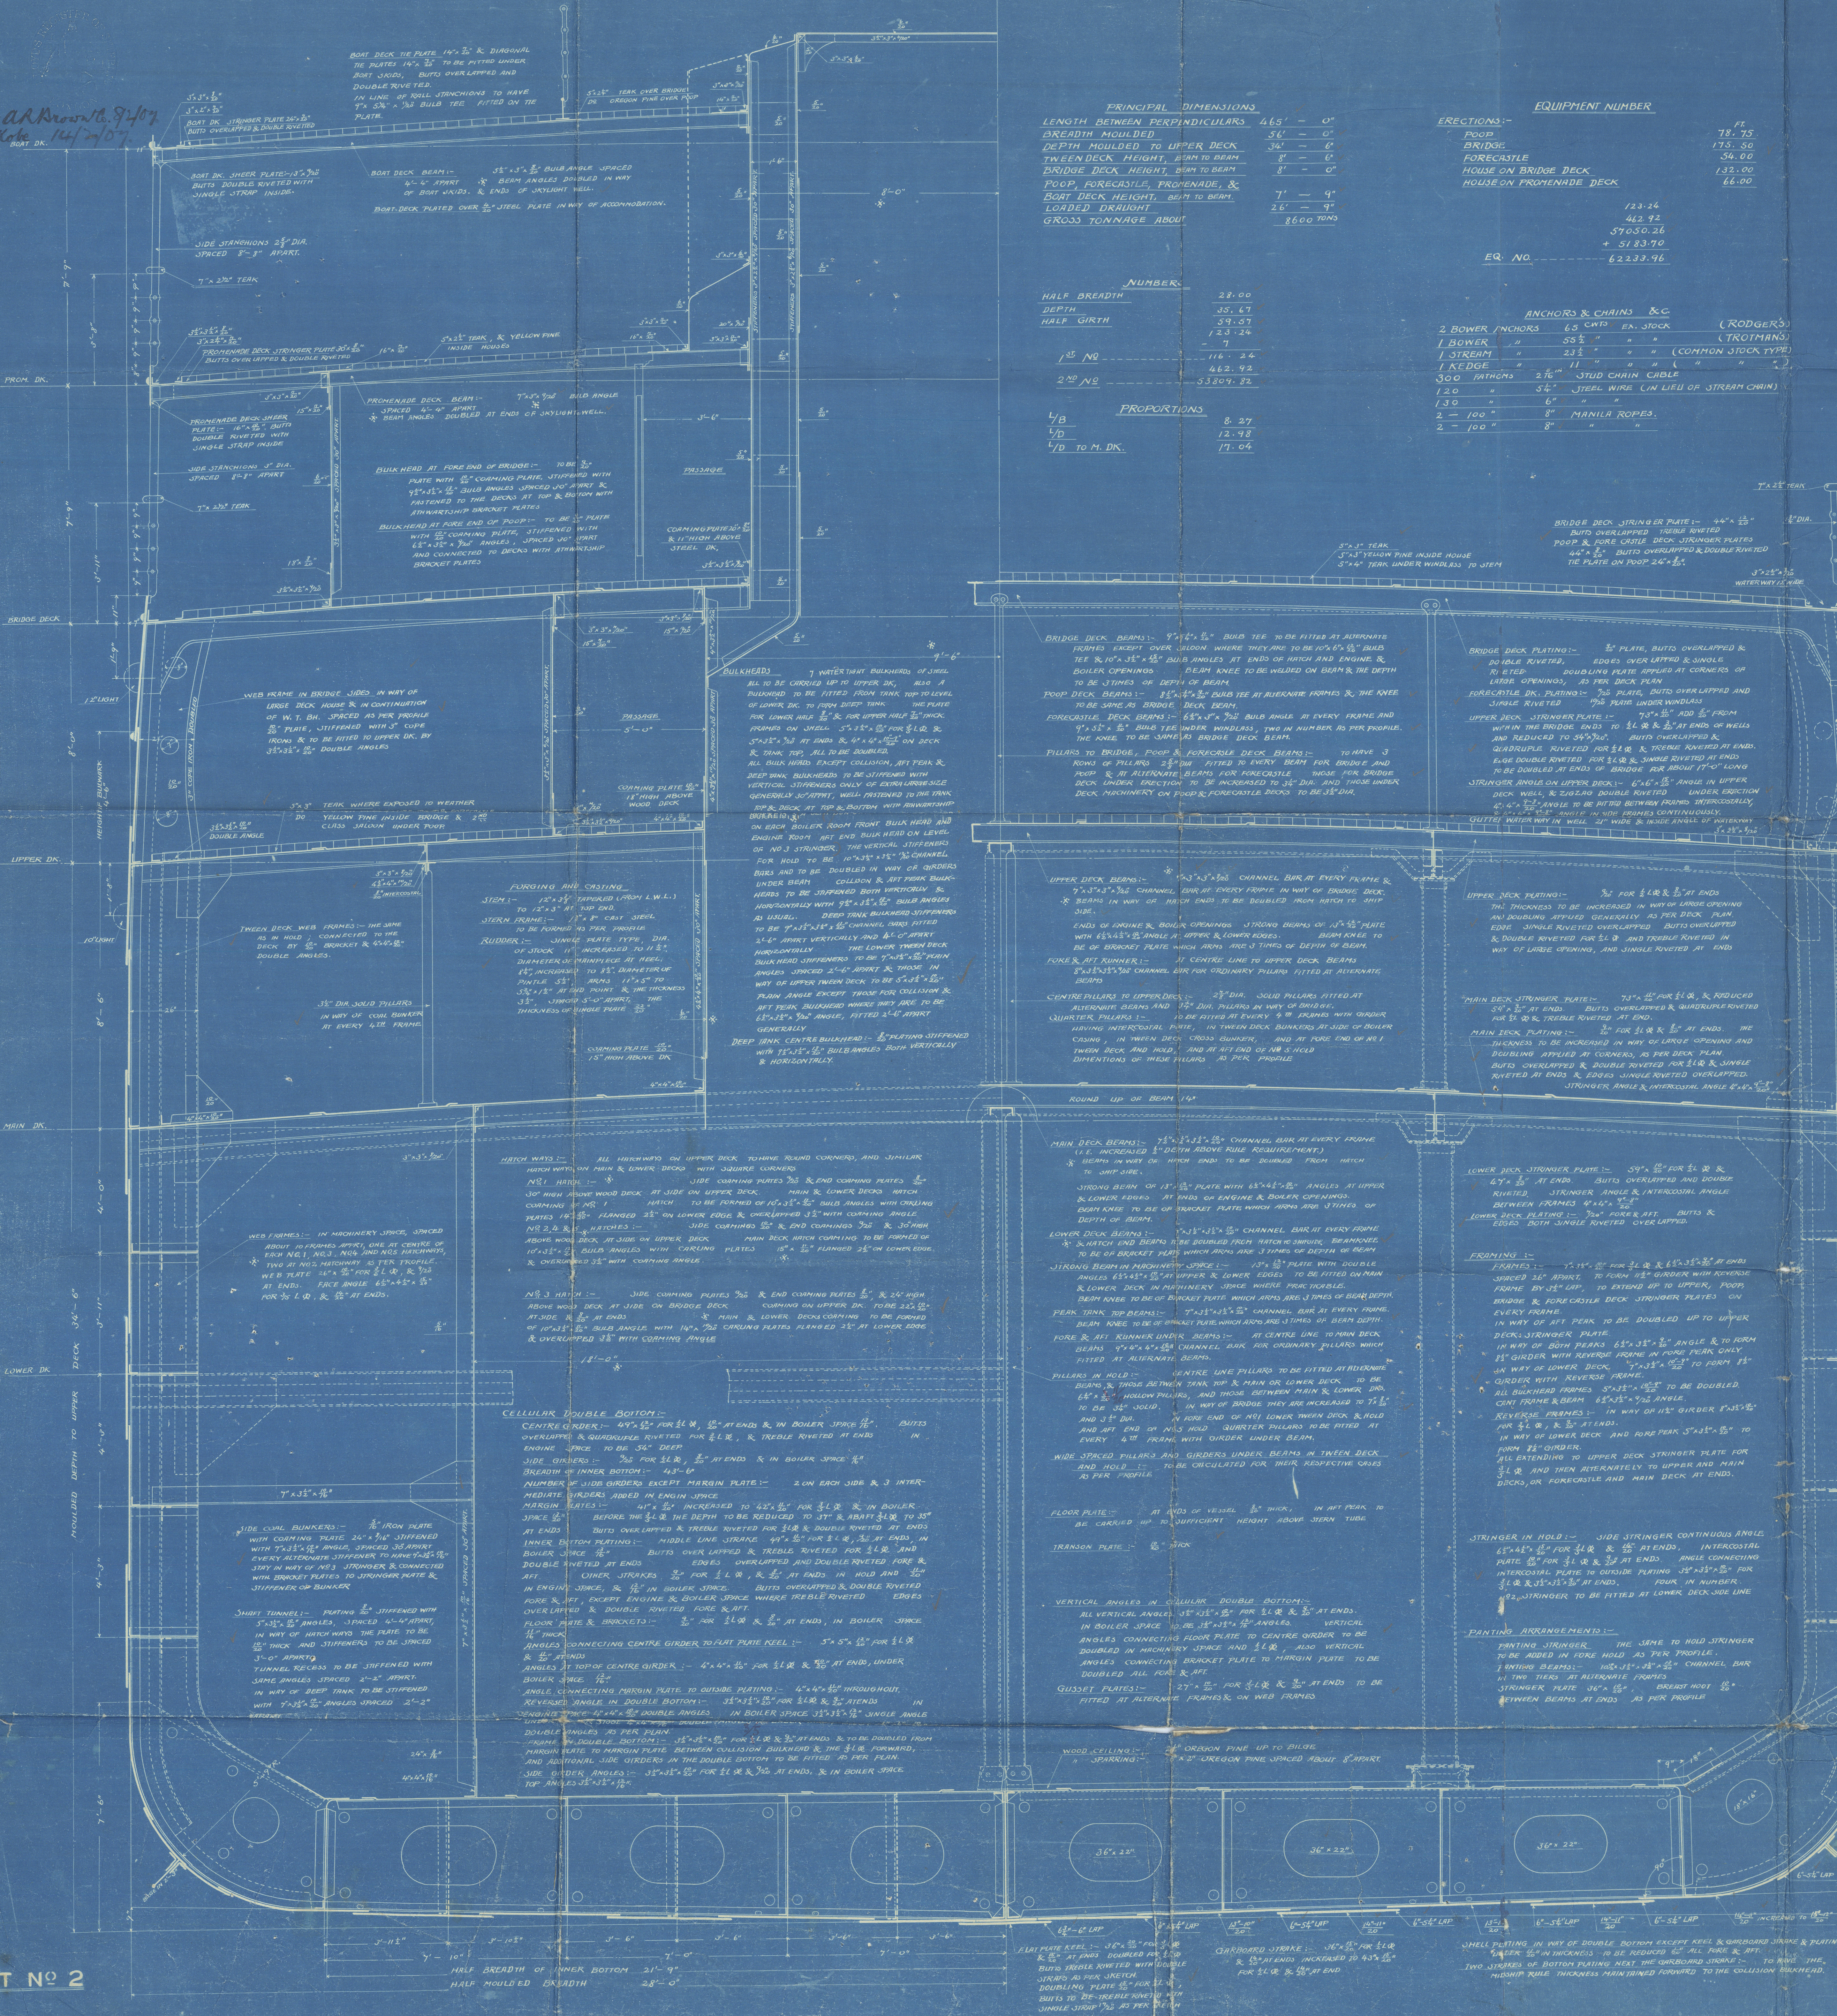

Midship Section


Kawasaki 291 & 2

291 J.S.S. Mishima Maru

Kobe report No 772



Block 88 Top

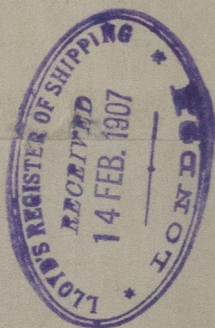

Midship Section

RECEIVED



© 2020

Lloyd's Register

WS Foundation