

WRITTEN DIMENSIONS ONLY TO BE TAKEN.



AMENDED PLAN

W548-0163



© 2021

Lloyd's Register
Foundation

SUNDERLAND.



Messrs. The N. E. Marine Eng. Co.,

Con. 2882.

Messrs. J. P. Austin & Son's

no. 343.

Boiler. (Amended)

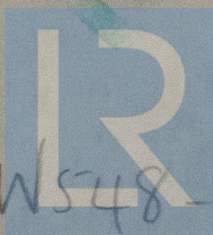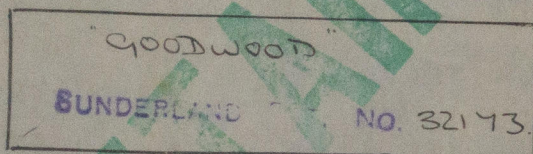

© 2021

Lloyd's Register
Foundation

W548-0463