
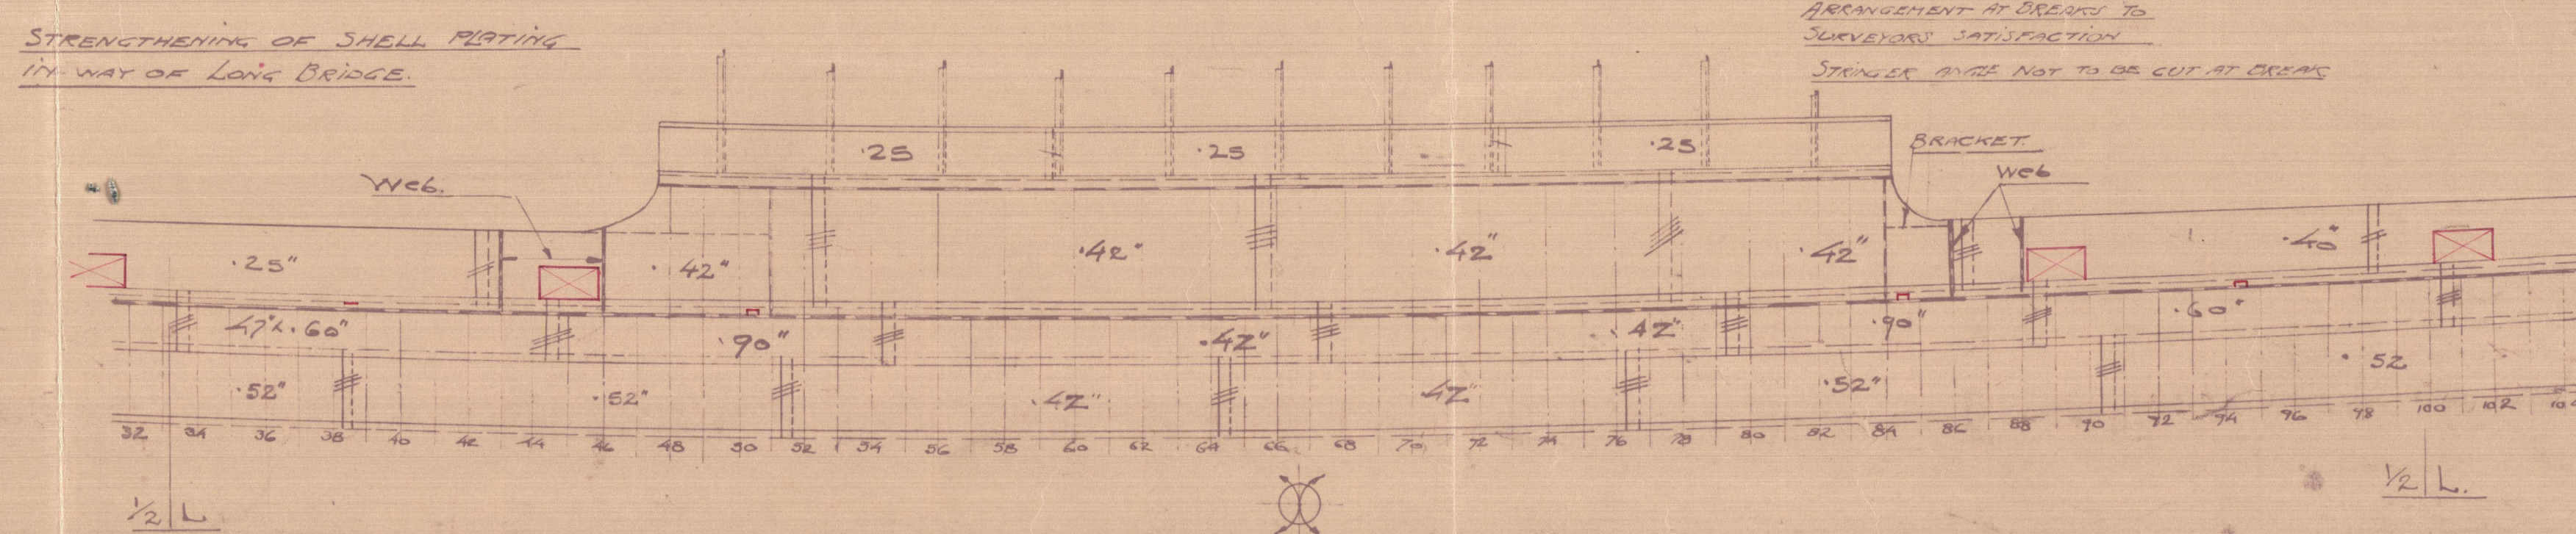
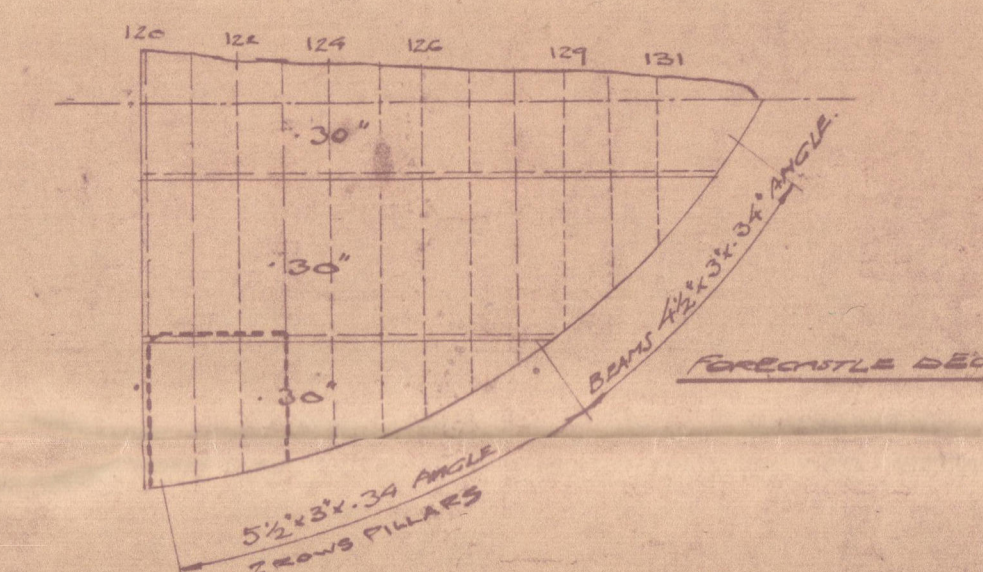
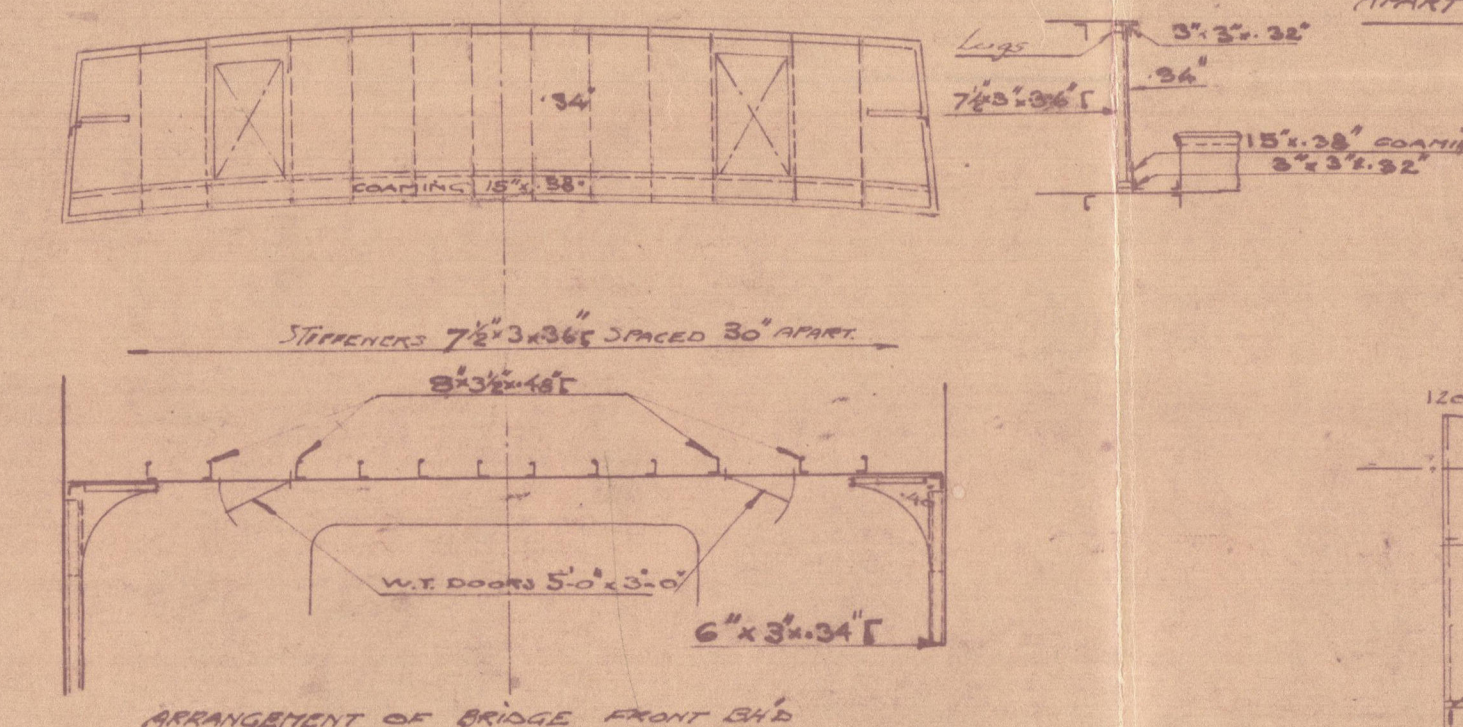
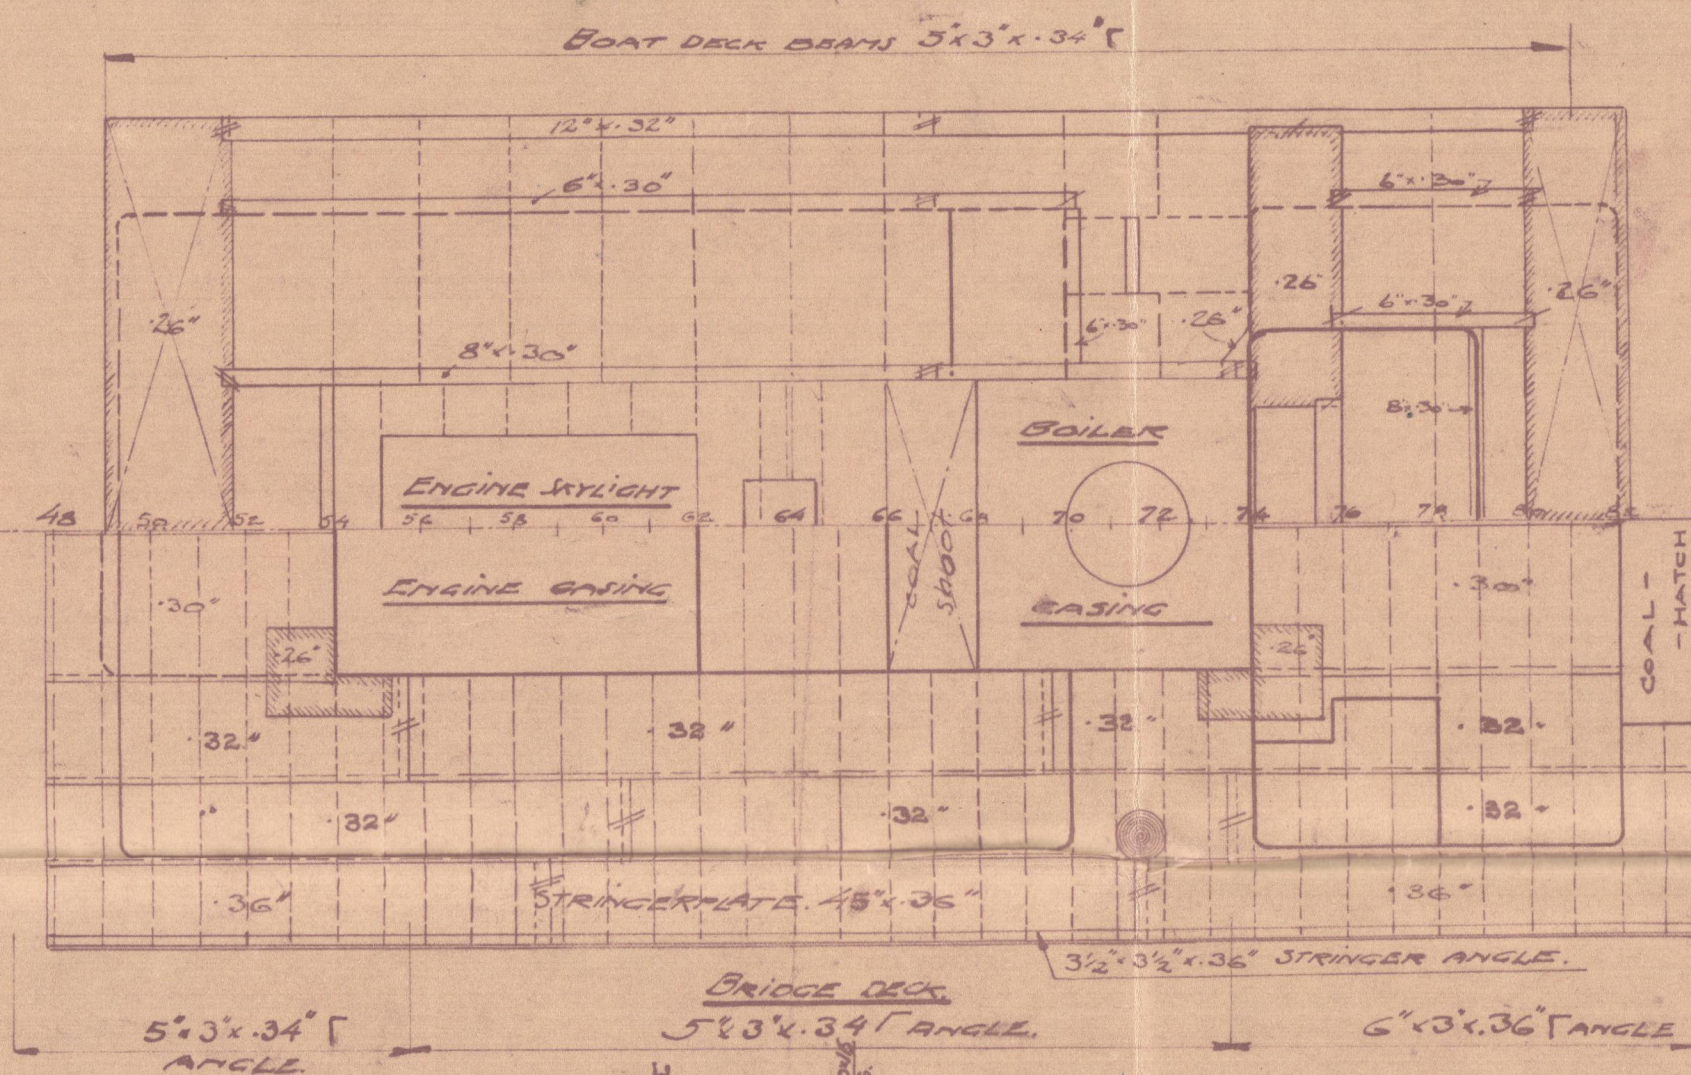


<u>DIMENSIONS</u>	
LENGTH BETWEEN PERP'S	256'-0"
AS PER RULE	
BREADTH	38'-2"
DEPTH MOULDED	18'-9 3/4"

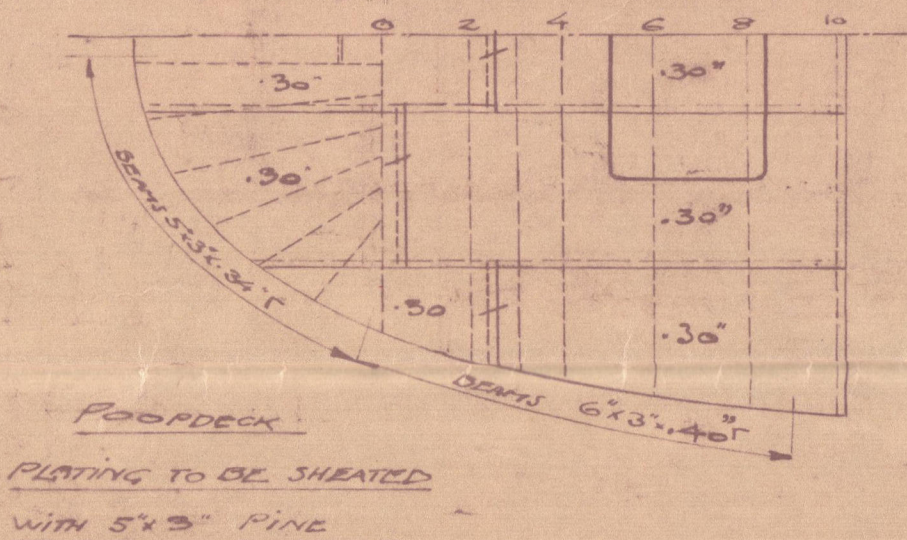

S.S. 151.  
LLOYD'S PROFILE

$\sqrt{8''} = 1 \text{ FOOT.}$

Lloyd's Register  
151 / 2  
Foundation

W548-0223

ster



Vessel as built.

Malmö


Locknäs Mekan. Verkstads AB.

S/S No. 151.

Profile.

"Gertrud Bratt"

RETAIN

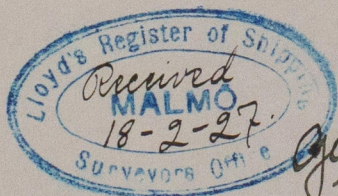

W548-0223



© 2021

Lloyd's Register  
Foundation