


**DIMENSIONS**  
 LENGTH BETWEEN PERPS 256'-0"  
 AS PER RULE  
 BREADTH 38'-2"  
 DEPTH MOULDED 18'-9 3/4"







**PROFILE OF A FREIGHT STEAMER**  
 TO CLASS LLOYDS 100 AI SINGLE DECK STEEL

SCALE 1/8" = 1 FOOT

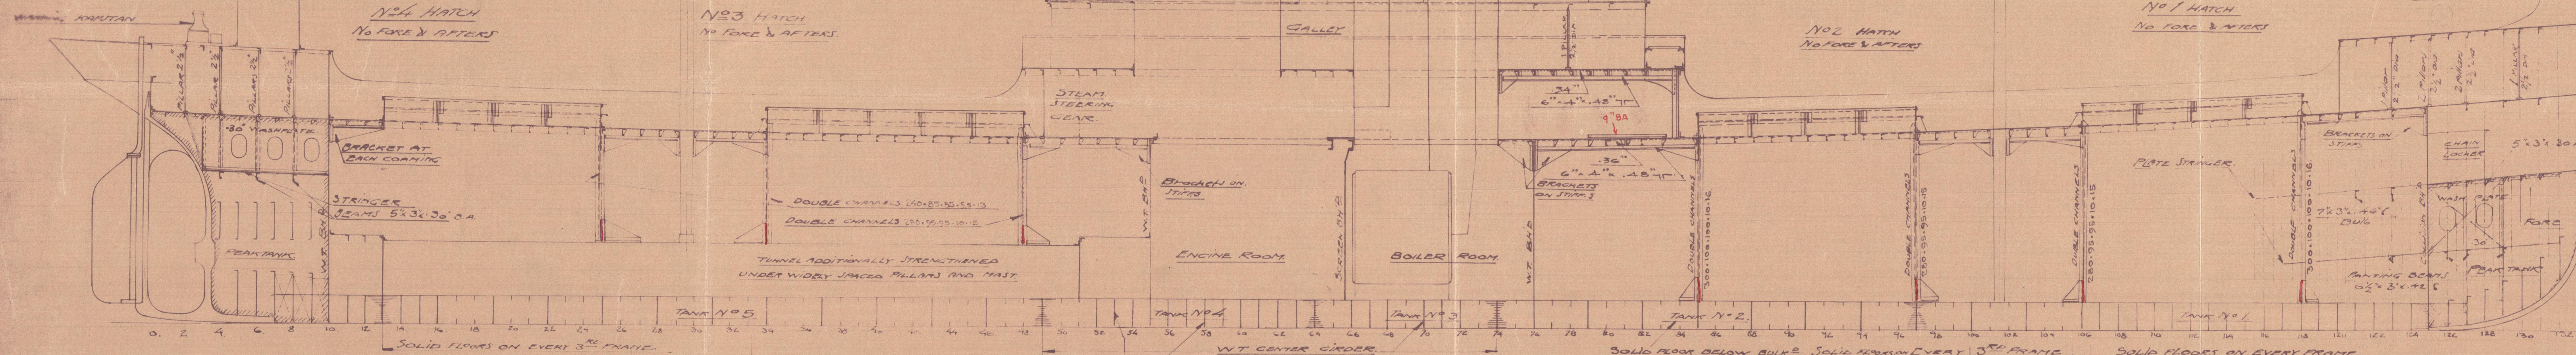


**BOW STRENGTHENING**  
 FROM ITEM TO 121/15 INTERMEDIATE FRAMES TO BE FITTED FROM APT 4'-3" FROM MAINDECK DOWN TO 1<sup>ST</sup> STRINGER, BEAMS SHALL STRAKES D & E AT LVL BEING INCREASED TO 50 AND 60 RESPECTIVELY STRAKES BELOW 44"

**BOTTOM STRENGTHENED FORWARD**  
 71 PER RULE SECTION  
 THE RIVETS IN PLATING AND FRAMES IN THE BOW FORWARD OF 3/8 L TO BE SPACED NOT MORE THAN 5 1/2 IN. AHEAD CENTER TO CENTER.

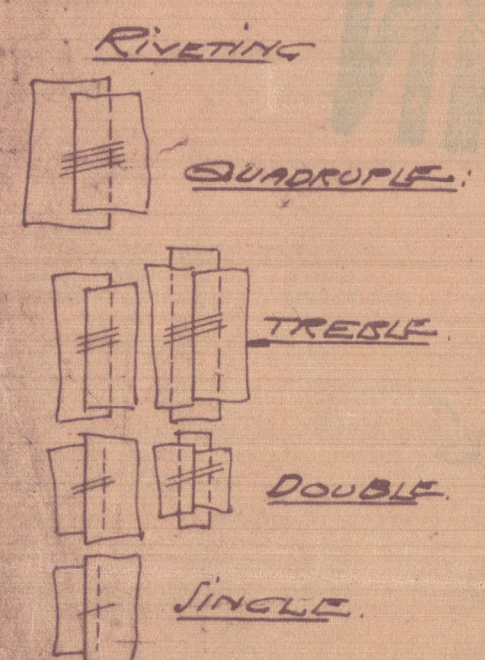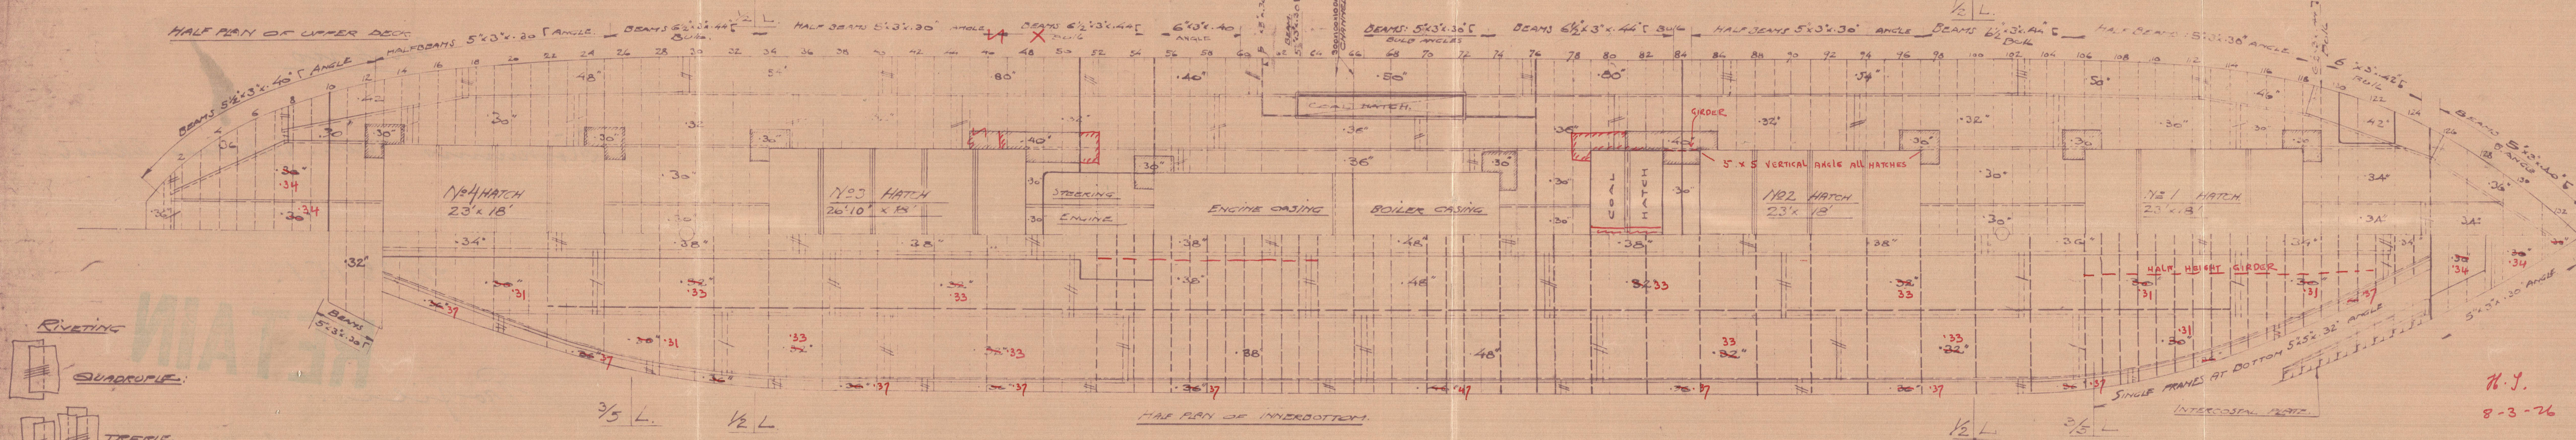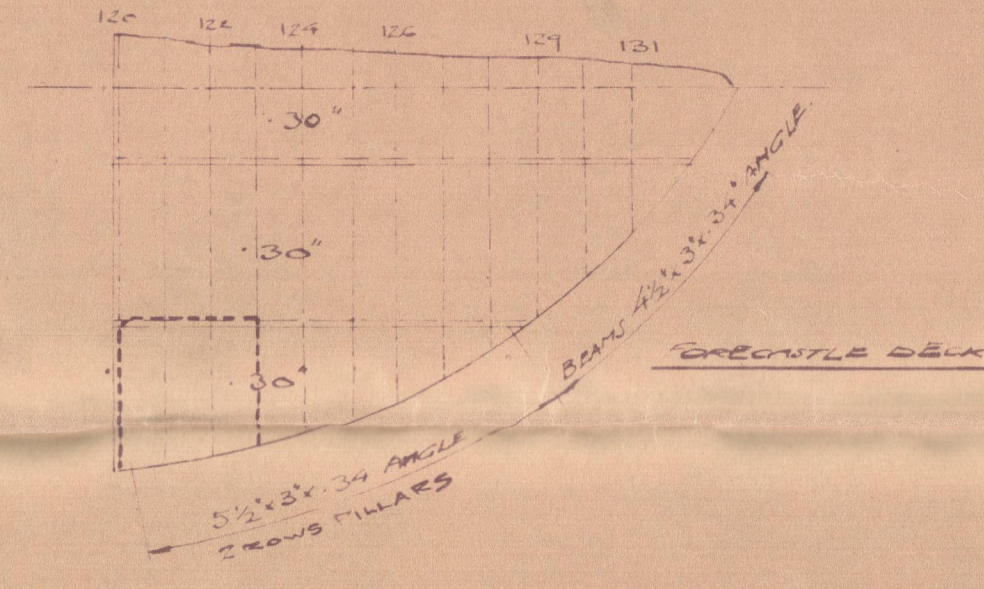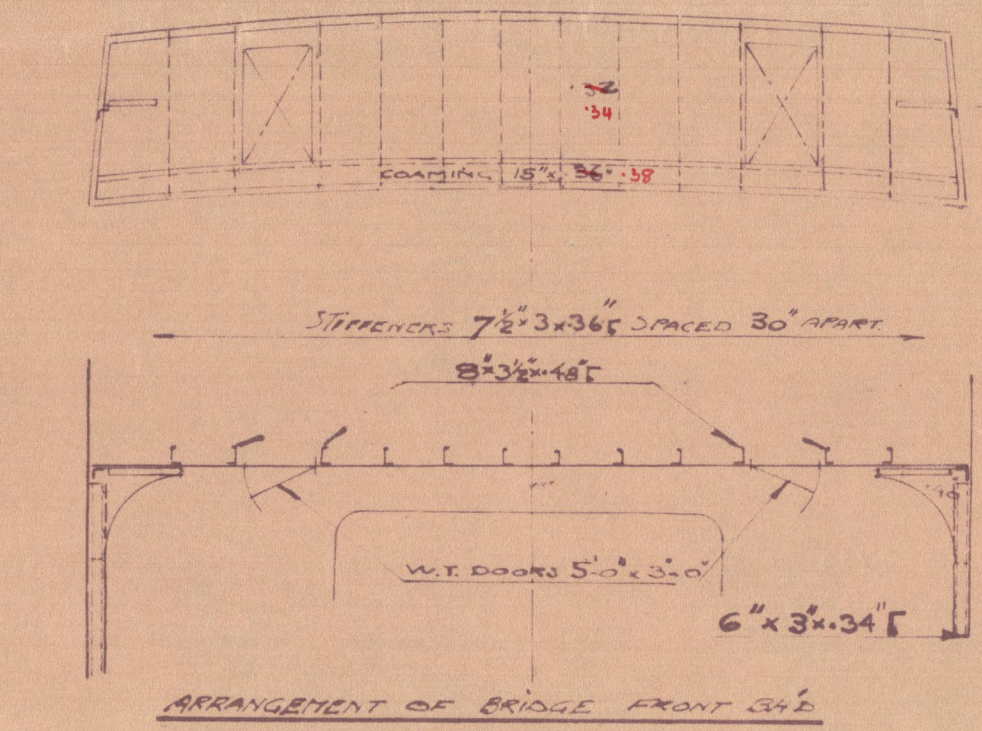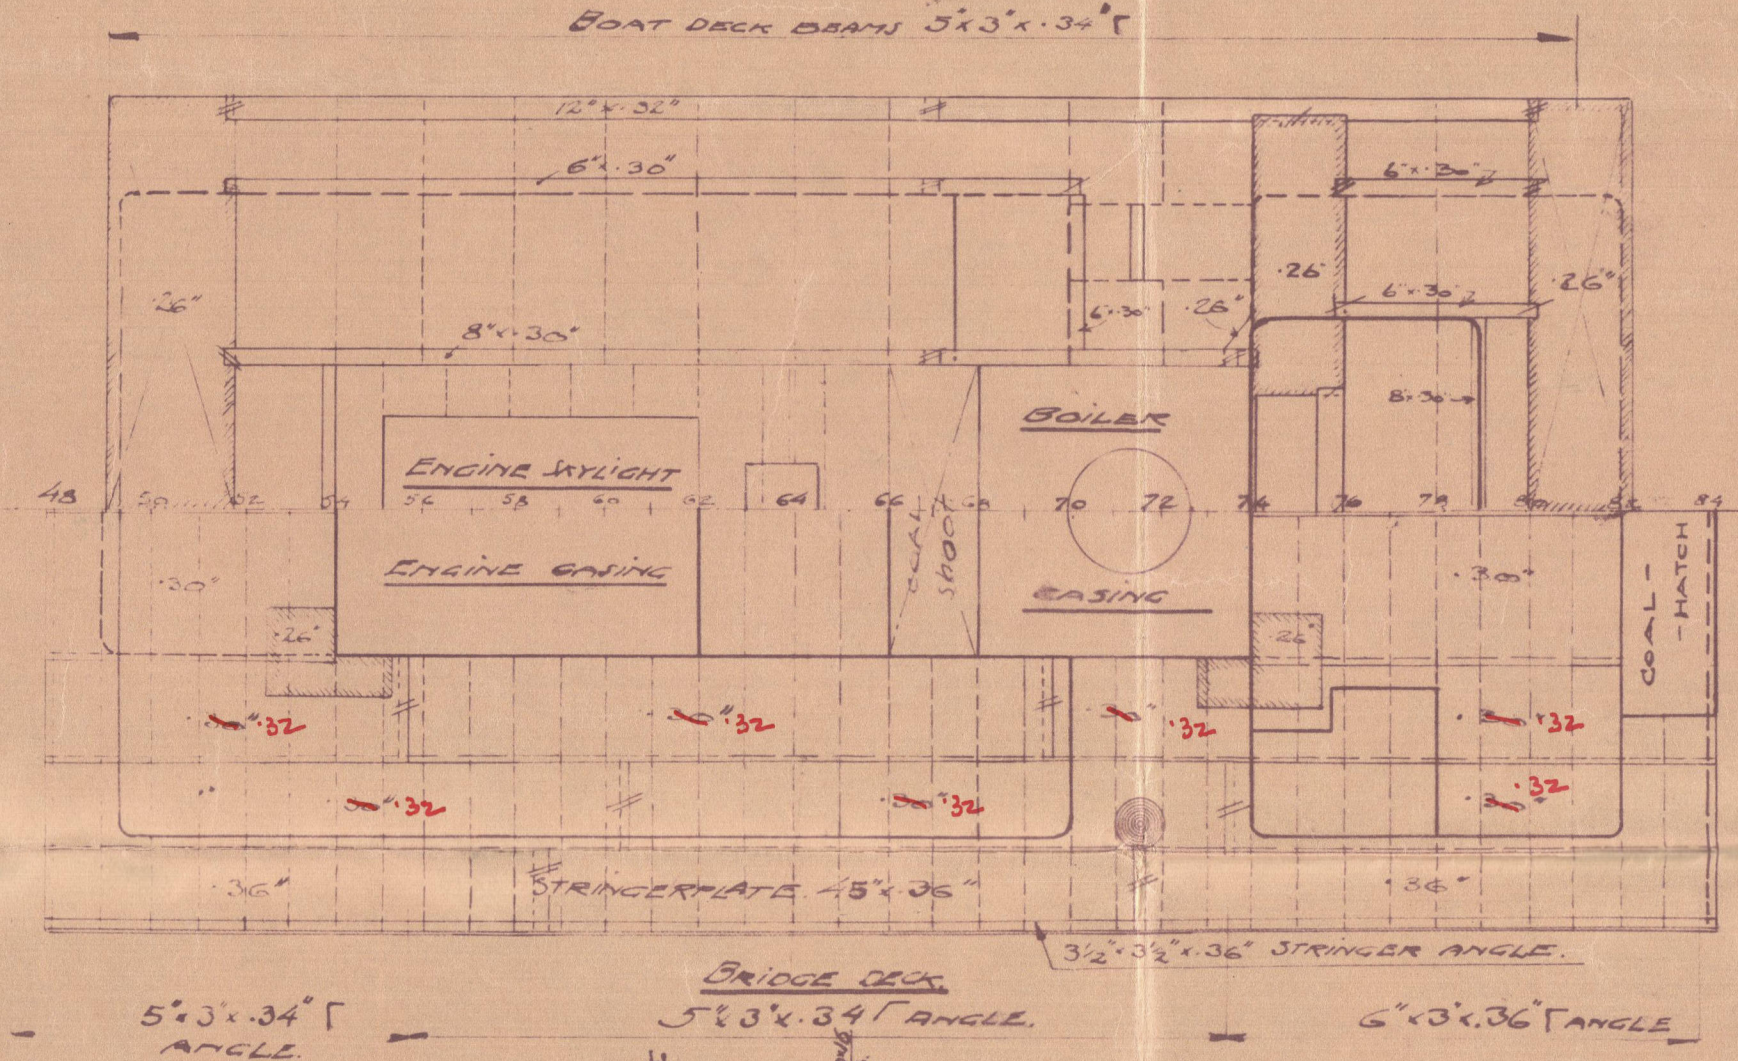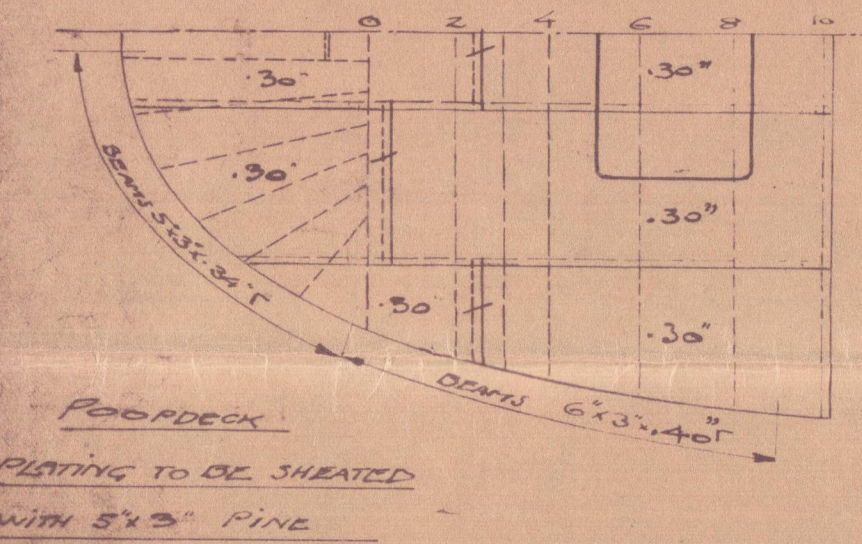

**STRENGTHENING OF SHELL PLATING**  
 IN WAY OF LONG BRIDGE

**ARRANGEMENT AT BREAKS TO**  
 SURVEYOR'S SATISFACTION  
 STRINGER RIVETS NOT TO BE CUT AT BREAK

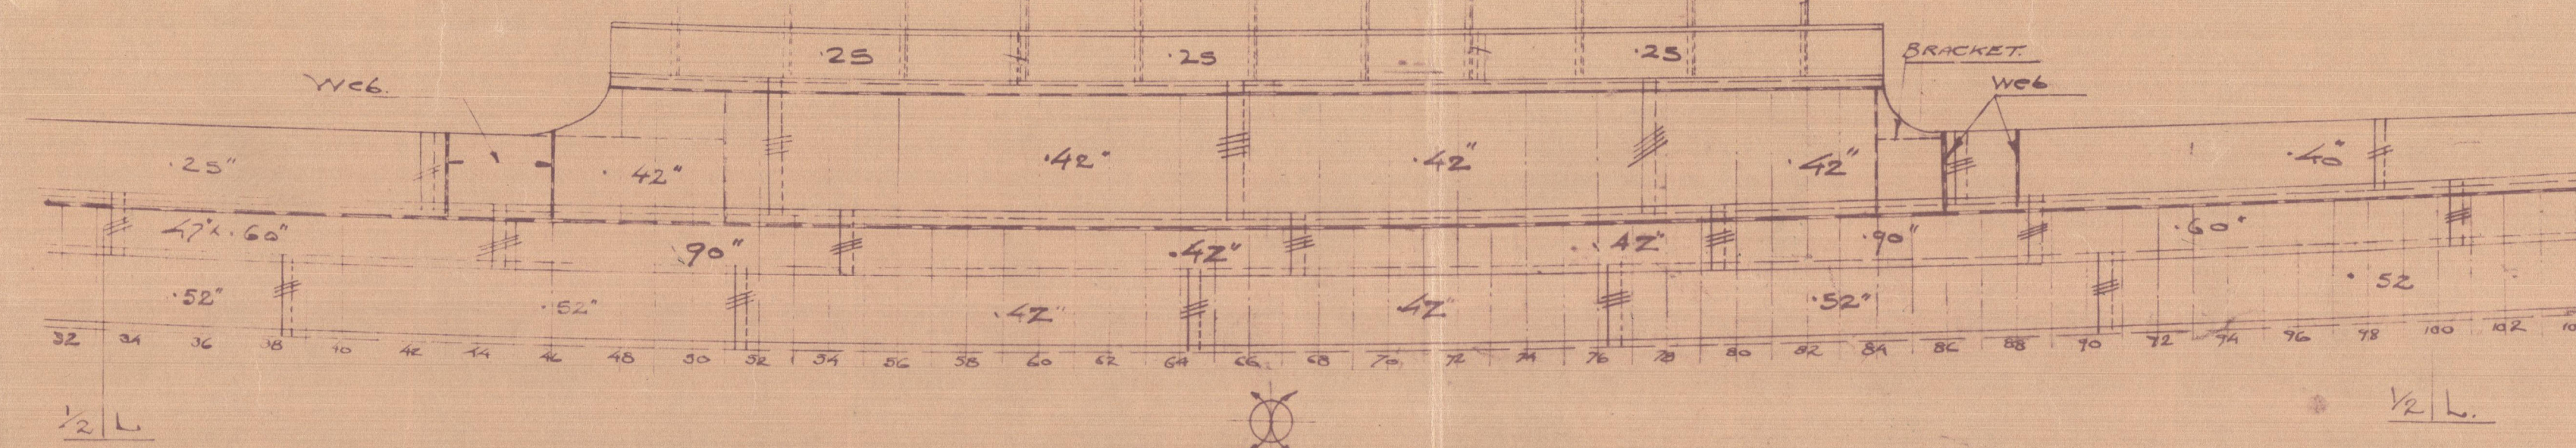

N.Y.  



151.  
 5.5.151.  
 LLOYD'S PROFILE

1/8" = 1 FOOT

CONSTRUKTÖR VERKSTADS MALMÖ



W548-0221



Malmo

Röckums Mch. Verkstads Aktie.


Ls 42 151.

RETAIN

Profile.

"Gertrud Bratt

CEN BOX NO 2846

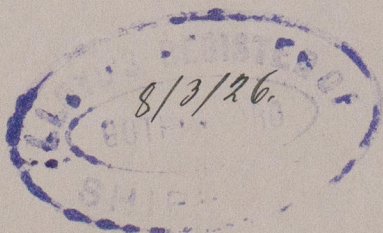

WS48-0224



© 2021

Lloyd's Register  
Foundation