

SCALE:  $\frac{1}{2}$ " = 1 FOOT.

ERECTIONS 43 %


EQUIPMENT.			
2 BOWER ANCHORS STOCKLESS	33 CWTs EACH		
1 " " "	28 "		
1 STREAM " "	EX STOCK	8 1/2 "	
240 FATHOMS 1 1/8" STUD CHAIN	CABLE OF A		
MINIMUM WEIGHT = 344 3/4 CWTs			

75 FATHOMS 1 $\frac{1}{8}$ " STREAM CHAIN OR 4" STEEL WIRE

90 " " " " HEMP OR 3 $\frac{1}{2}$ " " "

2 HAWSERS 90 FATHOMS OF 6" HEMP OR 2 $\frac{1}{4}$ " STEEL WIRE

2 WARPS 90 " " 5" " " 1 $\frac{3}{4}$ " " "

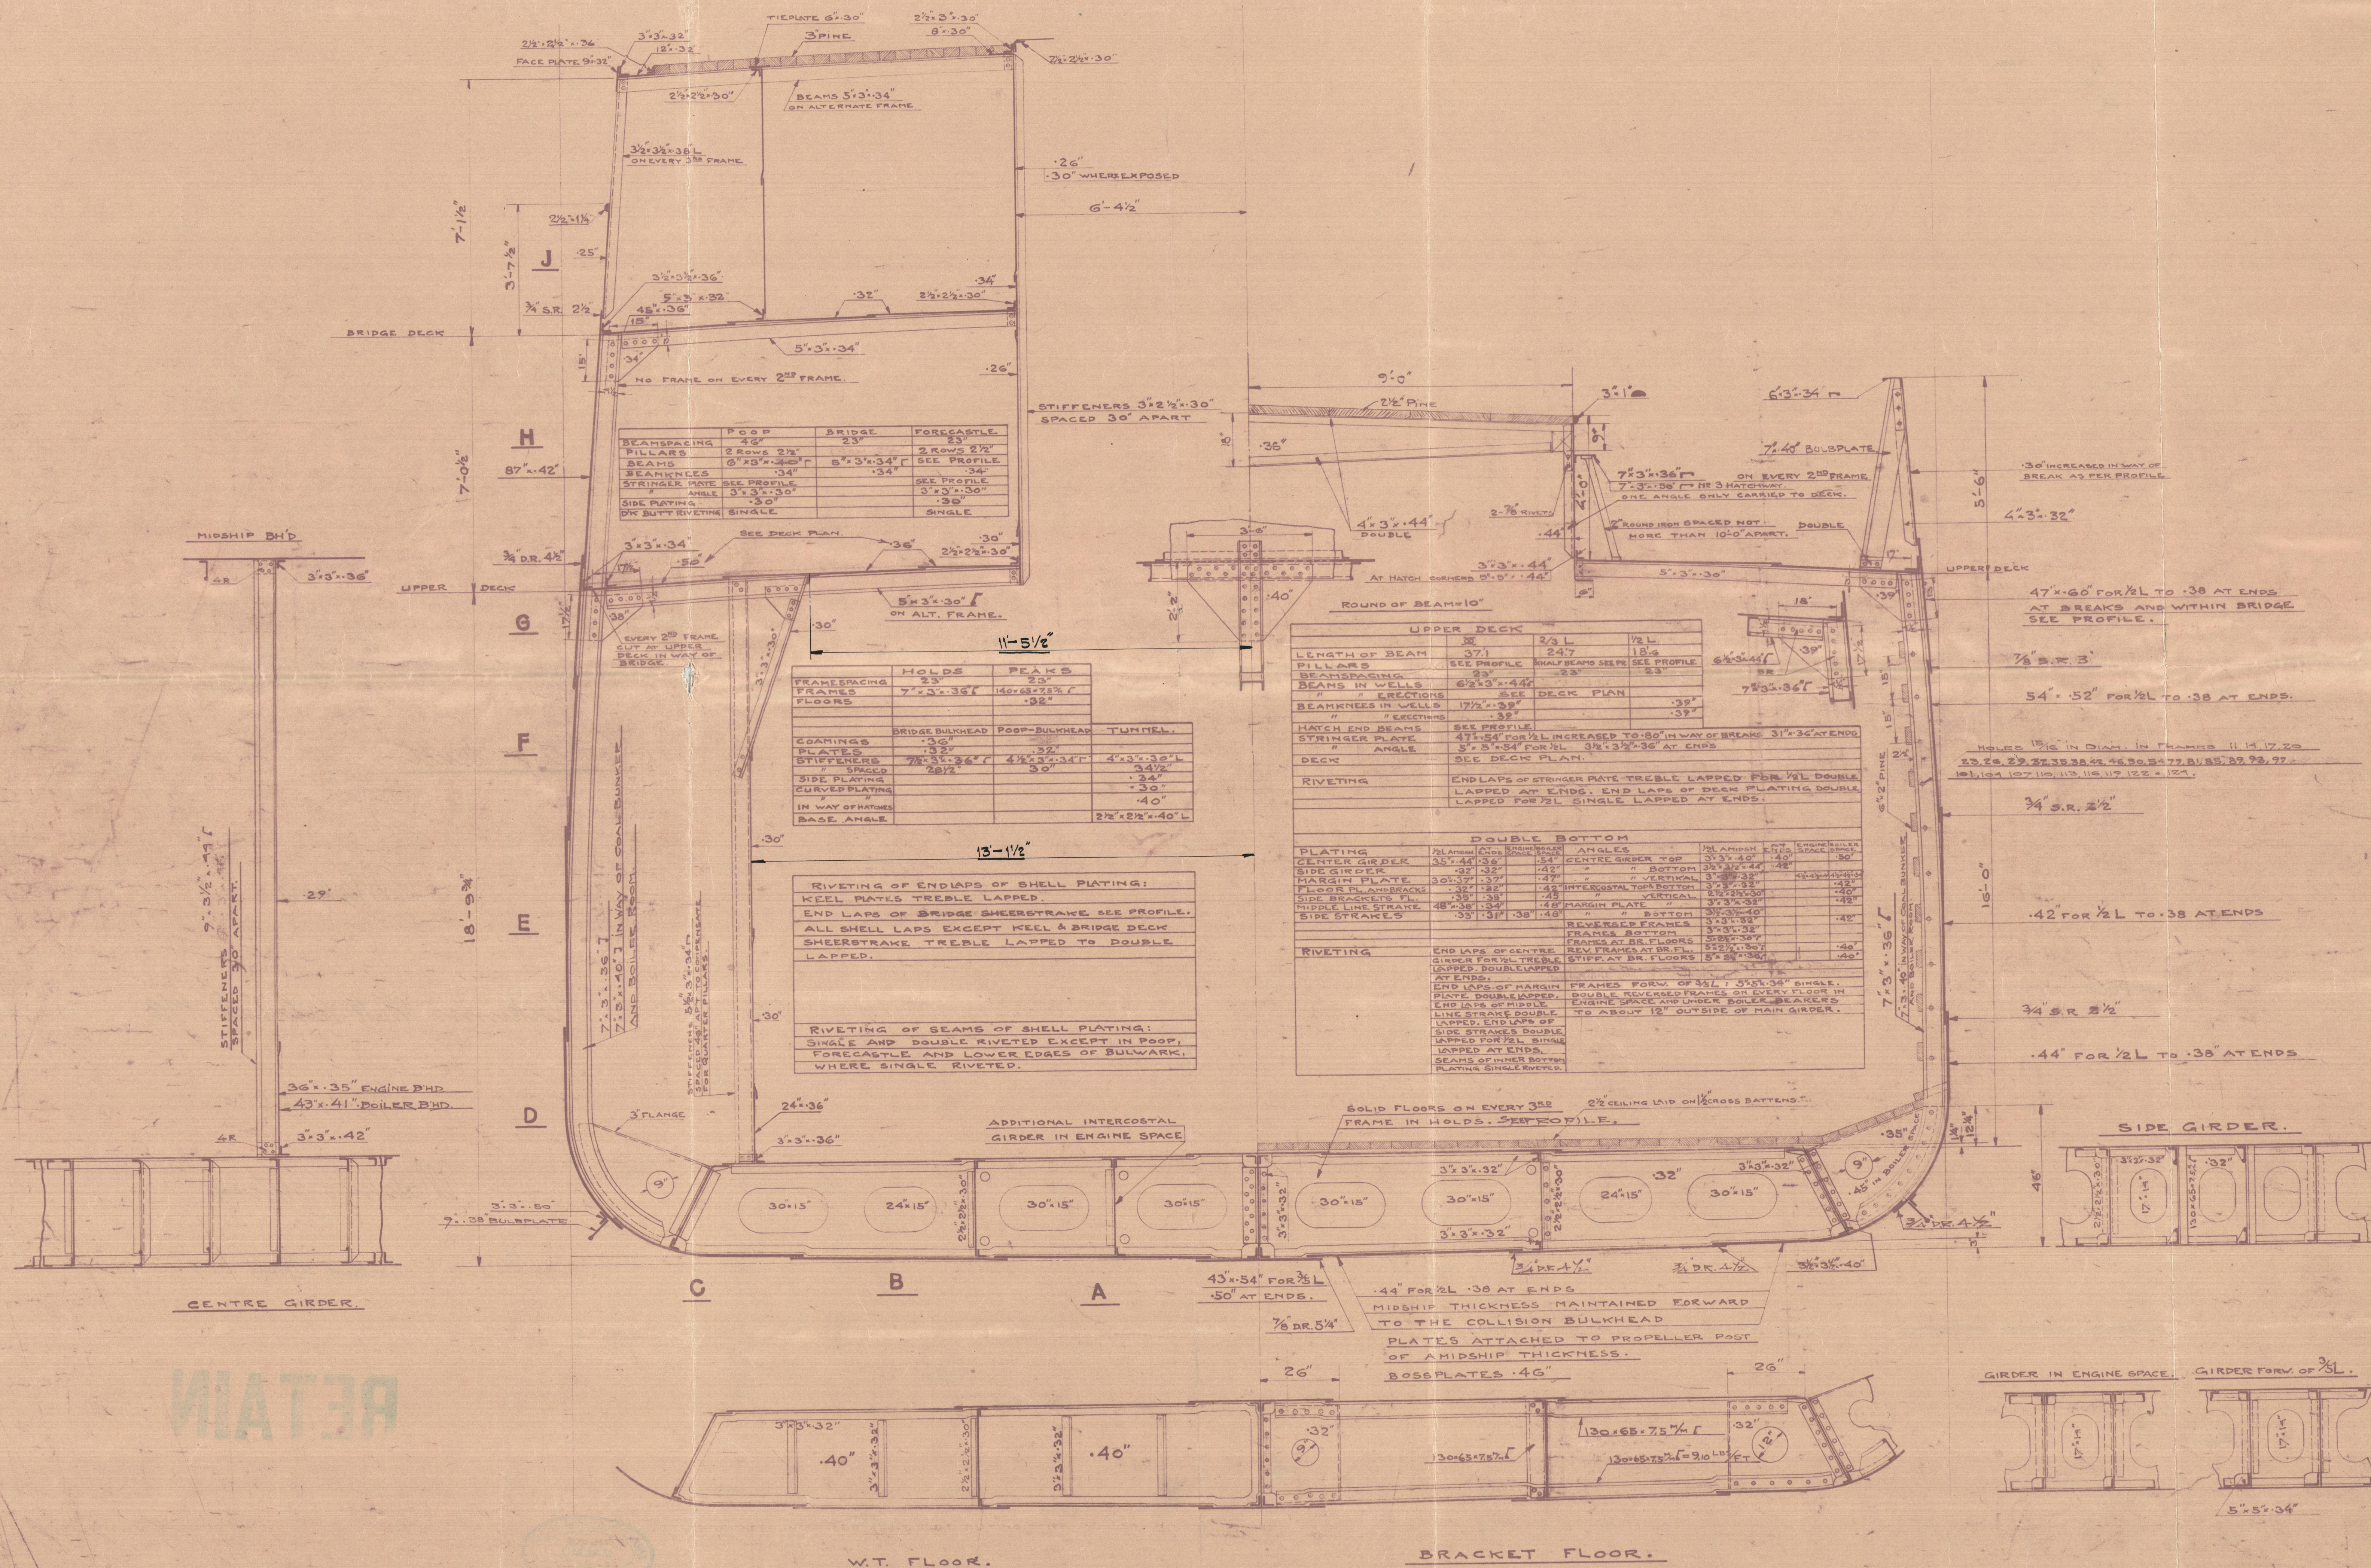

5/5/51  
MIDSHIP SECTION:

$$\frac{1}{2}'' = 1'' - 0''$$

© 2021  
Lloyds Register  
Foundation



Vessel as built.

Malmö.


Kockums Mek. Verkstads AB,

S/S No. 151

Midships section.

"Gertrud Bratt"

RETAIN

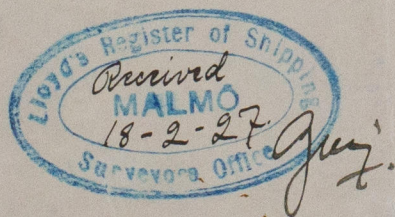

Ws 48 - 0226



© 2021

Lloyd's Register  
Foundation