



30.3.08

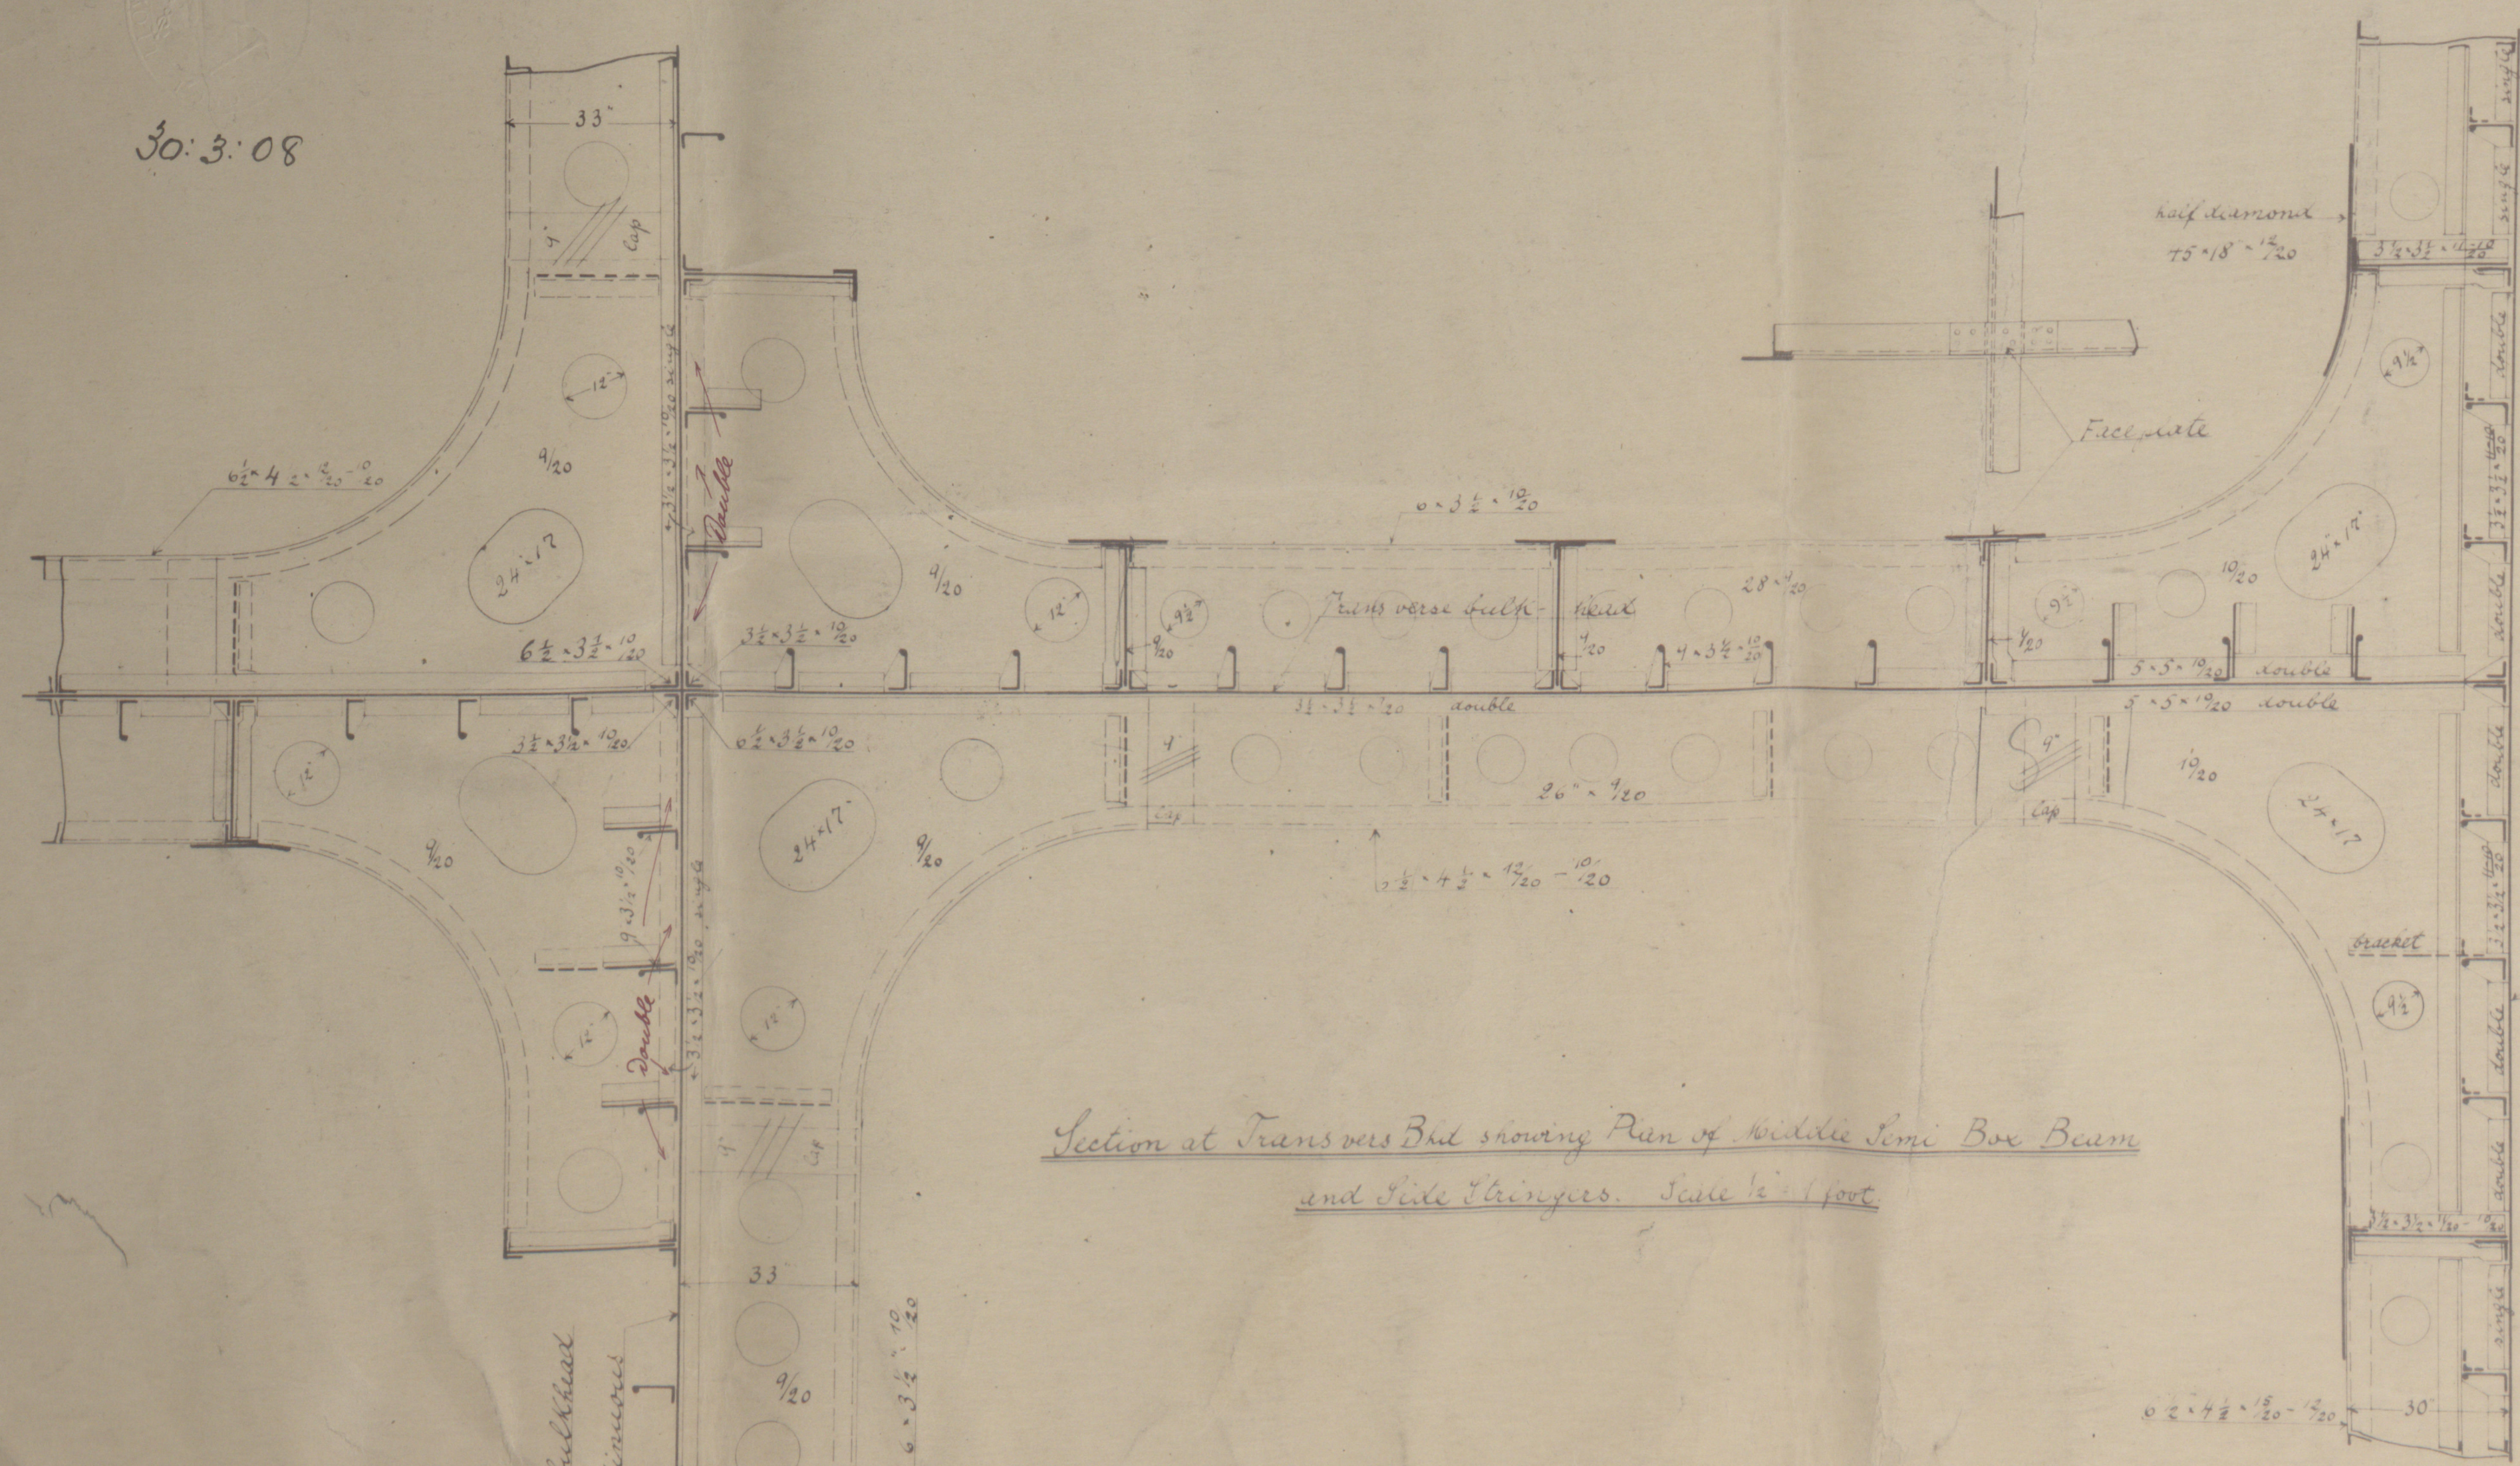


Section at Transverse Bulkhead showing Plan of Middle Long Box Beam and Side Stanchions. June 1st 1908

Intercooler in Double Bottom

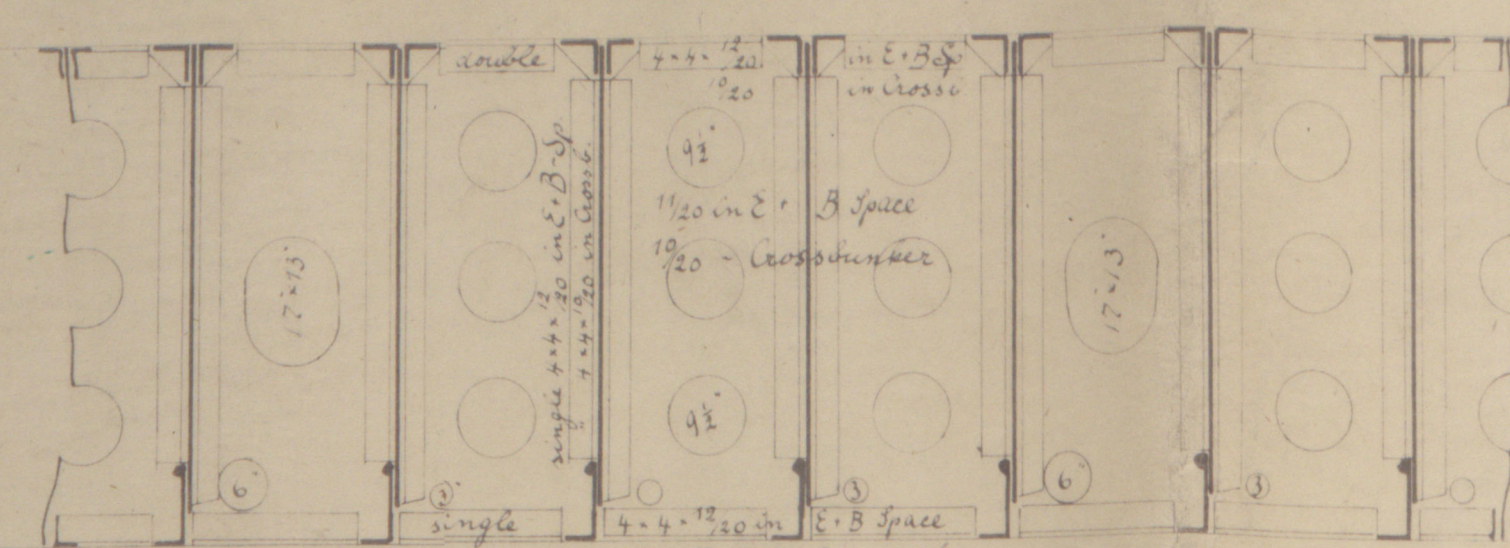

Section of double bottom

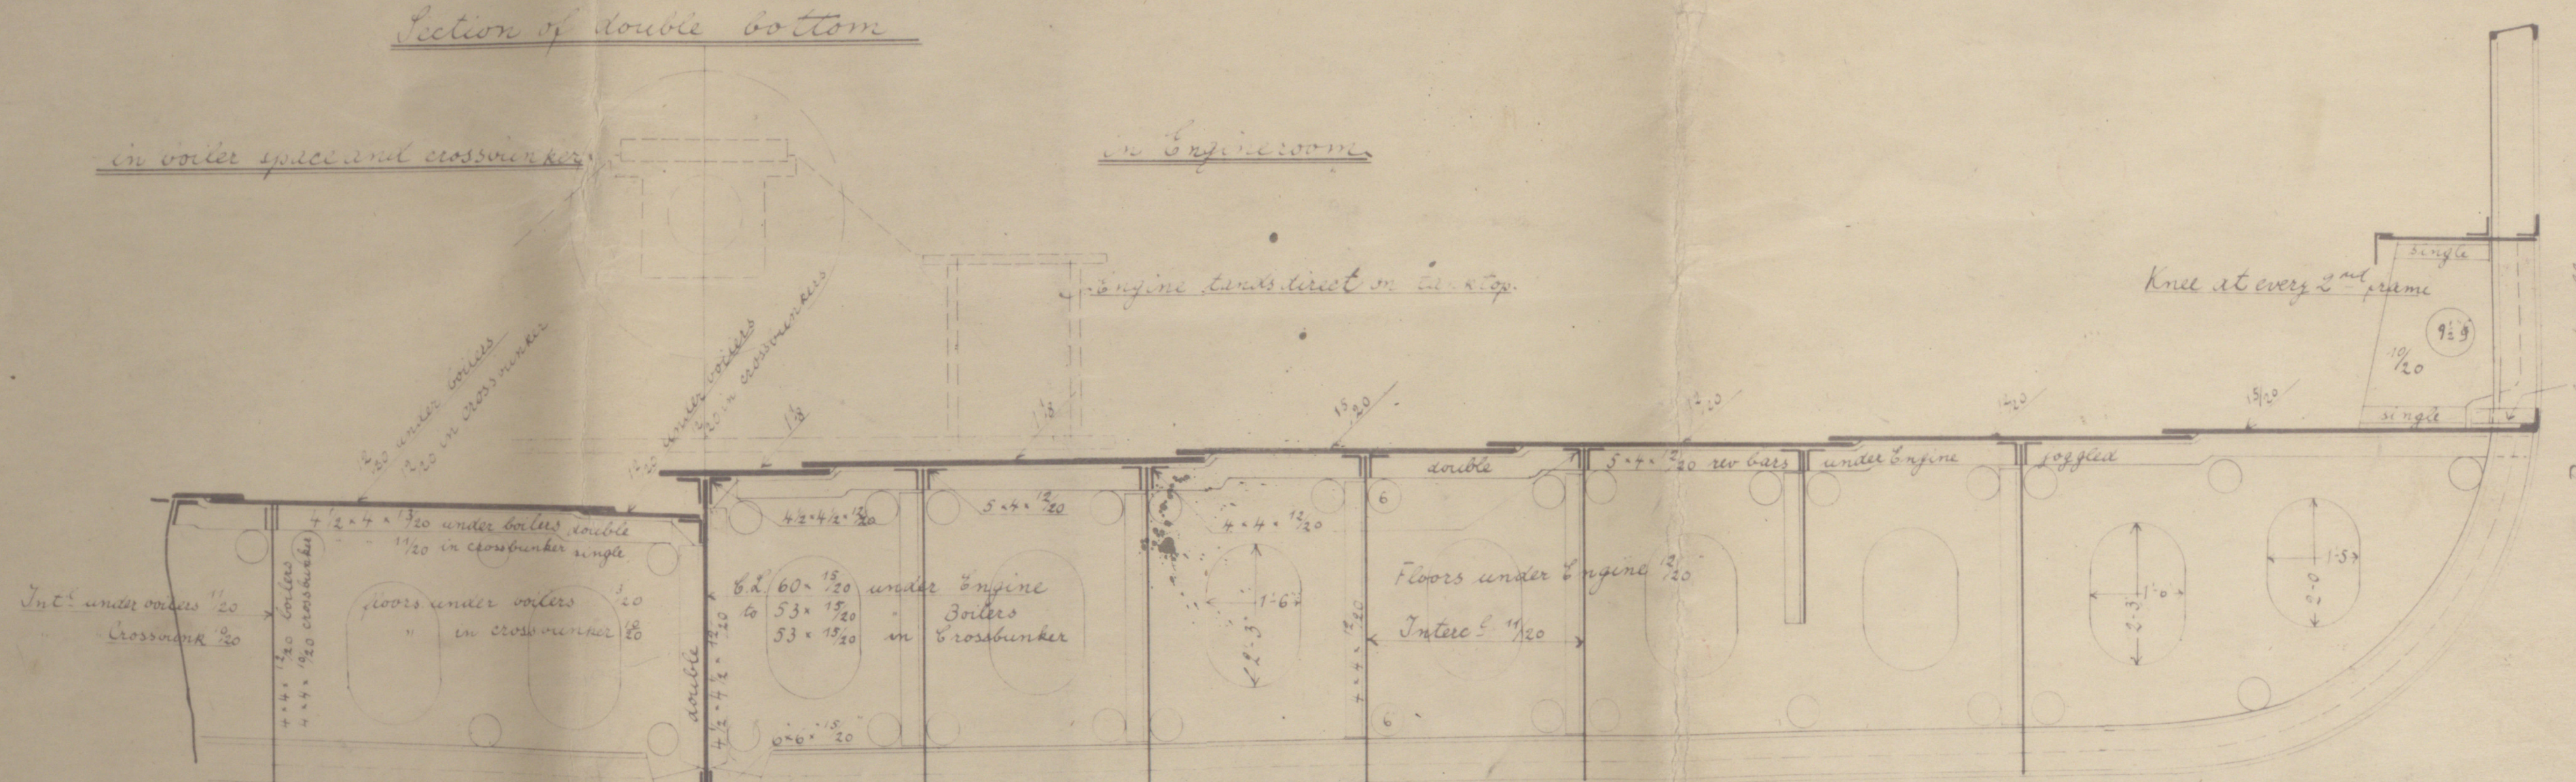


No 286.










Reinforcing of stringer on Shell - Deck.

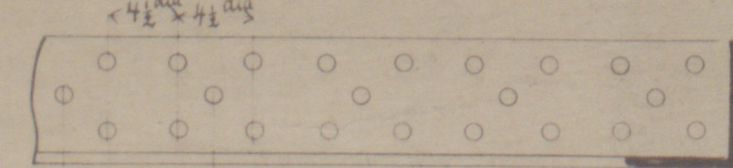

Reinforcing of 5 and 6 angles.

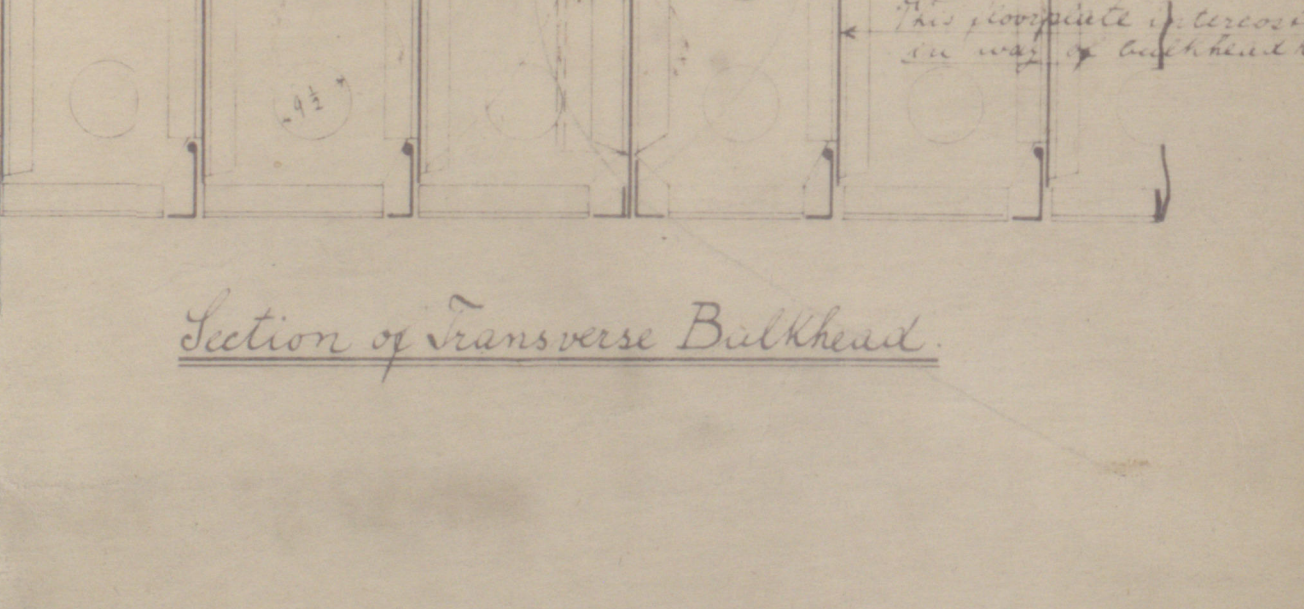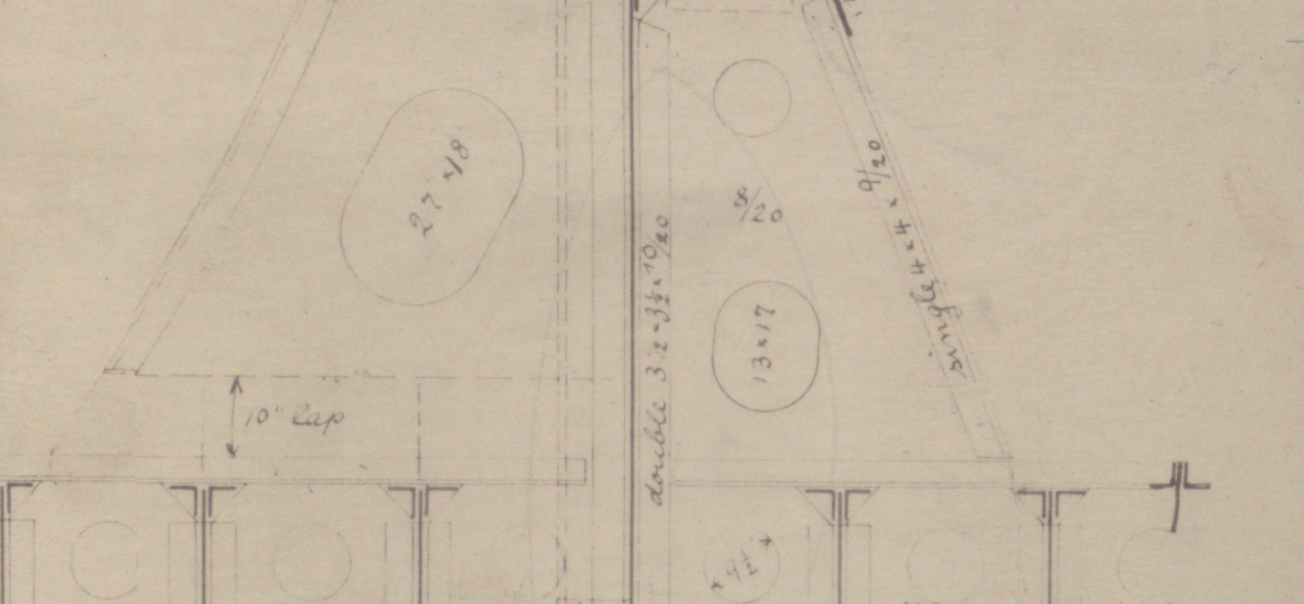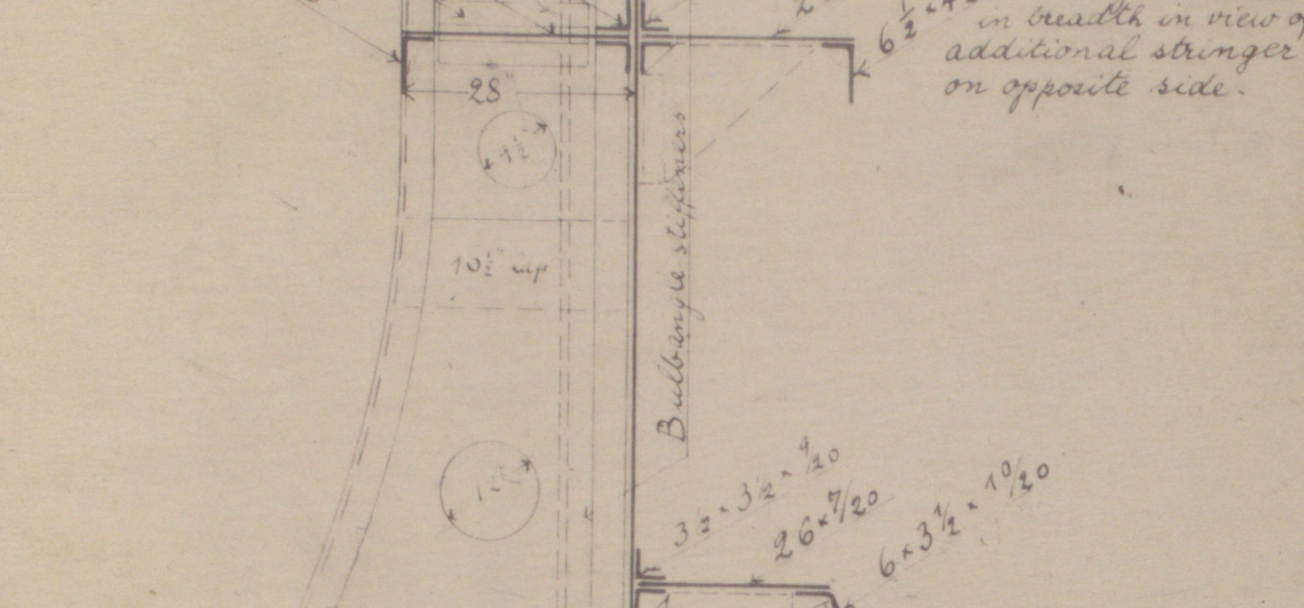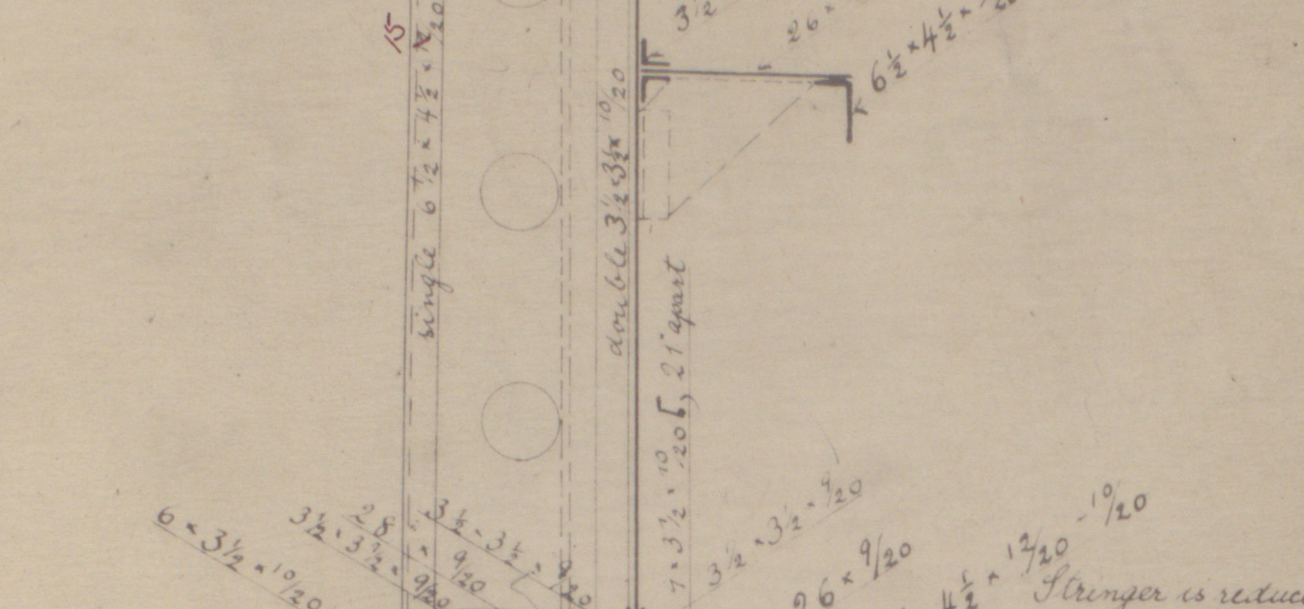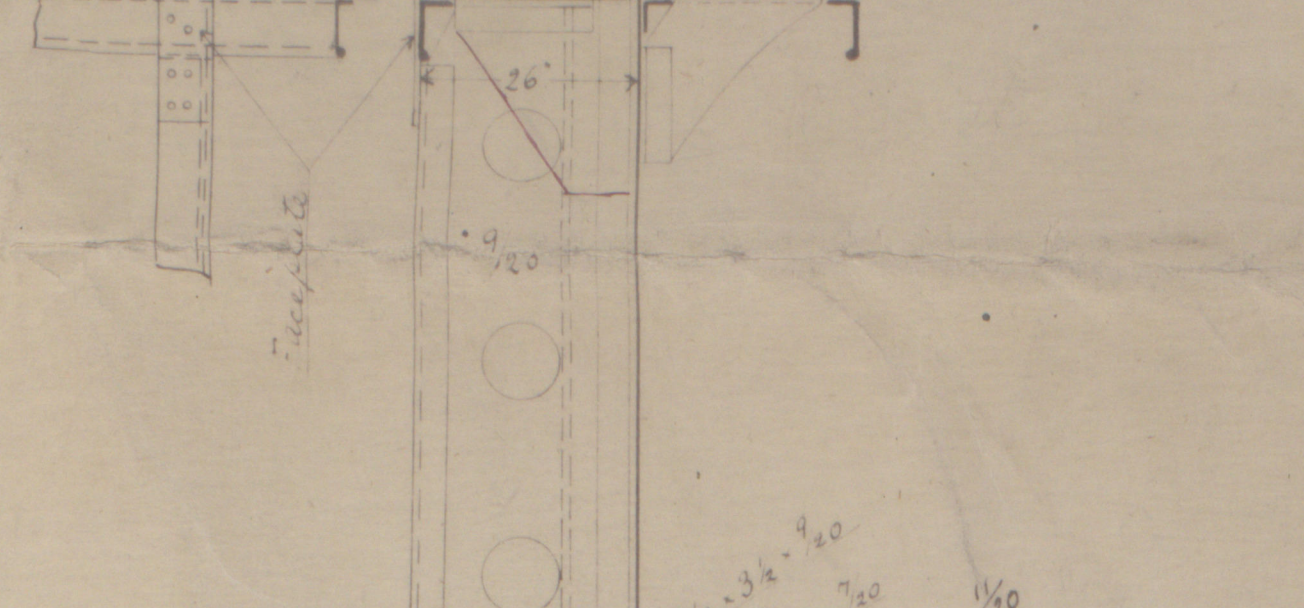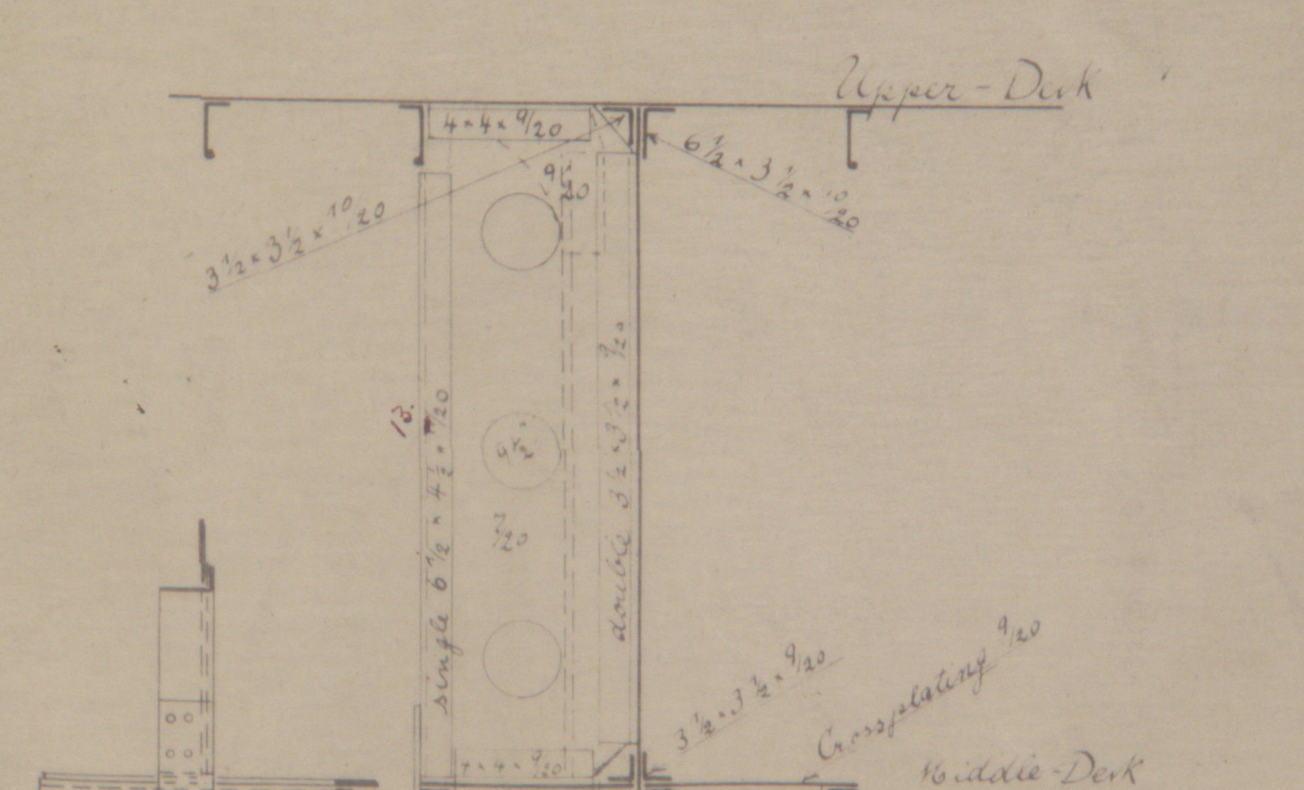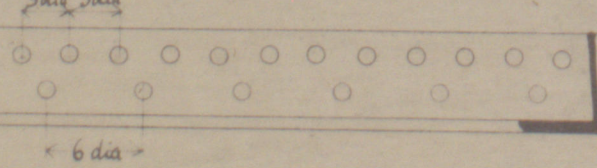




TRANSVERSE SECTION


FLENSBURG No 286

HAMB. Letter 23/4/08

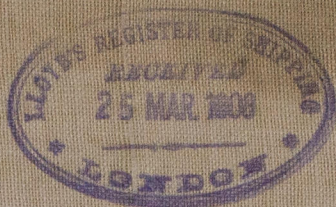

HAMBURG Report  
No 10718

S/S "Buffalo"

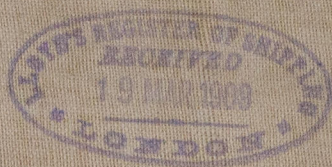

RETAIN



© 2021

Lloyd's Register  
Foundation

WS49-0225