

# S.S. "NERVIER."


[EX. "WAR ARYAN"]

LENGTH BETWEEN, P.P. 400'0" ✓  
BREADTH MOULDED, 52'0" ✓  
DEPTH TO UPPERDECK, 31'0" ✓

DETAILS OF ADDITIONAL  
TWEENDECK IN HOLDS.


SCALE.  $\frac{1}{2}$ " = ONE FOOT.

LLOYDS CLASS. \*100. A1.  
STANDARD VESSEL. A TYPE.

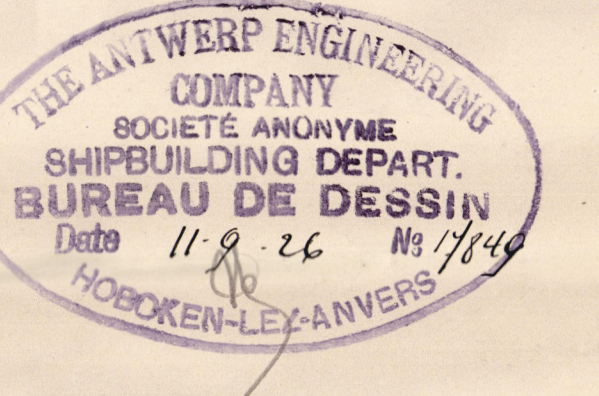


C N°1045 CLASS 1  
PLAN N°2

## $\frac{1}{2}$ SECTION OF ADDITIONAL TWEENDECK

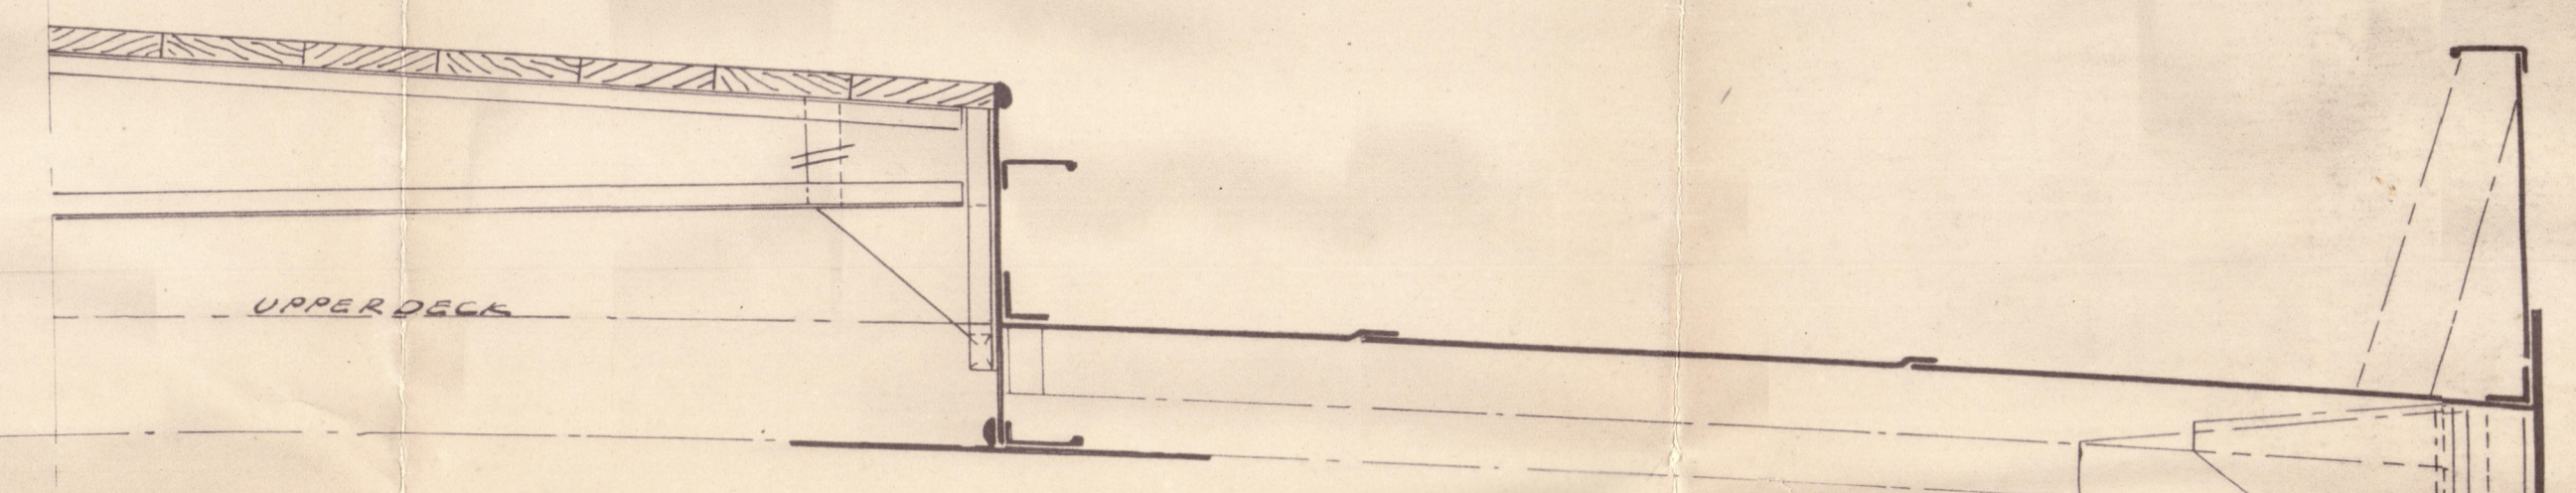

HATCH SIDE COAMINGS AS PER PROFILE  
TWEENDECK BEAMS AS PER PROFILE  
PLATING " " " "  
TWEENDECK PLATING BUTTS LAPPED AND S.R. THE WHOLE LENGTH  
" " " " OR " " " "  
TWEENDECK PLATING AND STRINGER PLATE BEAMS S.R.  
BOUNDARY ANGLES TO BULKHEADS SEE DETAIL.

HATCHES AS PER PROFILE

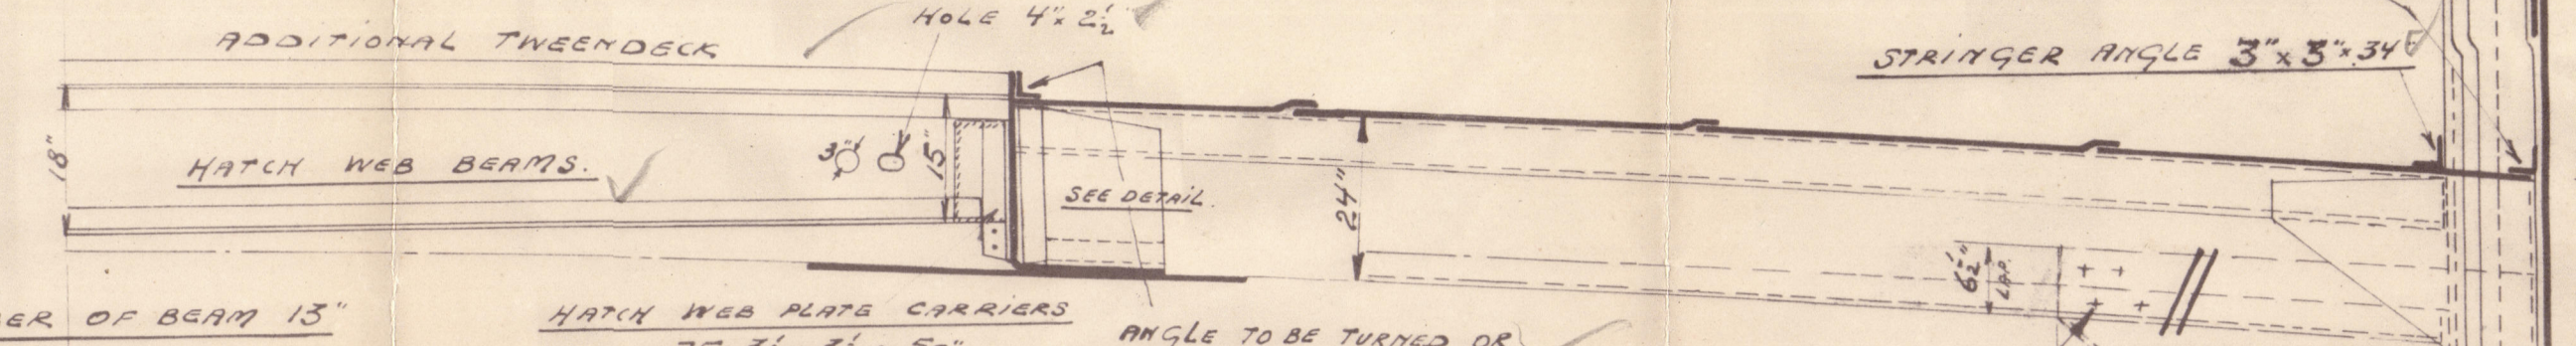

ADDITIONAL TWEENDECK  
HATCH WEB BEAMS  
HATCH WEB PLATE CARRIERS  
7"  $3\frac{1}{2}$ "  $3\frac{1}{2}$ "  $\times$  50"  
CAMBER OF BEAM 13"  
DETAIL SHOWING  
OPENING OF HATCH END  
BEAM PLATES AND TOP  
ANGLES

SHELL LUGS  $1\frac{1}{2}$ "  $3\frac{1}{2}$ "  $4\frac{1}{2}$ "  $\times$  34"  
STRINGER ANGLE  $3\frac{1}{2}$ "  $5\frac{1}{2}$ "

9'0" TWEENDECK


9 RIVETS  $\frac{7}{8}$ "  
OR 13 -  $3\frac{1}{4}$ "

3" PLANGE

14 RIVETS  $\frac{7}{8}$ "  
OR 19 -  $3\frac{1}{4}$ "

## ATTACHEMENT OF HALF BEAMS TO HATCH COAMING


BRACKET TO ALTERNATE BEAM

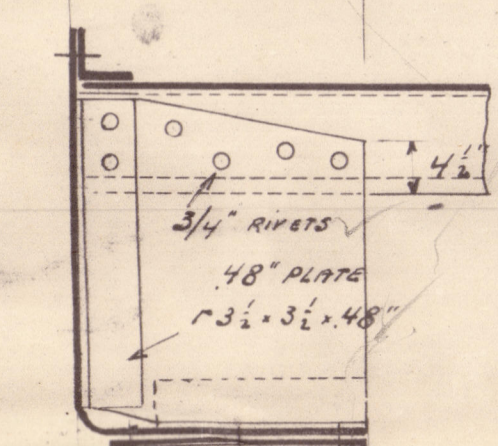

18" PLANGE  
M1-2-3-4 HATCH


121448

LUG STIFFENER  
TO ALTERNATE BEAM

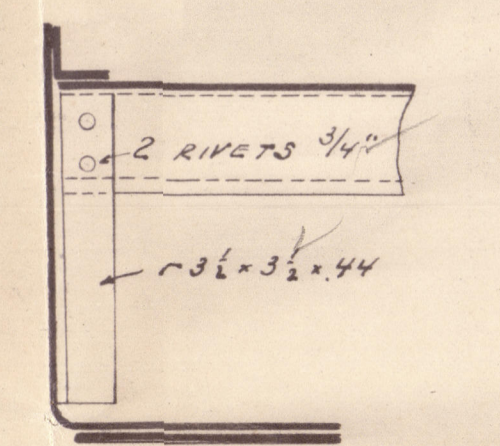

## DETAIL SHOWING STRENGTHENING AT HATCH CORNERS


AT HATCH CORNERS

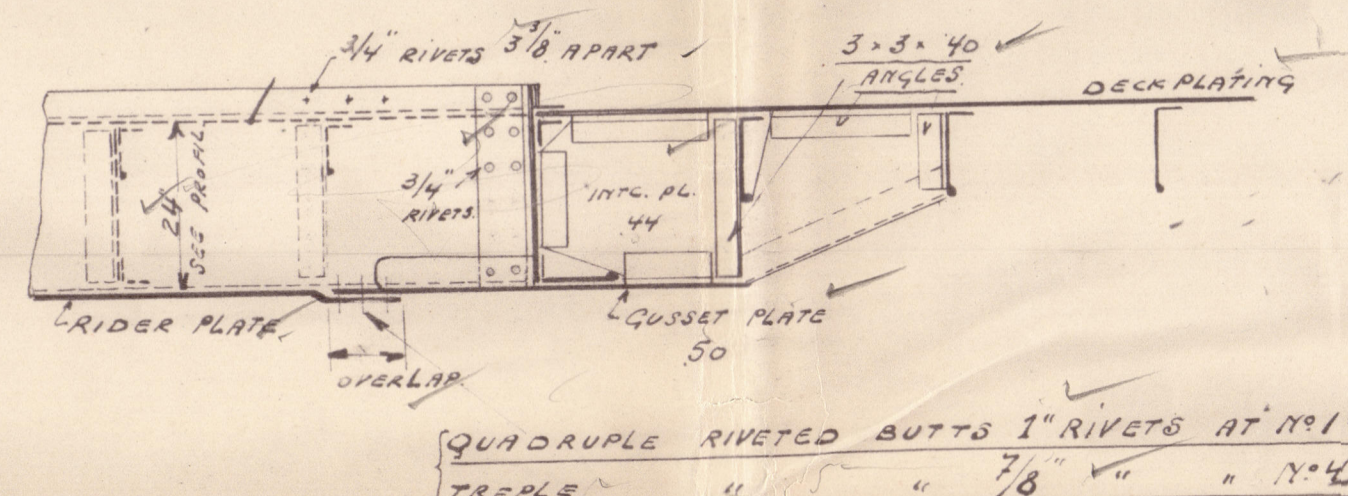


QUADRUPLE RIVETED BUTTS 1" RIVETS AT M1-2-3 HATCHES  
TRENCH " " "  $\frac{7}{8}$ " " " N°4 HATCH

## ATTACHEMENT OF TWEENDECK WEB FRAMES M163-167-171


WEB FRAMES TO CUT AT DECK

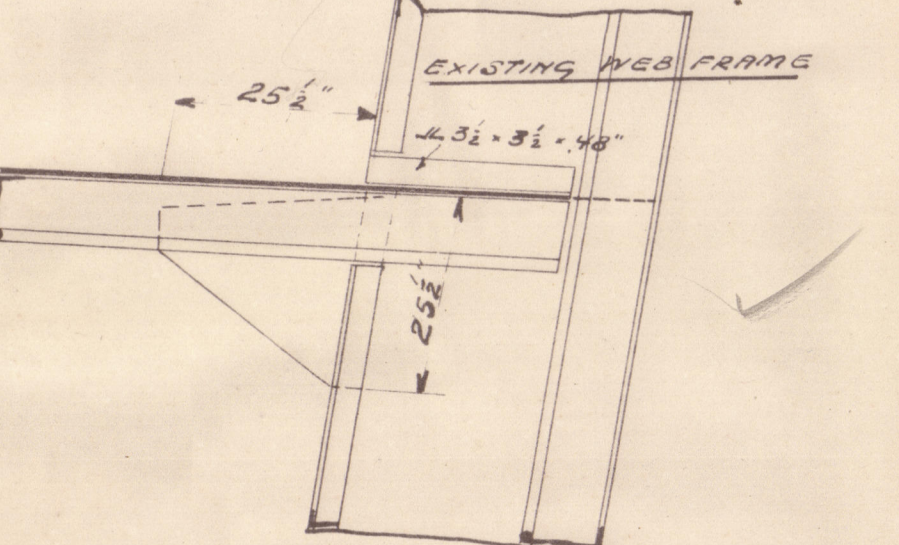

## ATTACHEMENT OF TWEENDECK BUILT PILLARS ON UPPERDECK AND TWEENDECK

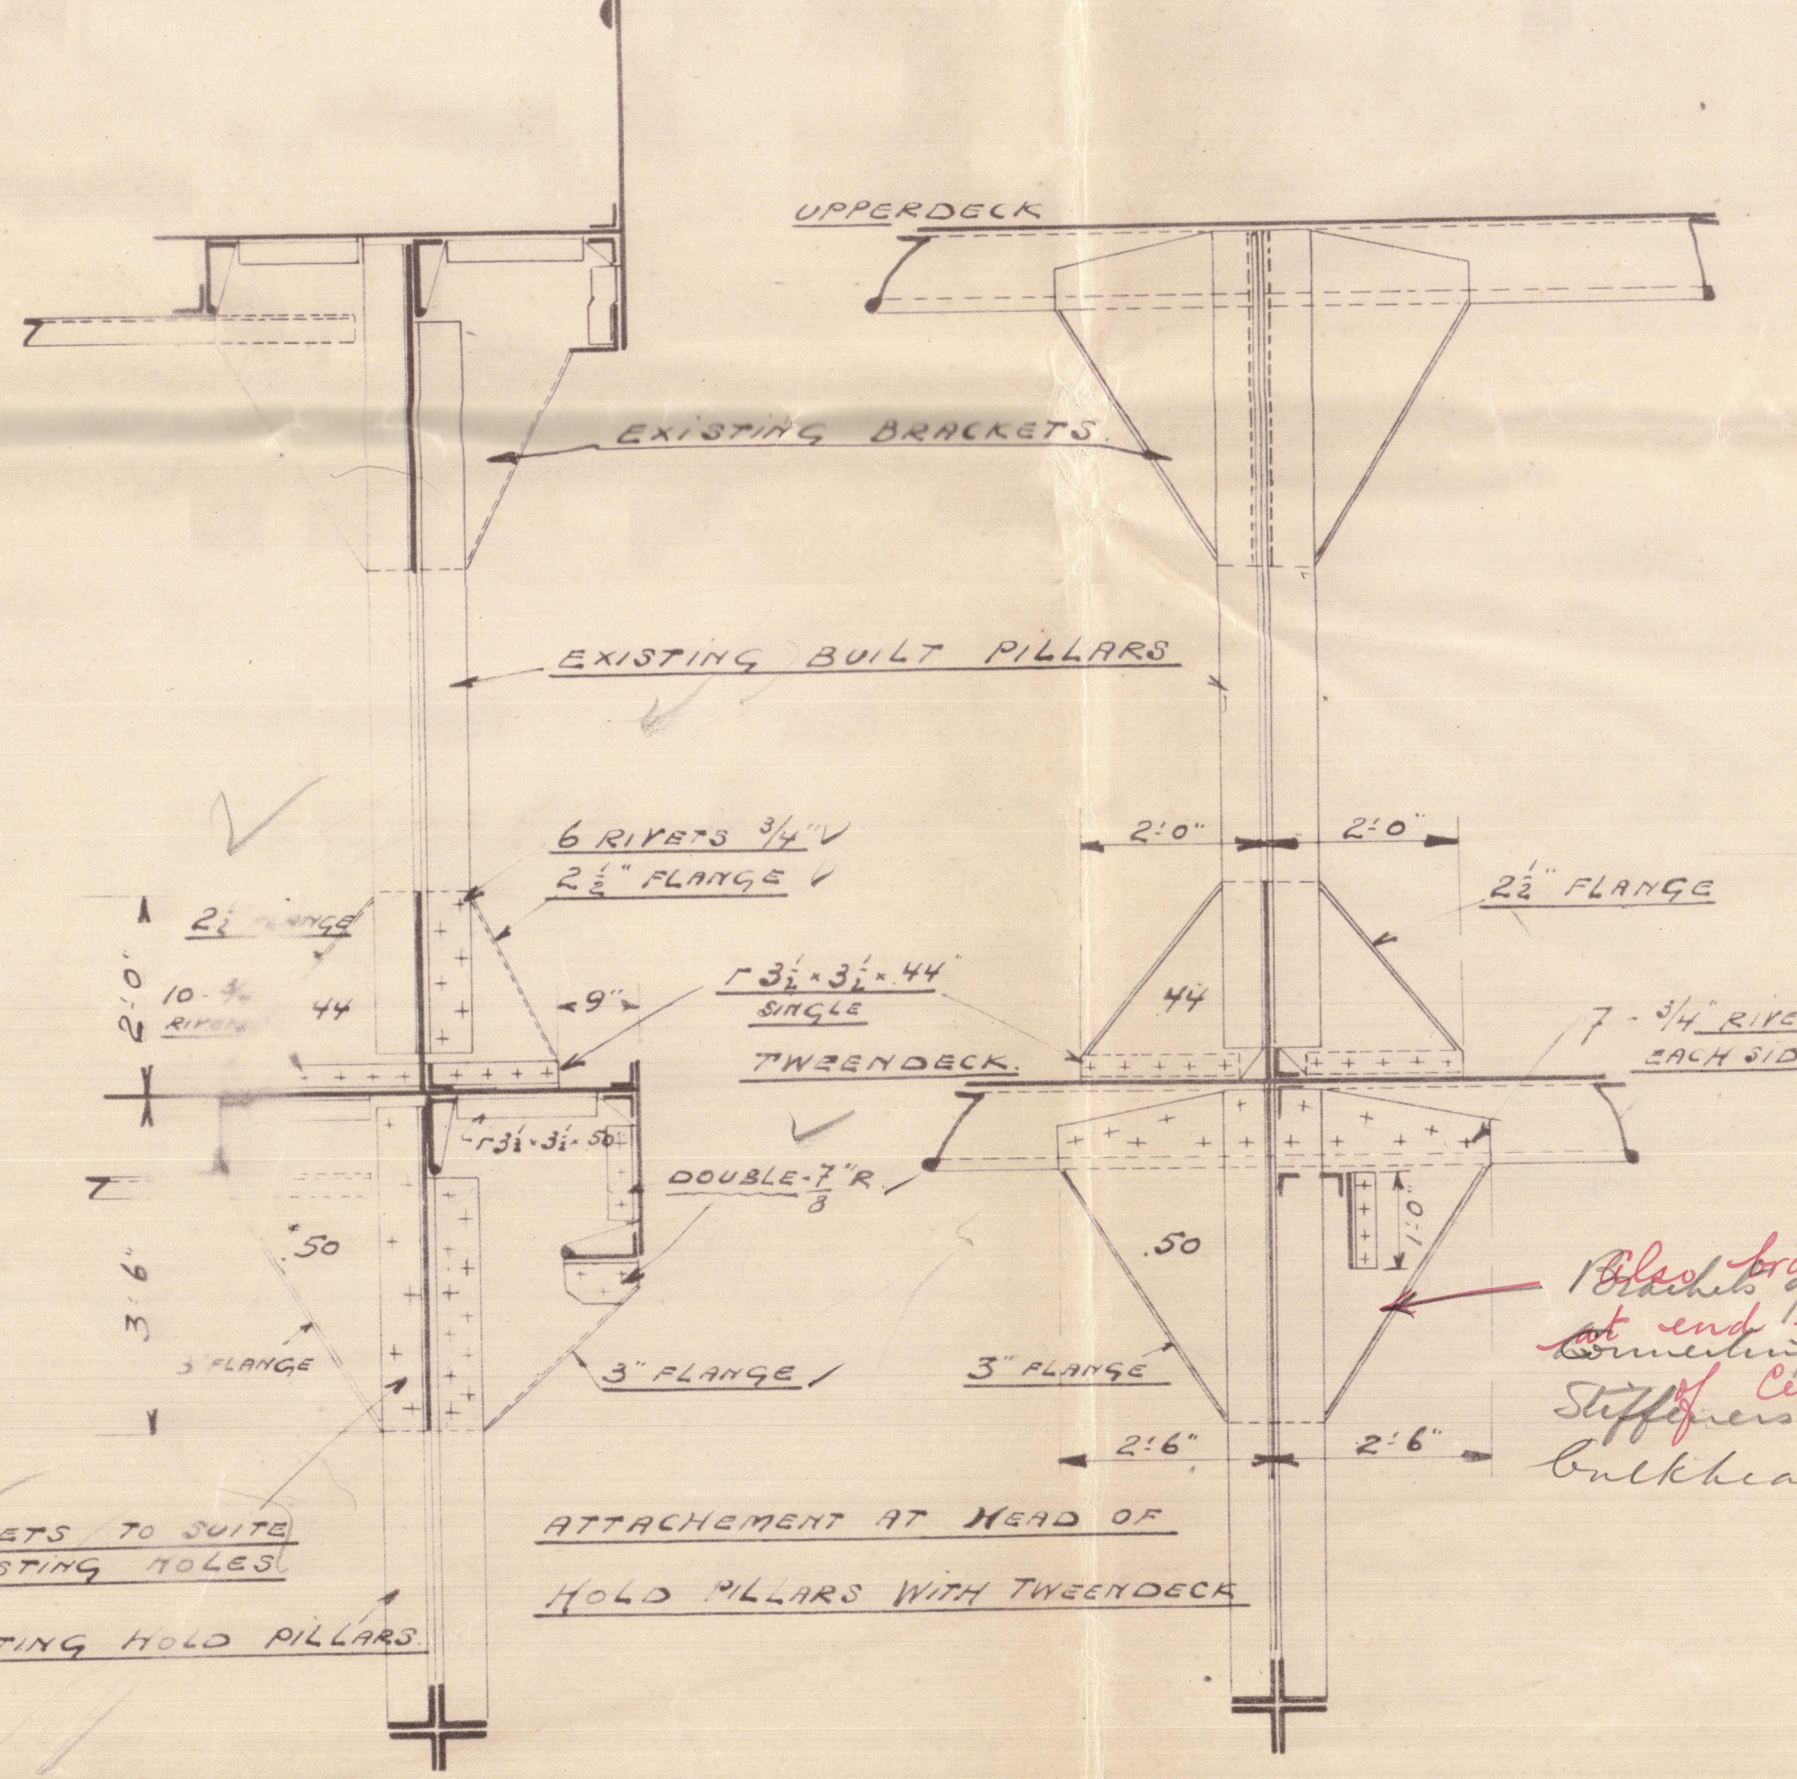


## METHOD ATTACHEMENT OF TWEENDECK PLATING AND BULKHEADS

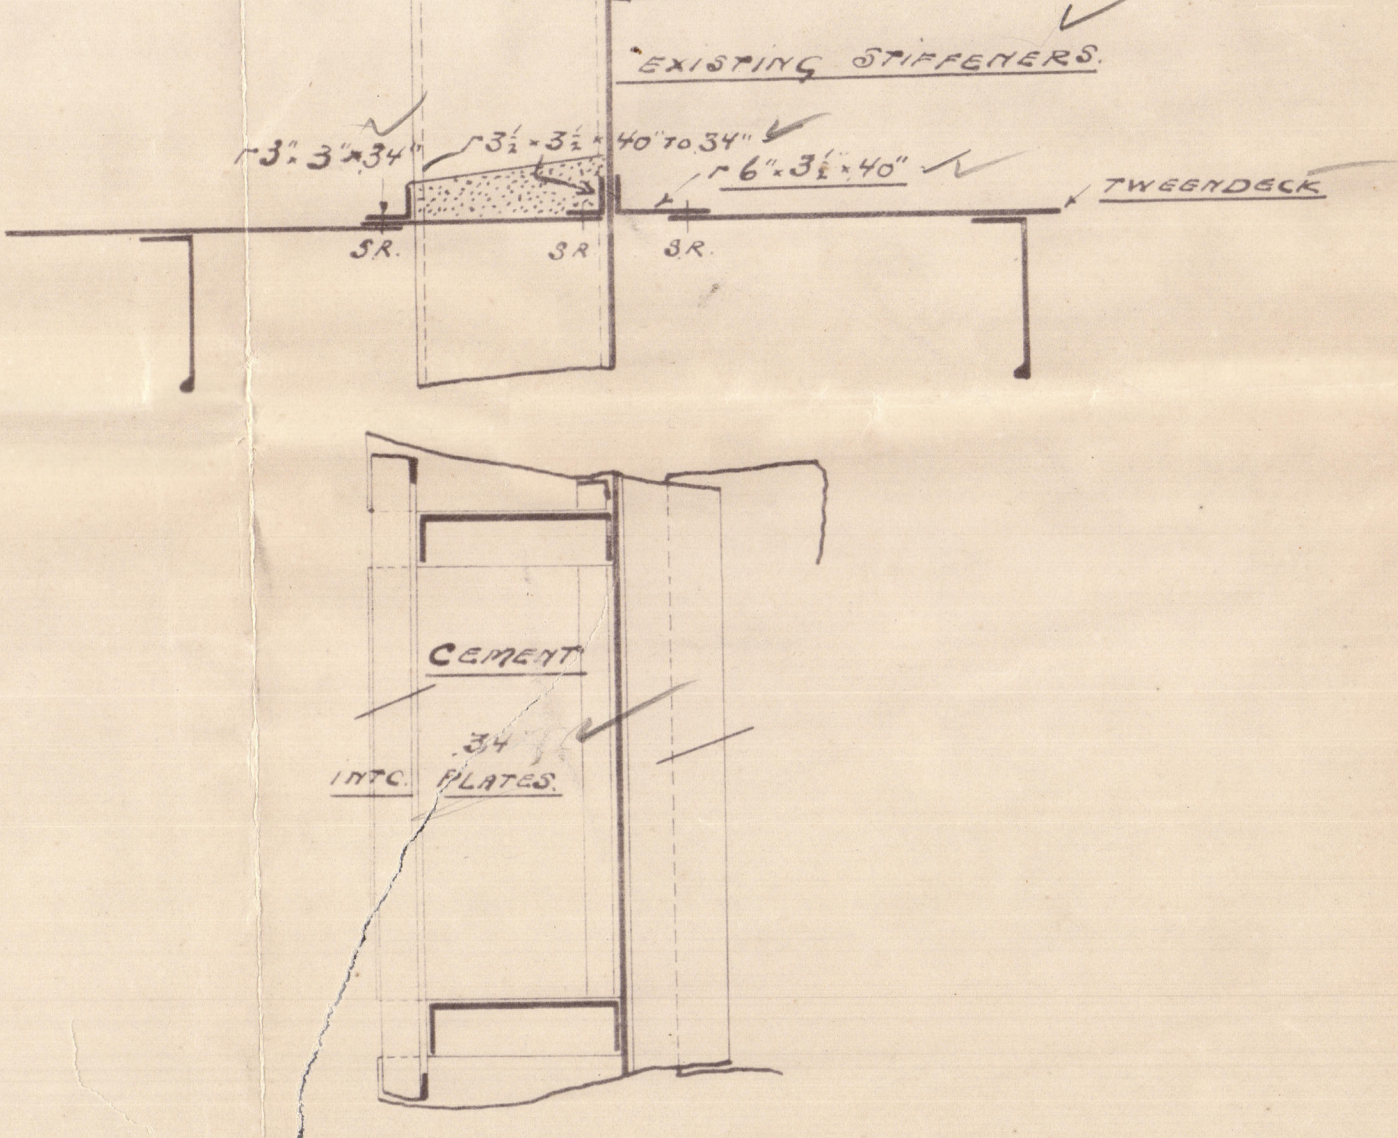

Blue brackets by  
at end of stiffeners  
connecting to large  
stiffeners of center line  
bulkhead

17.9.26

## SECTION IN WAY OF EXISTING CENTRE LINE BULKHEADS

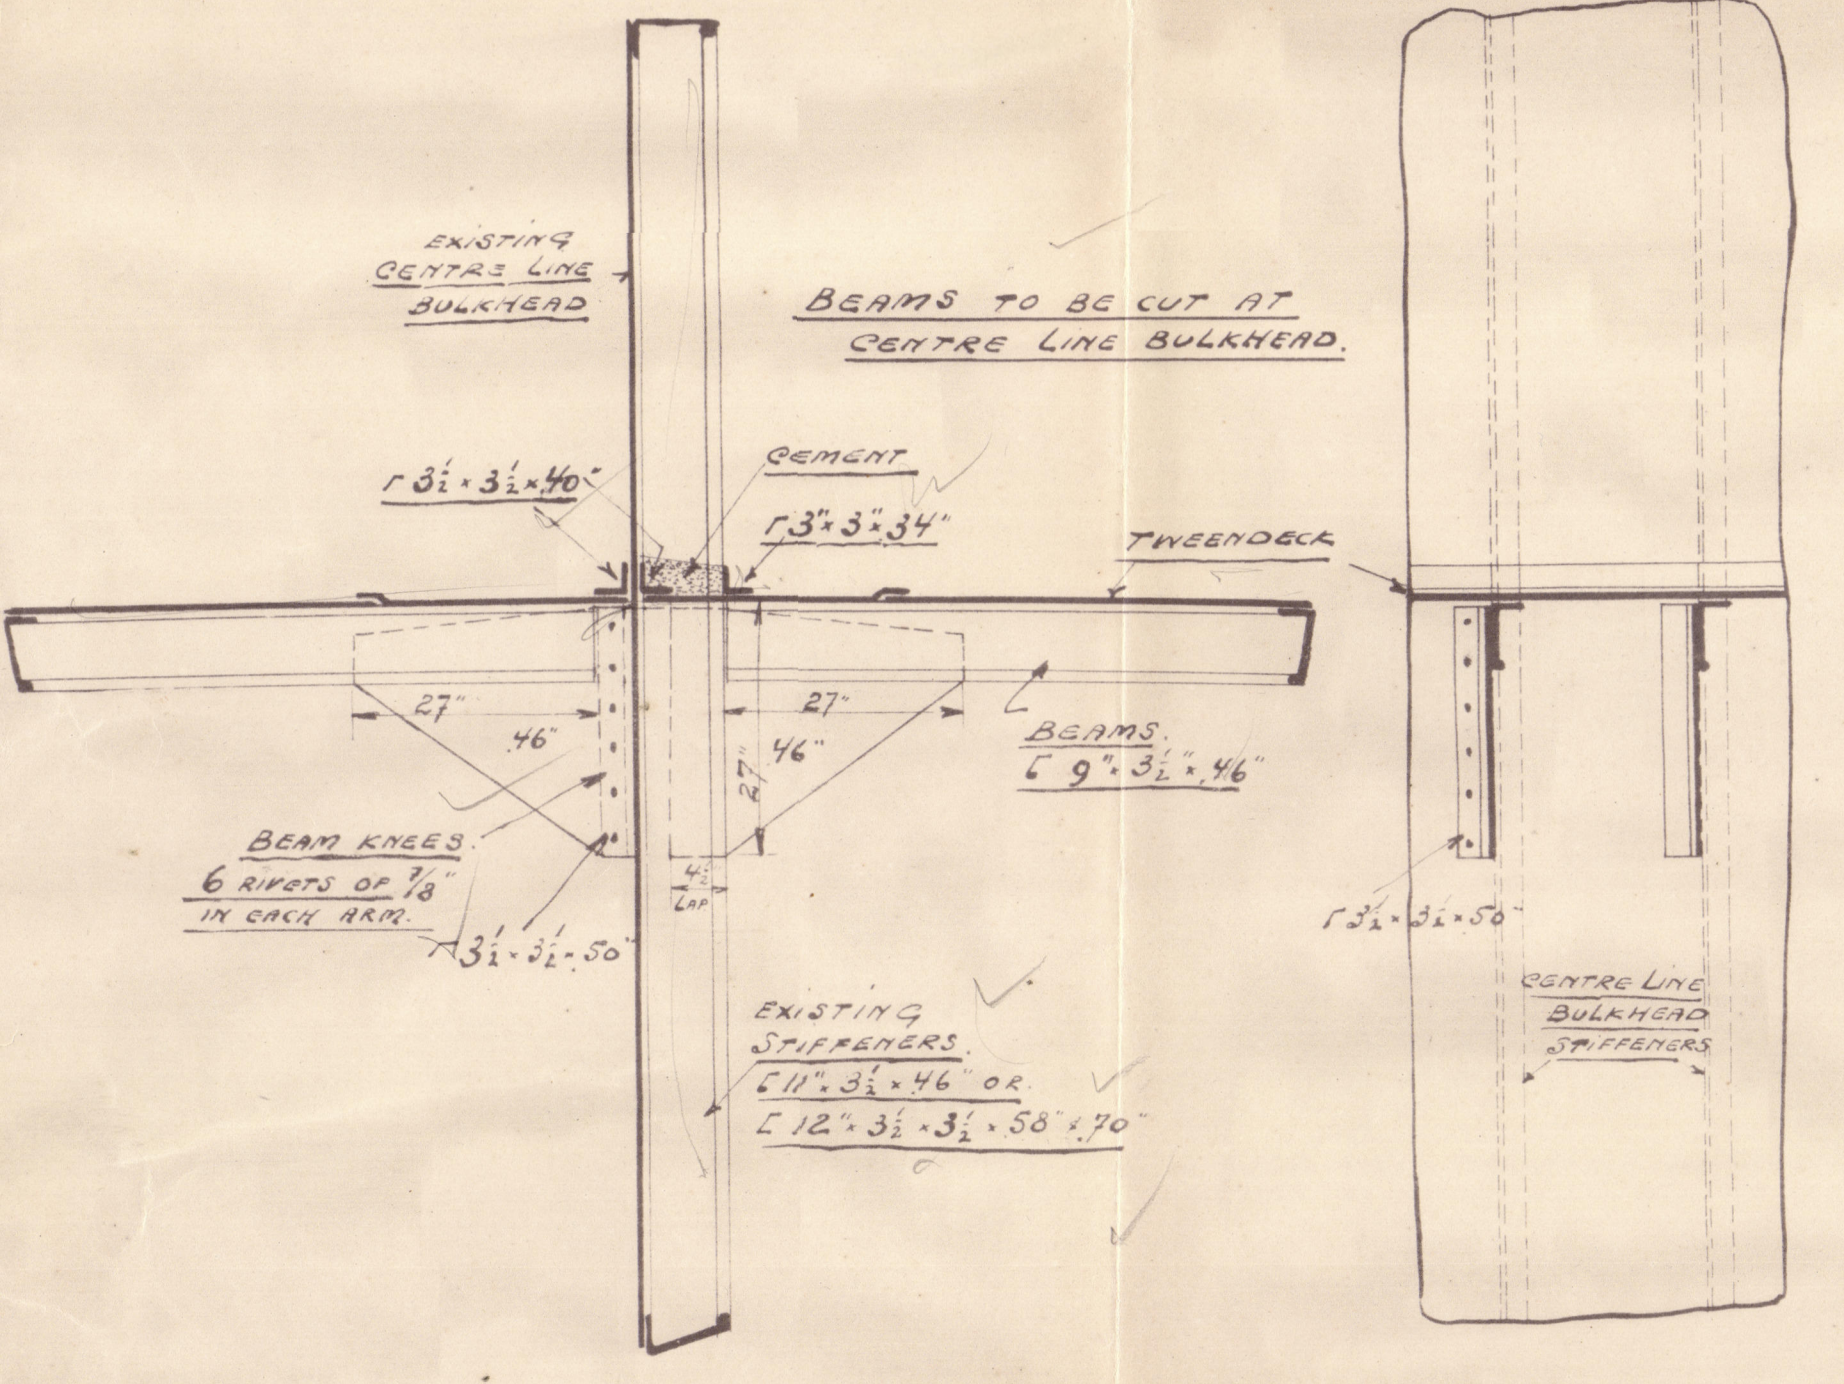

BEAMS TO BE CUT AT  
CENTRE LINE BULKHEAD

EXISTING CENTRE LINE  
BULKHEAD

BEAM KNEES  
6 RIVETS OF  $\frac{7}{8}$ "  
IN EACH AREA

EXISTING STIFFENERS  
OF M1-3-4-5-2145-2146



S/S NERVIER  
DETAIL PLAN OF BRACKETS  
for 2<sup>ND</sup> DECK.

W/55-0036



© 2021

Lloyd's Register  
Foundation