


MIDSHIP SECTION, SHOWING PROPOSED ARRANGEMENT OF WOOD PILLAR

STIFFENING TO MAIN DECK

SCALE 1/2 IN = ONE FOOT

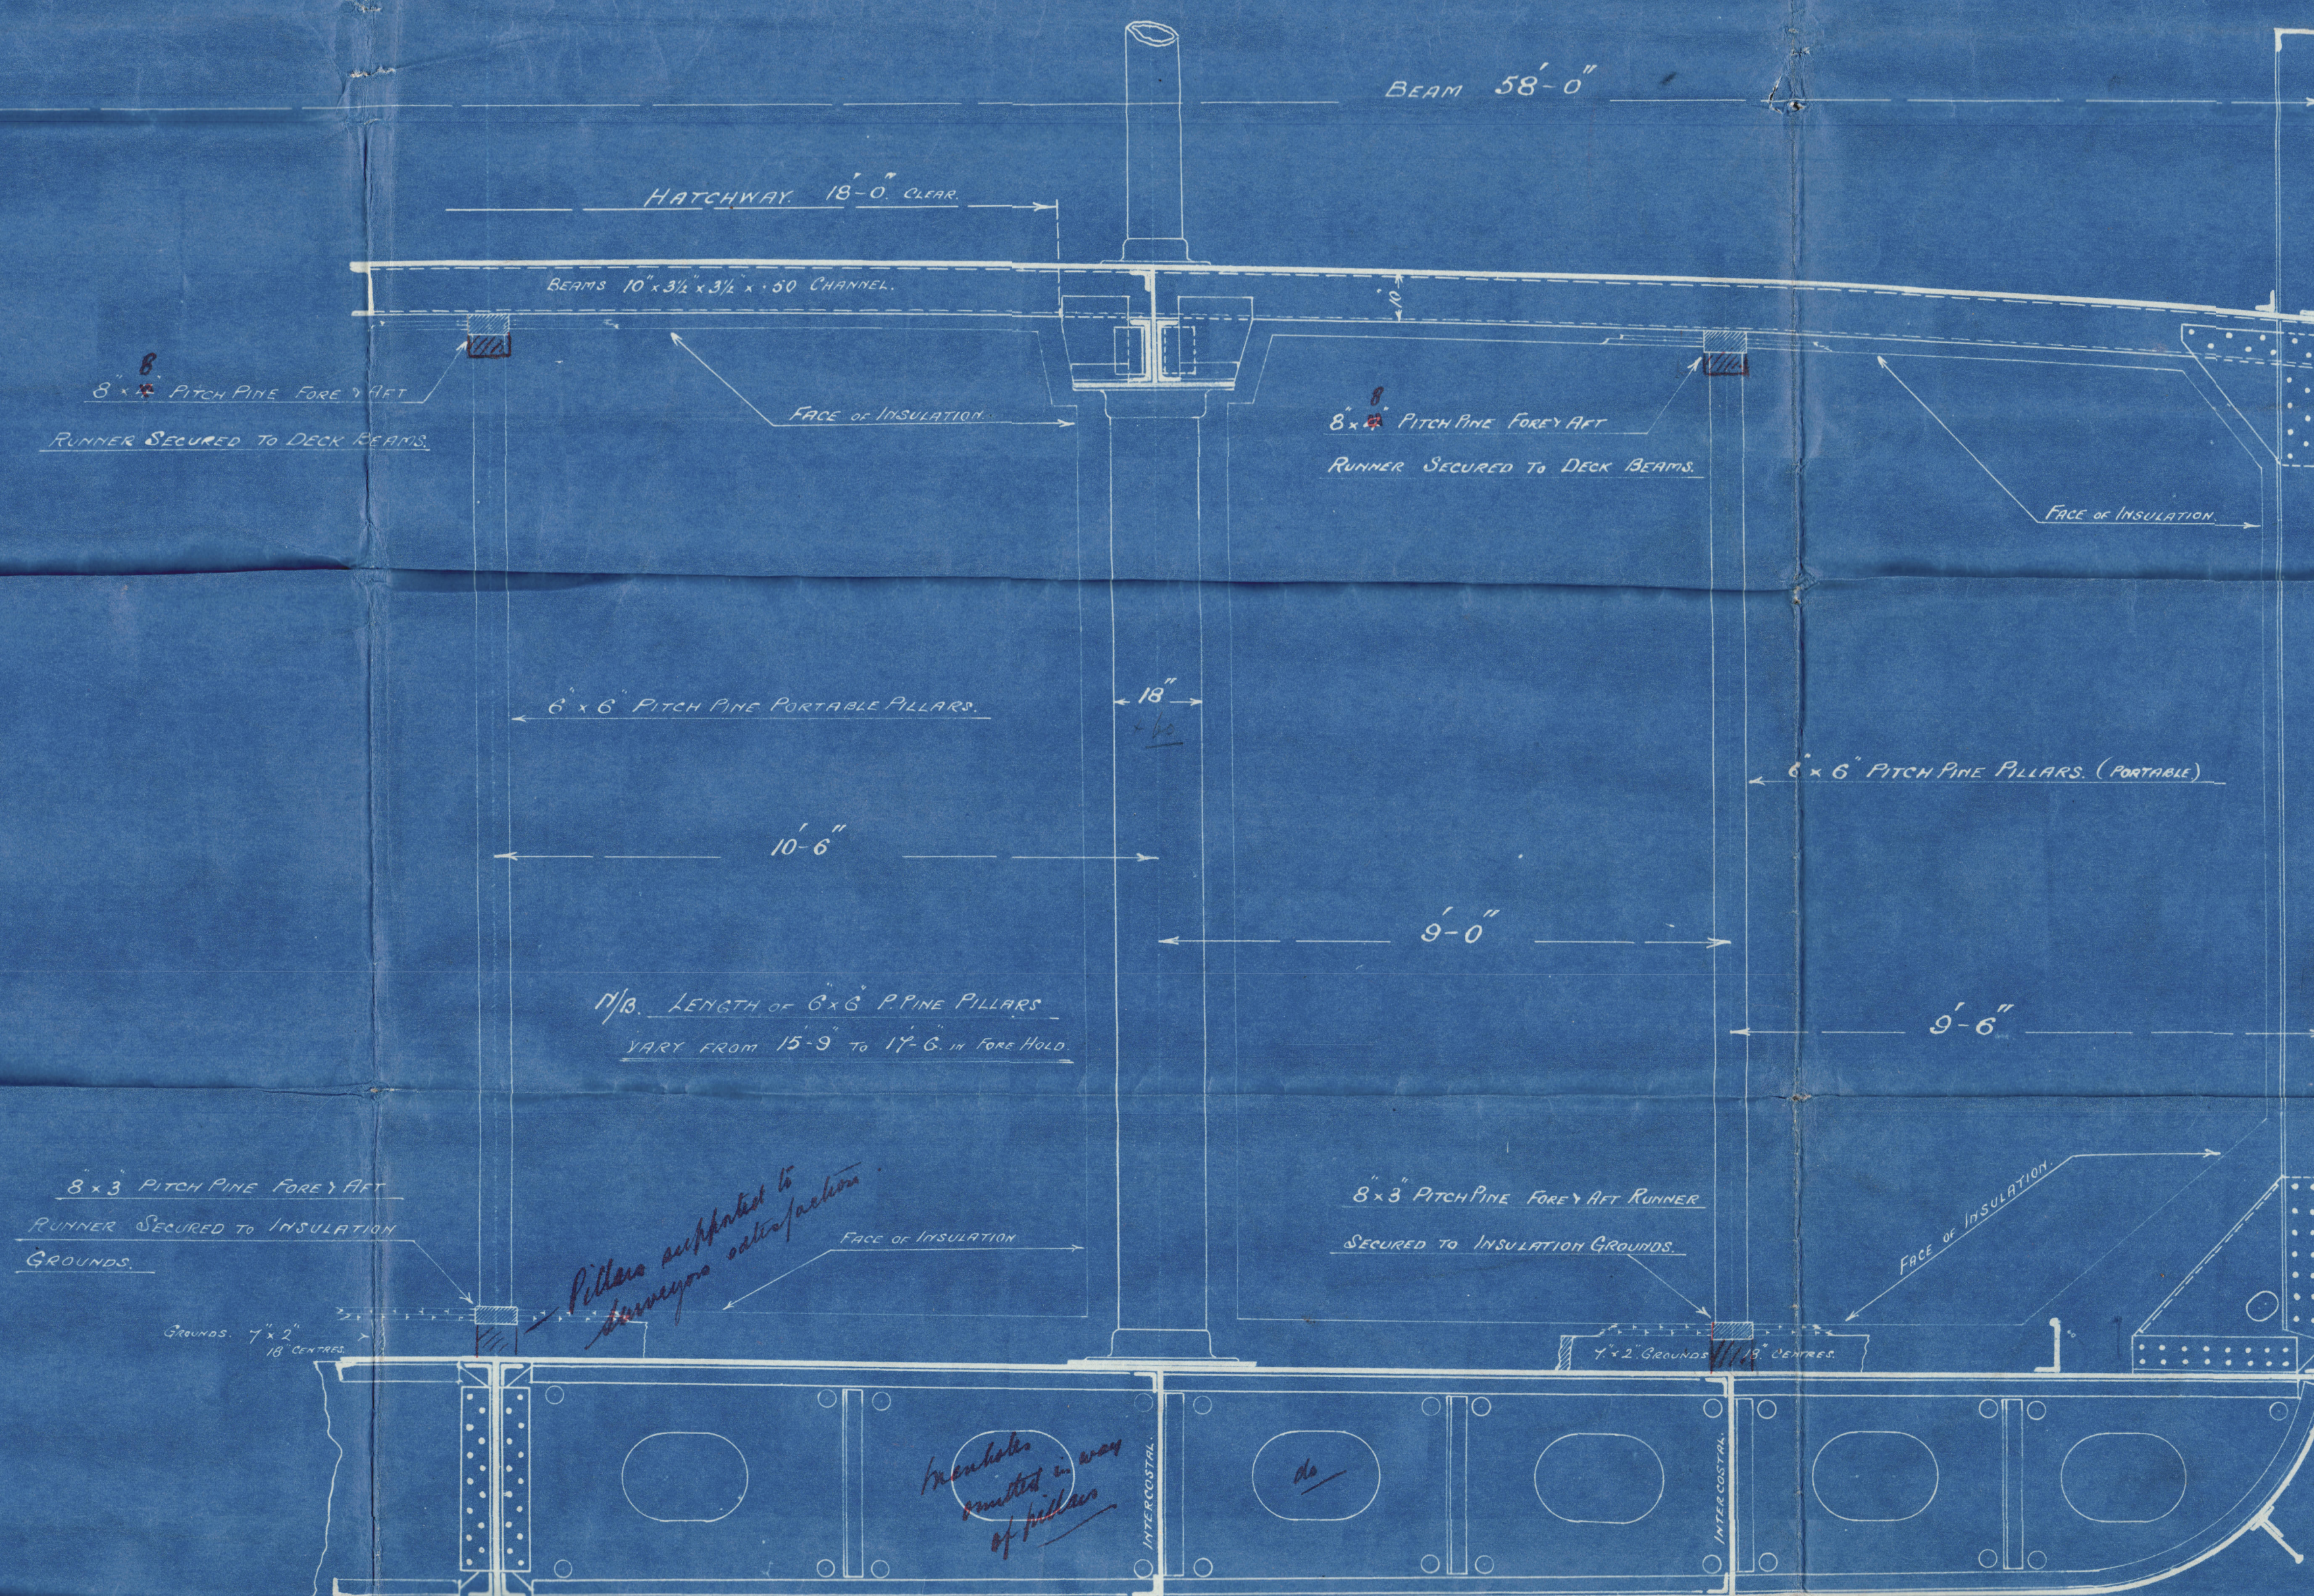

S.S. No 576. (BARCLAY CURLEY & CO LTD)

SKETCH OF PROPOSED WOOD PILLAR STIFFENING OF MAIN DECK BEAMS,

TO ENABLE THE CARRYING OF A GENERAL OR FROZEN CARGO ON THE DECK, AND A HANGING CARGO, OF CHILLED MEAT BELOW.

SCALE 1/8 x 1/2 IN = 1 FOOT

H. & W. NELSON, LIMITED

APRIL 26th 1919

1-1 - 12 Poles
1-2 - 17
1-3 - 16
1-4 - 19
1-5 - 11
Total 75 Poles

29-5-19


2-5 11 Poles

2-4 19 Poles

2-3 16 Poles

1-2 17 Poles

2-1 12 Poles

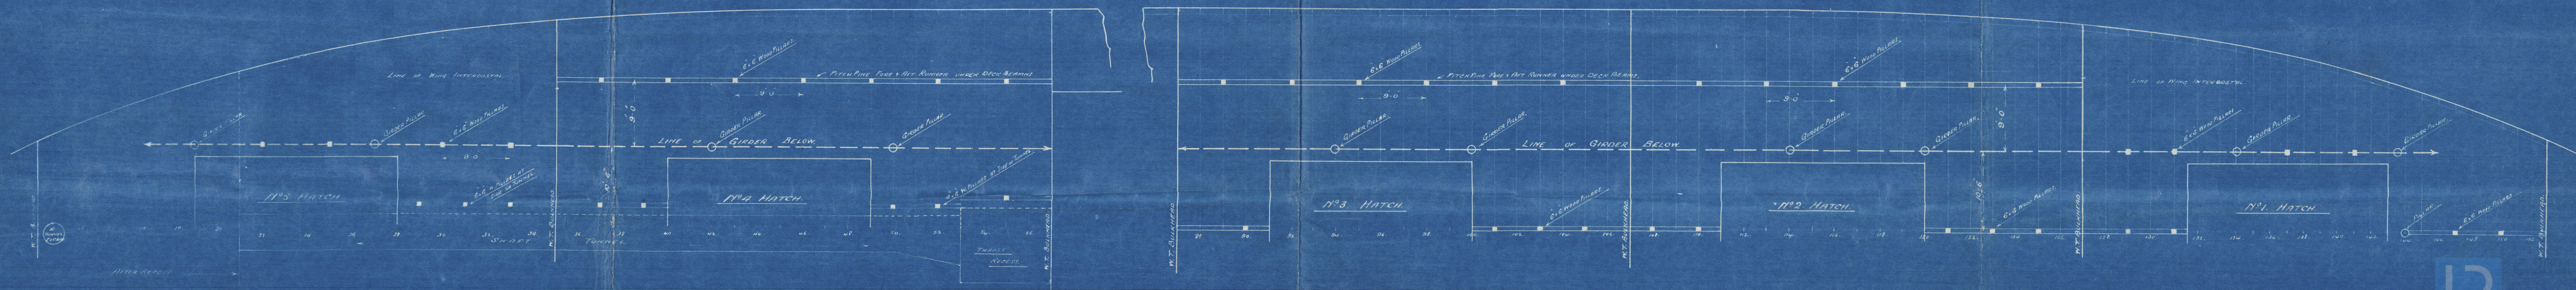

PLAN AT MAIN DECK SHOWING DISPOSITION OF PROPOSED WOOD PILLARS

SCALE 1/8 = ONE FOOT

576

Wood Girders
&
Beams

Highland Warrior

W 55-0199

Barclay Bank B.L.

N^o 576

Highland Warrior
Wood pillars & girders

S.S. "Highland Warrior"

LIVERPOOL

Report No. 82032

W 55-0199



© 2021

Lloyd's Register
Foundation