



MIDSHIP SECTION

DIMENSIONS 450'-0" x 58'-0" x 40'-0" MLD

SCALE: $\frac{1}{2}$ " = ONE FOOT.

Nº 576

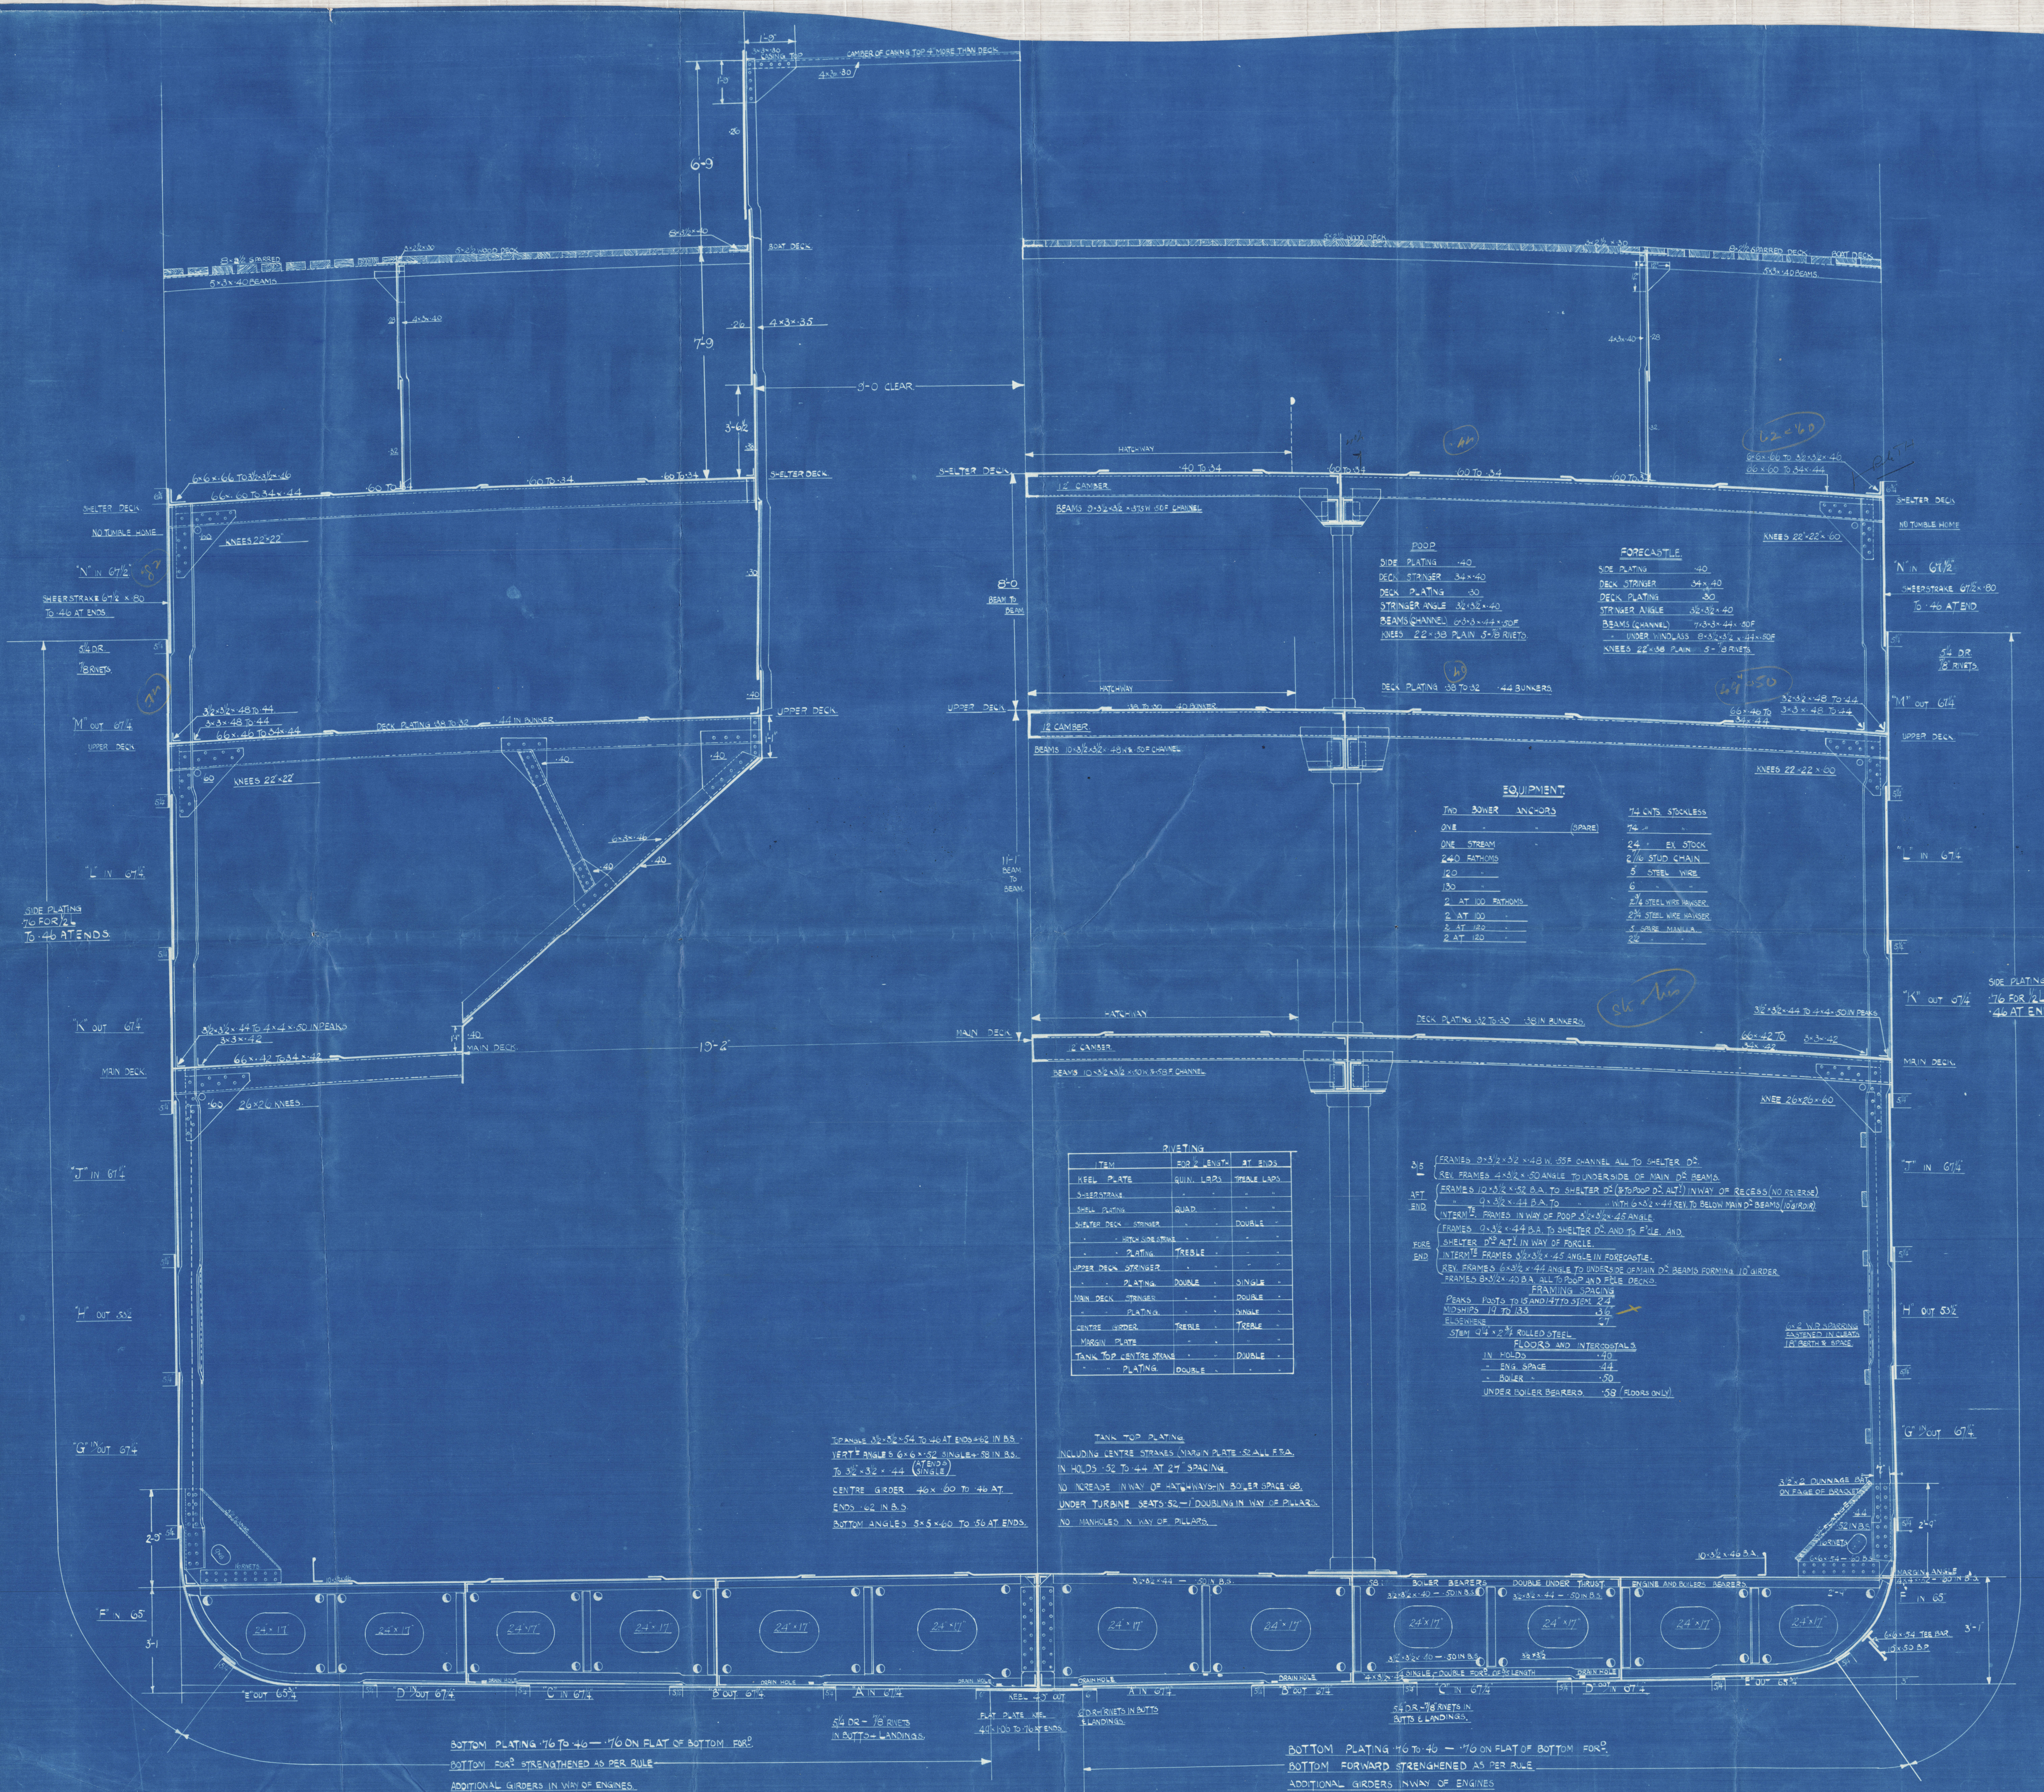


[illegible]

SPAN ONE $3\frac{1}{2} \times 3\frac{1}{2} \times 54$ TO 46 AT ENDS $= 62$ IN B.S.
VERT^L ANGLES $6 \times 6 \times 52$ SINGLE $+ 58$ IN B.S.
TO $3\frac{1}{2} \times 3\frac{1}{2} \times 44$ ($\frac{5 \text{ ENDS}}{\text{SINGLE}} \text{)}$
CENTRE GIRDER 46×60 TO 46 AT
ENDS $= 62$ IN B.S.
BOTTOM ANGLES $5 \times 5 \times 60$ TO 56 AT ENDS

TANK TOP PLATING
INCLUDING CENTRE STRAKES (MARGIN PLATE - SPALL FREE
IN HOLDS - 52 TO 44 AT 24" SPACING.
NO INCREASE IN WAY OF HATCHWAYS - IN BOWLER GEAR.
UNDER TURBINE SEATS - 1 DOUBLING IN WAY OF PILLARS
NO MANHOLES IN WAY OF PILLARS.

BOTTOM PLATING .76 TO .46 - .76 ON FLAT OF BOTTOM FOR
BOTTOM FOR STRENGTHENED AS PER RULE -
ADDITIONAL GIRDERS IN WAY OF ENGINES.

BOTTOM PLATING #6 TO #6 - #6 ON FLAT OF BOTTOM FOR
BOTTOM FORWARD STRENGTHENED AS PER RULE
ADDITIONAL GIRDERS INWAY OF ENGINES

Midship Section

Barclay Curle & Co. Ltd

No 576.

S/S "HIGHLAND WARRIOR"

GLASGOW REPORT No. 40215

W55-0239



© 2021

Lloyd's Register
Foundation