

DEC. 1916

No. 15317.

24943

Lloyd's Register of Shipping.

SURVEYS FOR FREEBOARD - STEAM SHIPS.

PARTICULARS RELATING TO ALL STEAM SHIPS EITHER FLUSH DECKED, OR WITH TOP GALLANT FORECASTLES, SHORT POOPS AND BRIDGE HOUSES DISCONNECTED, OR WITH TOP GALLANT FORECASTLES HAVING LONG POOPS, OR RAISED QUARTER DECKS CONNECTED WITH BRIDGE HOUSES, OR OTHERWISE.

Port of Survey WEST HARTLEPOOL.Date of Survey White building.Name of Surveyor D. McQuolan.Imp. James S. B. & D. D. O. S.S. No. 556.

Ship's Name.

"KEPWICK HALL"

Port of Registry and Nationality.

Official Number.

Gross Tonnage.

Date of Build.

Particulars of Classification.

Number in Register Book 21 Sup.139223.4601916100A.1. Shelter deck with feet.
(contemplated)

Registered dimensions from Ship's Register.	LENGTH.	BREADTH.	DEPTH.	UNDER DECK TONNAGE.
	<u>380.0'</u>	<u>51.45'</u>	<u>23.75'</u>	<u>3826.78</u>
Length on LOADLINE.	<u>379.66</u>	Frame Depth $\frac{1}{2}$ Rule <u>51.45'</u>	Ceiling $+ .20'$ Sheer $+ 1.22'$ <u>$+ .25'$</u>	Peak Tanks <u>9 mtd.</u>
CORRECTED DIMENSIONS.	<u>379.66</u>	<u>50.62</u>	<u>25.37</u>	<u>3826.78</u>

Moulded Depth as measured..... 26'-3"

NOTE. - If the depth is measured when vessel is afloat, the details of measurement should be reported.

Co-efficient of fineness..... .78 ✓
Any modification necessary [Para. 4 (a) to (e)]* See. 5B.
Co-efficient as corrected76 ✓

Sheer { Stem..... 120 } 180 $\div 2 = 90$... Mean 91.8
at { Sternpost ... 60 } 47.97
36 43.83
1.22
Sheer at $\frac{1}{8}$ of the length from { Stem 68
Sternpost 33 } 101 $\div 2 = 50.5$... Mean
Gradual mean Sheer 90.9 90.19 $\div 55 = 90.19
Standard mean Sheer [Table, Para. 18] 47.97 Correction
Difference..... 42.93 42.22 $\div 4 =$
-10 1/2 3/4
§ If limited as Para. 18 (f).....$

Rise in Sheer { At front of bridge house..... ✓
from amidships [Para. 18 (e)] { At after end of forecastle

Fall in Sheer { Para. 18 (d) } $\div 2 =$ ✓
Length uncovered Correction

ALLOWANCE FOR DECK ERECTIONS :-

Freeboard, Table C..... 3'-0" ✓
Correction for Length, if required (Para. 12, 13, and 14)
Freeboard by Table A, corrected for sheer, and for length, if required (Para. 12, 13, and 14) 5'-1 1/2
Difference 2'-1 1/2
Percentage as below..... 94.3 94.2%
= 24.256
24.04

Correction for R. Q. Dk. if engine and boiler openings not covered by bridge house (Para. 11)
Allowance for Deck Erections 24 1/2

	Length.	Length allowed.	Height.
Forecastle.....	<u>344.4</u> $+ 1'-0"$ <u>overhang</u>	<u>345.16</u> $\times 8-0$	
Bridge House.....	<u>4.25'</u>		
Poop.....	<u>29'-0"</u> $+ 1'-0"$ <u>overhang</u>	<u>29.50</u> $\times 8-0$	
Total	<u>379.66</u>	<u>374.66</u> $= \frac{1}{2}$ Diff.	
Length of Ship		<u>377.78</u> $= .992$	
Corresponding percentage (Para. 11, 12, 13, or 14) {	<u>= 94.3%</u>		

FREEBOARD recommended amidships from centre of Disc to top of Statutory Deck Line, Wood (Iron) Deck :-

Fresh Water Line	above centre of Disc	...
Indian Summer Line	" " "	...
Winter Line	below " "	...
Winter North Atlantic Line	" " "	...

CORRECTION FOR LENGTH.
Length of Ship on Loadline..... 379.66
Length in Table 315.00
Difference 64.66
Correction for 10ft., Table A. 1.44 Table C.
 \times Difference divided by 10 9.05 (if required.)
If $\frac{1}{10}$ ths length covered divide by 2 + 4 1/2"

CORRECTION FOR IRON DECK.
Proportion covered, if less than $\frac{1}{10}$ ths length covered
Thickness of usual wood deck, less stringer - 3 1/2"

CORRECTION FOR ROUND OF BEAM.
Breadth at Gunwale amidships..... 49'-8"
Round of Beam 12 1/4"
Normal round..... 12 1/2
Difference 1/4 $\div 2 =$ ✓
Proportion of Deck uncovered (Para. 19)

NOTE. - The round of beam should be reported on the full breadth of vessel at the gunwale.

Freeboard, Table A	<u>6'-0 1/4"</u> ✓
Correction for Sheer	<u>10 1/2 3/4</u>
Correction for Length	<u>4 1/2</u> ✓
Allowance for Deck Erections	<u>5'-6 1/2</u>
Correction for Round of Beam.....	<u>2'-0 1/2</u> ✓
Correction for fall in Sheer (if any).....	<u>3'-6</u> ✓
Correction for Iron Deck (if required)	<u>3'-2 1/2</u> ✓
Additions for non-compliance with provisions of Para. 11 (d) and (e) ‡	
Other Corrections (if any)	

Winter Freeboard	<u>3'-2 1/2"</u> ✓
Summer Freeboard	<u>2'-9 1/4</u> ✓
Indian Summer Freeboard	<u>2'-4</u> ✓
N. A. Winter Freeboard	
Correction necessary because clearside amidships, measured in accordance with the Statute is not taken at the intersection of the wood or iron deck with side.	<u>+ 1 3/4"</u> ✓

Winter Freeboard from deck line	<u>3'-4 1/4"</u> ✓
Summer " " " "	<u>2'-11</u> ✓
Indian Summer " " " "	<u>2'-5 3/4</u> ✓
N. A. Winter " " " "	

+ State dimensions of freeing port area on back of this form.

* The Surveyor should state whether the fall in sheer as reported is measured relatively to the straight line of keel or to the water line. If measured relatively to water line the vessel's draft at time of survey, and also the usual load draft forward and aft, should be reported.

Do all the Frames extend to the top height in the Poop? *Yes.* Raised Quarter Deck? *Yes.* Bridge House? *Yes.* Forecastle? *Yes.*

To what height do the Reverse Frames extend? *B.A. Framing.*

Has the Poop or Raised Quarter Deck an efficient Iron Bulkhead at the fore end? *Yes.*

Give particulars of the means for closing the openings in Bulkhead *No openings.*

Is the Poop or Raised Quarter Deck connected with the Bridge House? *Yes.* Has the Bridge House an efficient Bulkhead at the fore end? *Complete Shelter Deck.*

Give particulars of the means for closing the openings in Bulkhead

What is the thickness of the Bridge Front plating? *✓* and Coaming plate? *✓*

Give scantlings and spacing of the Stiffeners *✓*

Are bracket plates fitted at each end of the Stiffeners? *✓* Are hor'l. brackets fitted connecting Bridge Bulk'd. with Bulwarks? *✓*

Has the Bridge House an efficient Iron Bulkhead at the after end? *Yes.*

How are the openings closed? *Storm boards, full height, in permanent channel.*

Is the Forecastle at least as high as the main or top-gallant rail? *✓* Has the Forecastle an efficient Iron or Wood Bulk'd. at after end? *✓*

Are the Engine and Boiler openings covered by a Bridge, Poop, Raised Quarter Deck, or enclosed by a Strong Iron or Steel Deckhouse? *✓*

If the openings are not so protected are the exposed parts of the Casings efficiently constructed? *✓*

Give thickness of plating; scantlings and spacing of Stiffeners *✓*

What is the height of the exposed Casings? *✓* Are suitable means provided for closing all openings in them in bad weather? *✓*

Are the Weather Deck Hatchways efficiently constructed and at least equal to the requirements of Section 28 of the Rules for 1904-5? Give particulars below:— *Yes.*

Position and Size.		<i>H-1 = 24'-5 1/2" x 17'-11"</i>		<i>H-2 = 26'-5 1/2" x 17'-11"</i>		<i>H-3 = 26'-6" x 17'-11"</i>		<i>H-4 = 24'-5" x 17'-11"</i>		Ship.
Item.		Ship.	Rule.	Ship.	Rule.	Ship.	Rule.	Ship.	Rule.	
COAMING	Height above top of DECK	30"		30"		30"		30"		
	Thickness	Sides.....		48		48		46		
		Ends.....		40		40		40		
SHEETING BEAMS ON WEB PLATES.	Number	4		5		5		4		
	Section and Scantlings	7" 21-16" x 34		7" 18-14" x 34		AS PER N° 2.		AS PER N° 1.		
	Material	STEEL		4 Angles 4 x 3 x 40		DITTO.				
* FORE AND AFTERS.	Number									
	Section and Scantlings									
	Material									
HATCHES Thickness		3"								
Remarks.....		Solid				DITTO.				

* When the Fore and Afters are of wood the depth should be stated from the underside of the hatches.

(If the sill of the lowest side scuttle will be less than 6 inches above the Indian Summer Load Line if assigned under the tables, state vertical distance from top of deck at side amidships to lower edge of lowest side scuttle.)

The following information is to be given in all Cases of vessels dealt with under Paras. 11, 12 (under 15 feet moulded depth) and under Shelter Deck Rule.

What is the thickness of the Bridge Sheerstrake? *726.44* Strake between Main and Bridge Sheerstrakes? *646.44*

Delete the words { The Crew are, are not, berthed in the bridge house.


that do not apply { The arrangements to enable them to get backwards and forwards from their quarters are, are not satisfactory.

Length of Bulwarks in well

Area of Freeing Ports required by Para. 11 (e) each side of vessel = Sq. ft.

Ft.	Tenths.	Ft.	Tenths.	No.	Freeing Ports (each side of vessel)	=	Sq. ft.
x		x					
x		x					

Total deficiency or excess = Sq. ft.

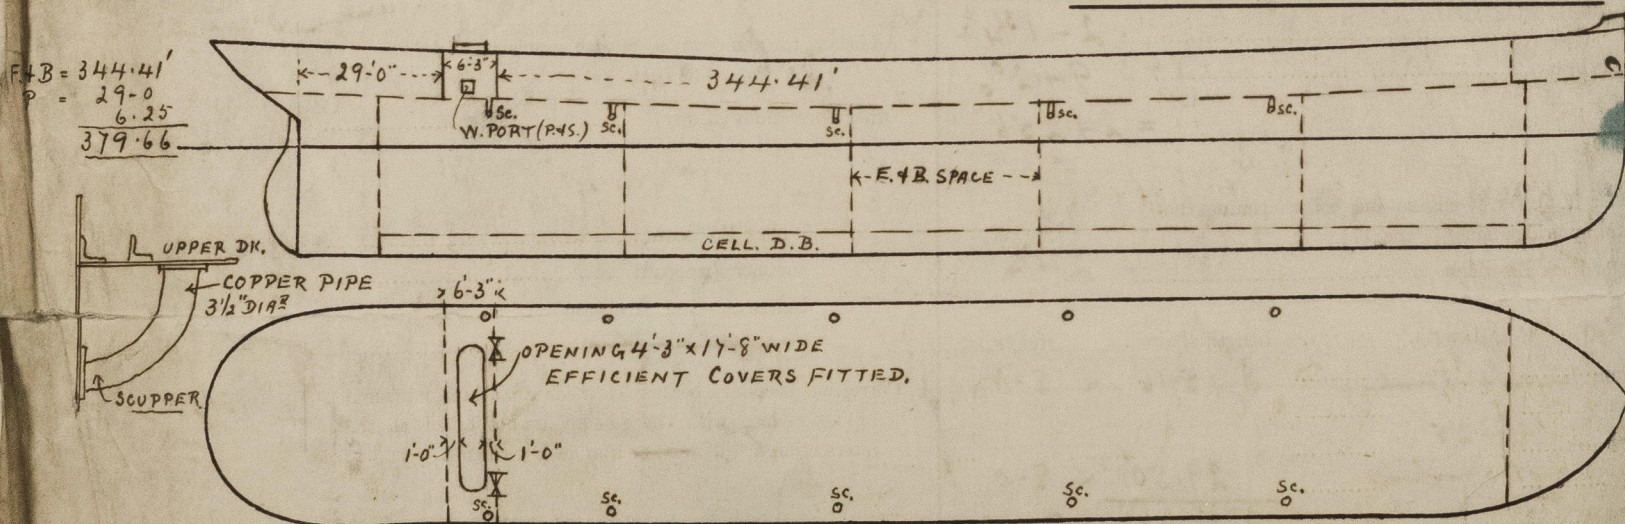

Show hereon line of Floors or Tank Top with position of any Breaks in same; also height of Peak Tank tops, &c., &c.

State any special features in the construction of the Vessel: *Complete Shelter deck with one tonnage open cellular double bottom & deep framing; Cleanse Secondary Shelter (M) 12' Deck.*

The approved midship section & profile & deck plans are forwarded herewith.

Owners

Address

Fee

Received by me