



S. S. 'Hepworth Hall'

Sketch A (as at present) Hatch Covers.

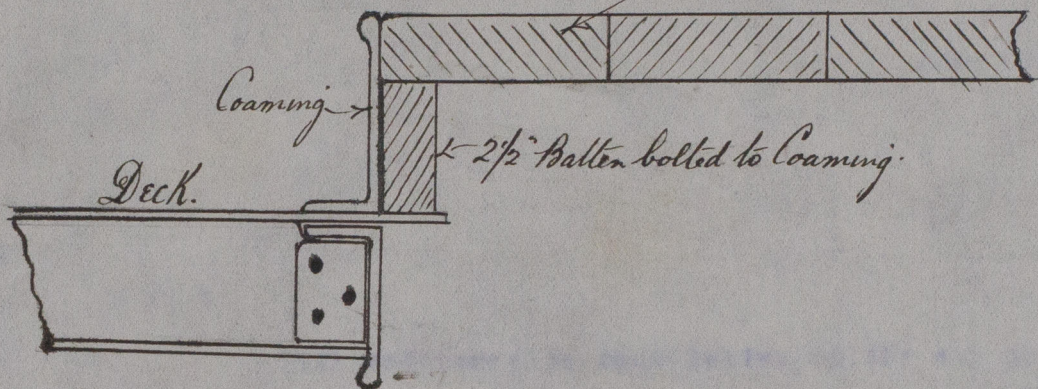

Sketch B (as proposed.)

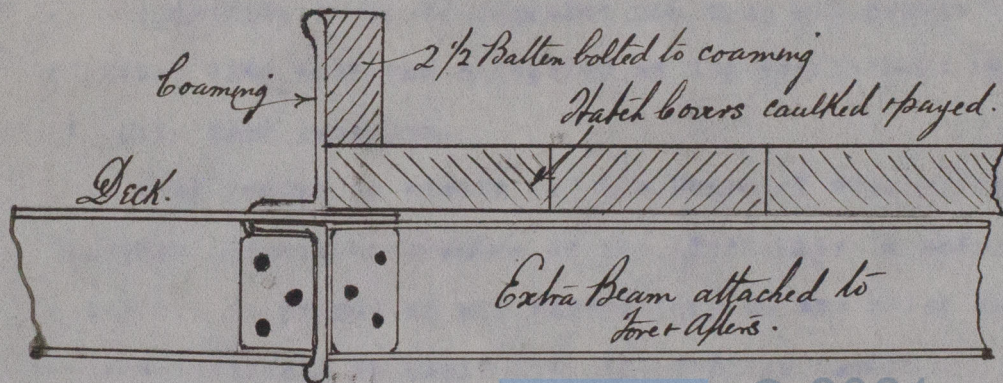

© 2021

Lloyd's Register
Foundation

WS51-0201