
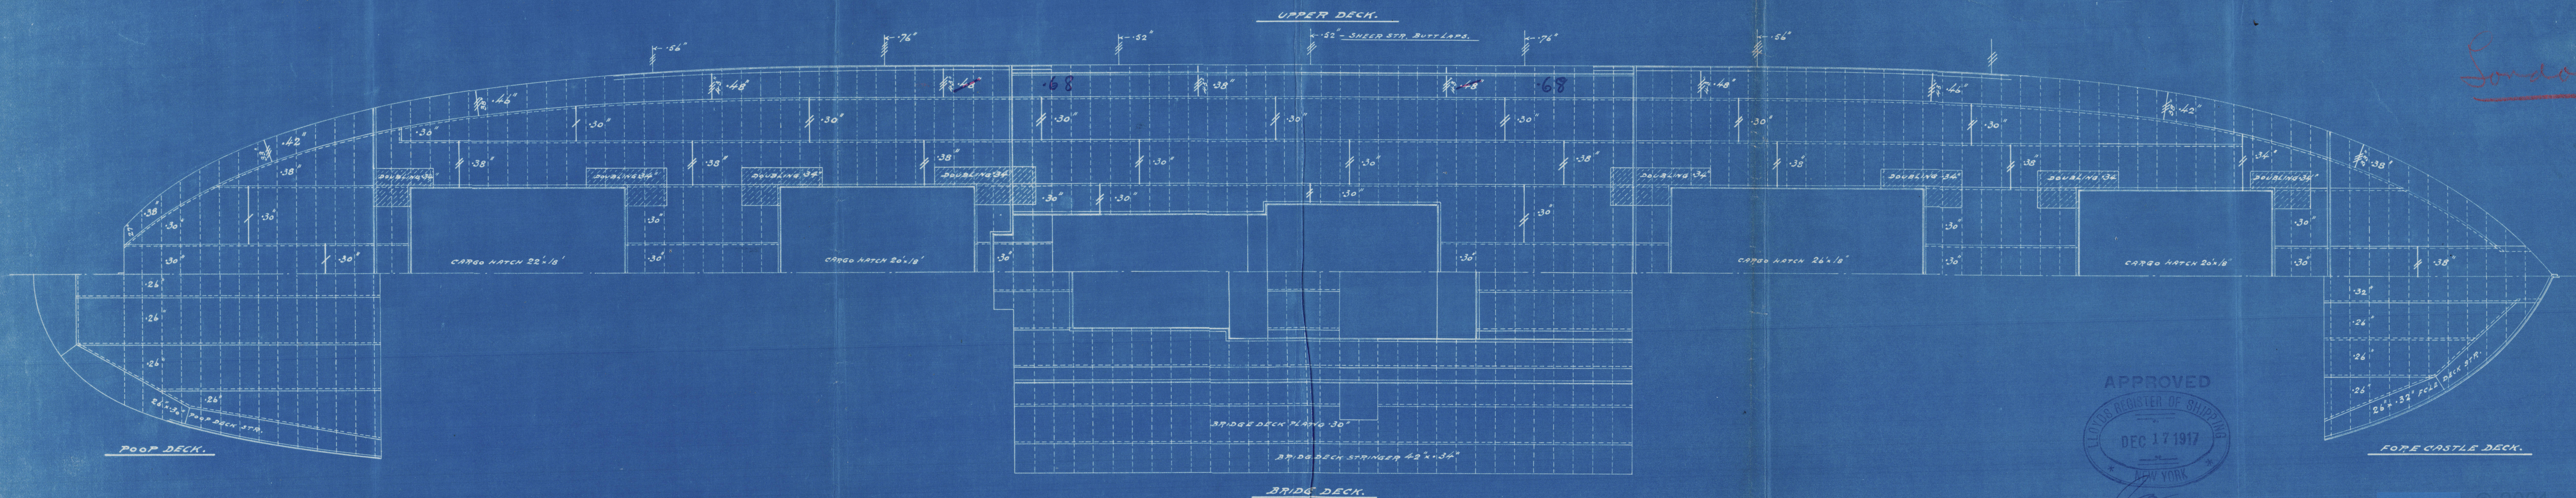


CONSTRUCTION DIAGRAM
FOR
SINGLE DECK GENERAL CARGO STEAMER
LLOYD'S CLASS #100A1.
SCALE: 1/8" = 1 FOOT.
LENGTH OVER ALL..... 261.0 FEET
LENGTH BETW. PERPS..... 251.7 FEET
BREADTH MOULDED..... 43.6 FEET
DEPTH MOULDED..... 23.0 FEET
CANADIAN ALLIS-CHLMERS LIMITED.
TORONTO ONT.

Gen Box 2372
SHIPS NOS: 300, 301, 302, AND 303.
Gen Box 2372
"War Vesen"
Buff. 69.

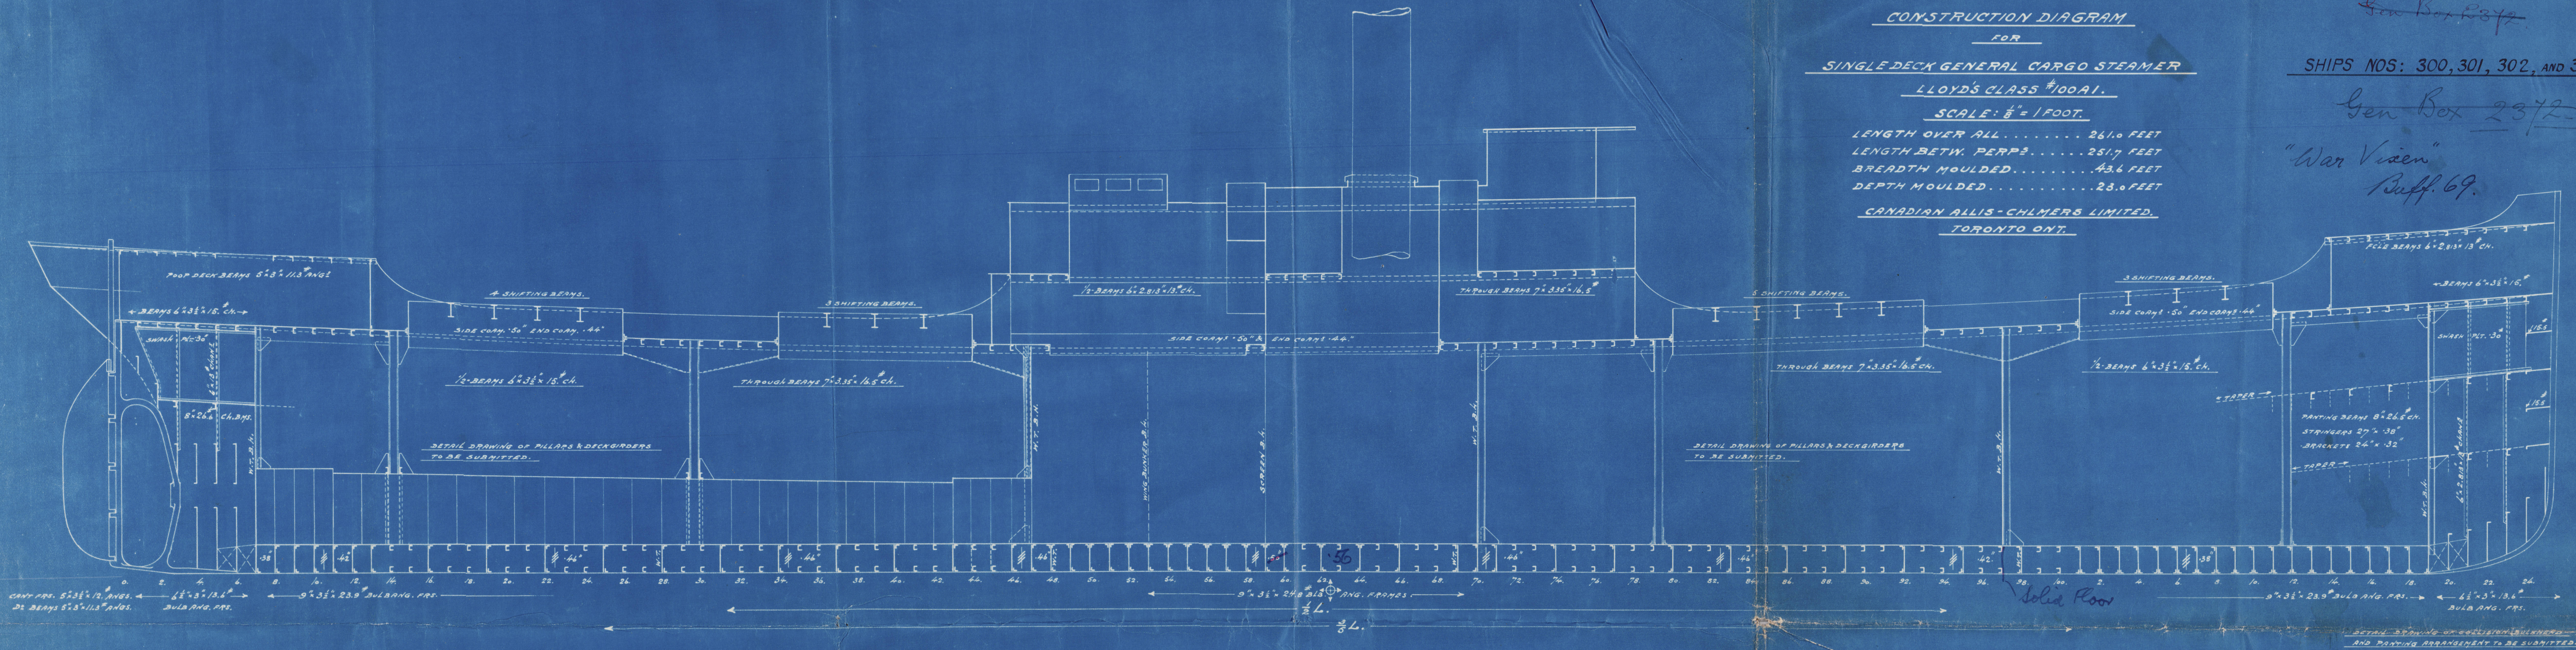

APPROVED
LLOYD'S REGISTER OF SHIPPING
DEC 17 1917
NEW YORK

French

© 2021
Lloyd's Register
Foundation

W553-0009

Canadian Ollie
P.A.
Chalmers

Box 553

AGAMEMNON

ex "WAR VIXEN"

P/D


BUILT 1919

AGAMEMNON
EX THETIS

M.M. 553

(87)

W553-0009

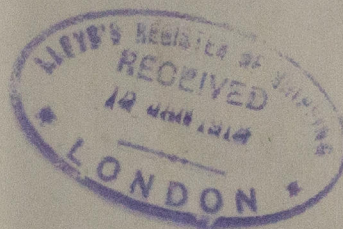

© 2021

Lloyd's Register
Foundation