

7.1.05
13.1.05
13.1.05
11.5.05
8.7.05


MIDSHIP SECTION.

BEAM MOULDED.
LENGTH B.P. 347'-0" x 47'-3" x 27'-9" D.M.
SCALE 1/2" = 1 FOOT.

POOP DECK
BEAMS 6" x 3/4" ANGLES ON EVERY FRAME
STRINGER PLATE 3/4" x 1/2"
" ANGLE 3 1/2" x 3/4" x 1/2"
DECK 1/2"

BRIDGE DECK
BEAMS 6" x 3/4" B.A. ON EVERY FRAME CLEAR OF OPENINGS.
HALF BEAMS 6" x 3/4" ANGLES " " IN WAY OF OPENINGS.
THROUGH BEAMS IN ENGINE SPACE 9" x 3 1/2" x 1/2" BULB ANGLES.
STRINGER PLATE 48" x 1/2"
" ANGLE 3 1/2" x 3/4" x 1/2"
DECK 1/2"

FORECASTLE DECK
BEAMS 6" x 3/4" B.A. ON EVERY FRAME.
" 8" x 5" x 1/2" BULBTEE UNDER WINDLASS
STRINGER ANGLE 3 1/2" x 3/4" x 1/2"
DECK 1/2" WITH WOOD SHEATHING.

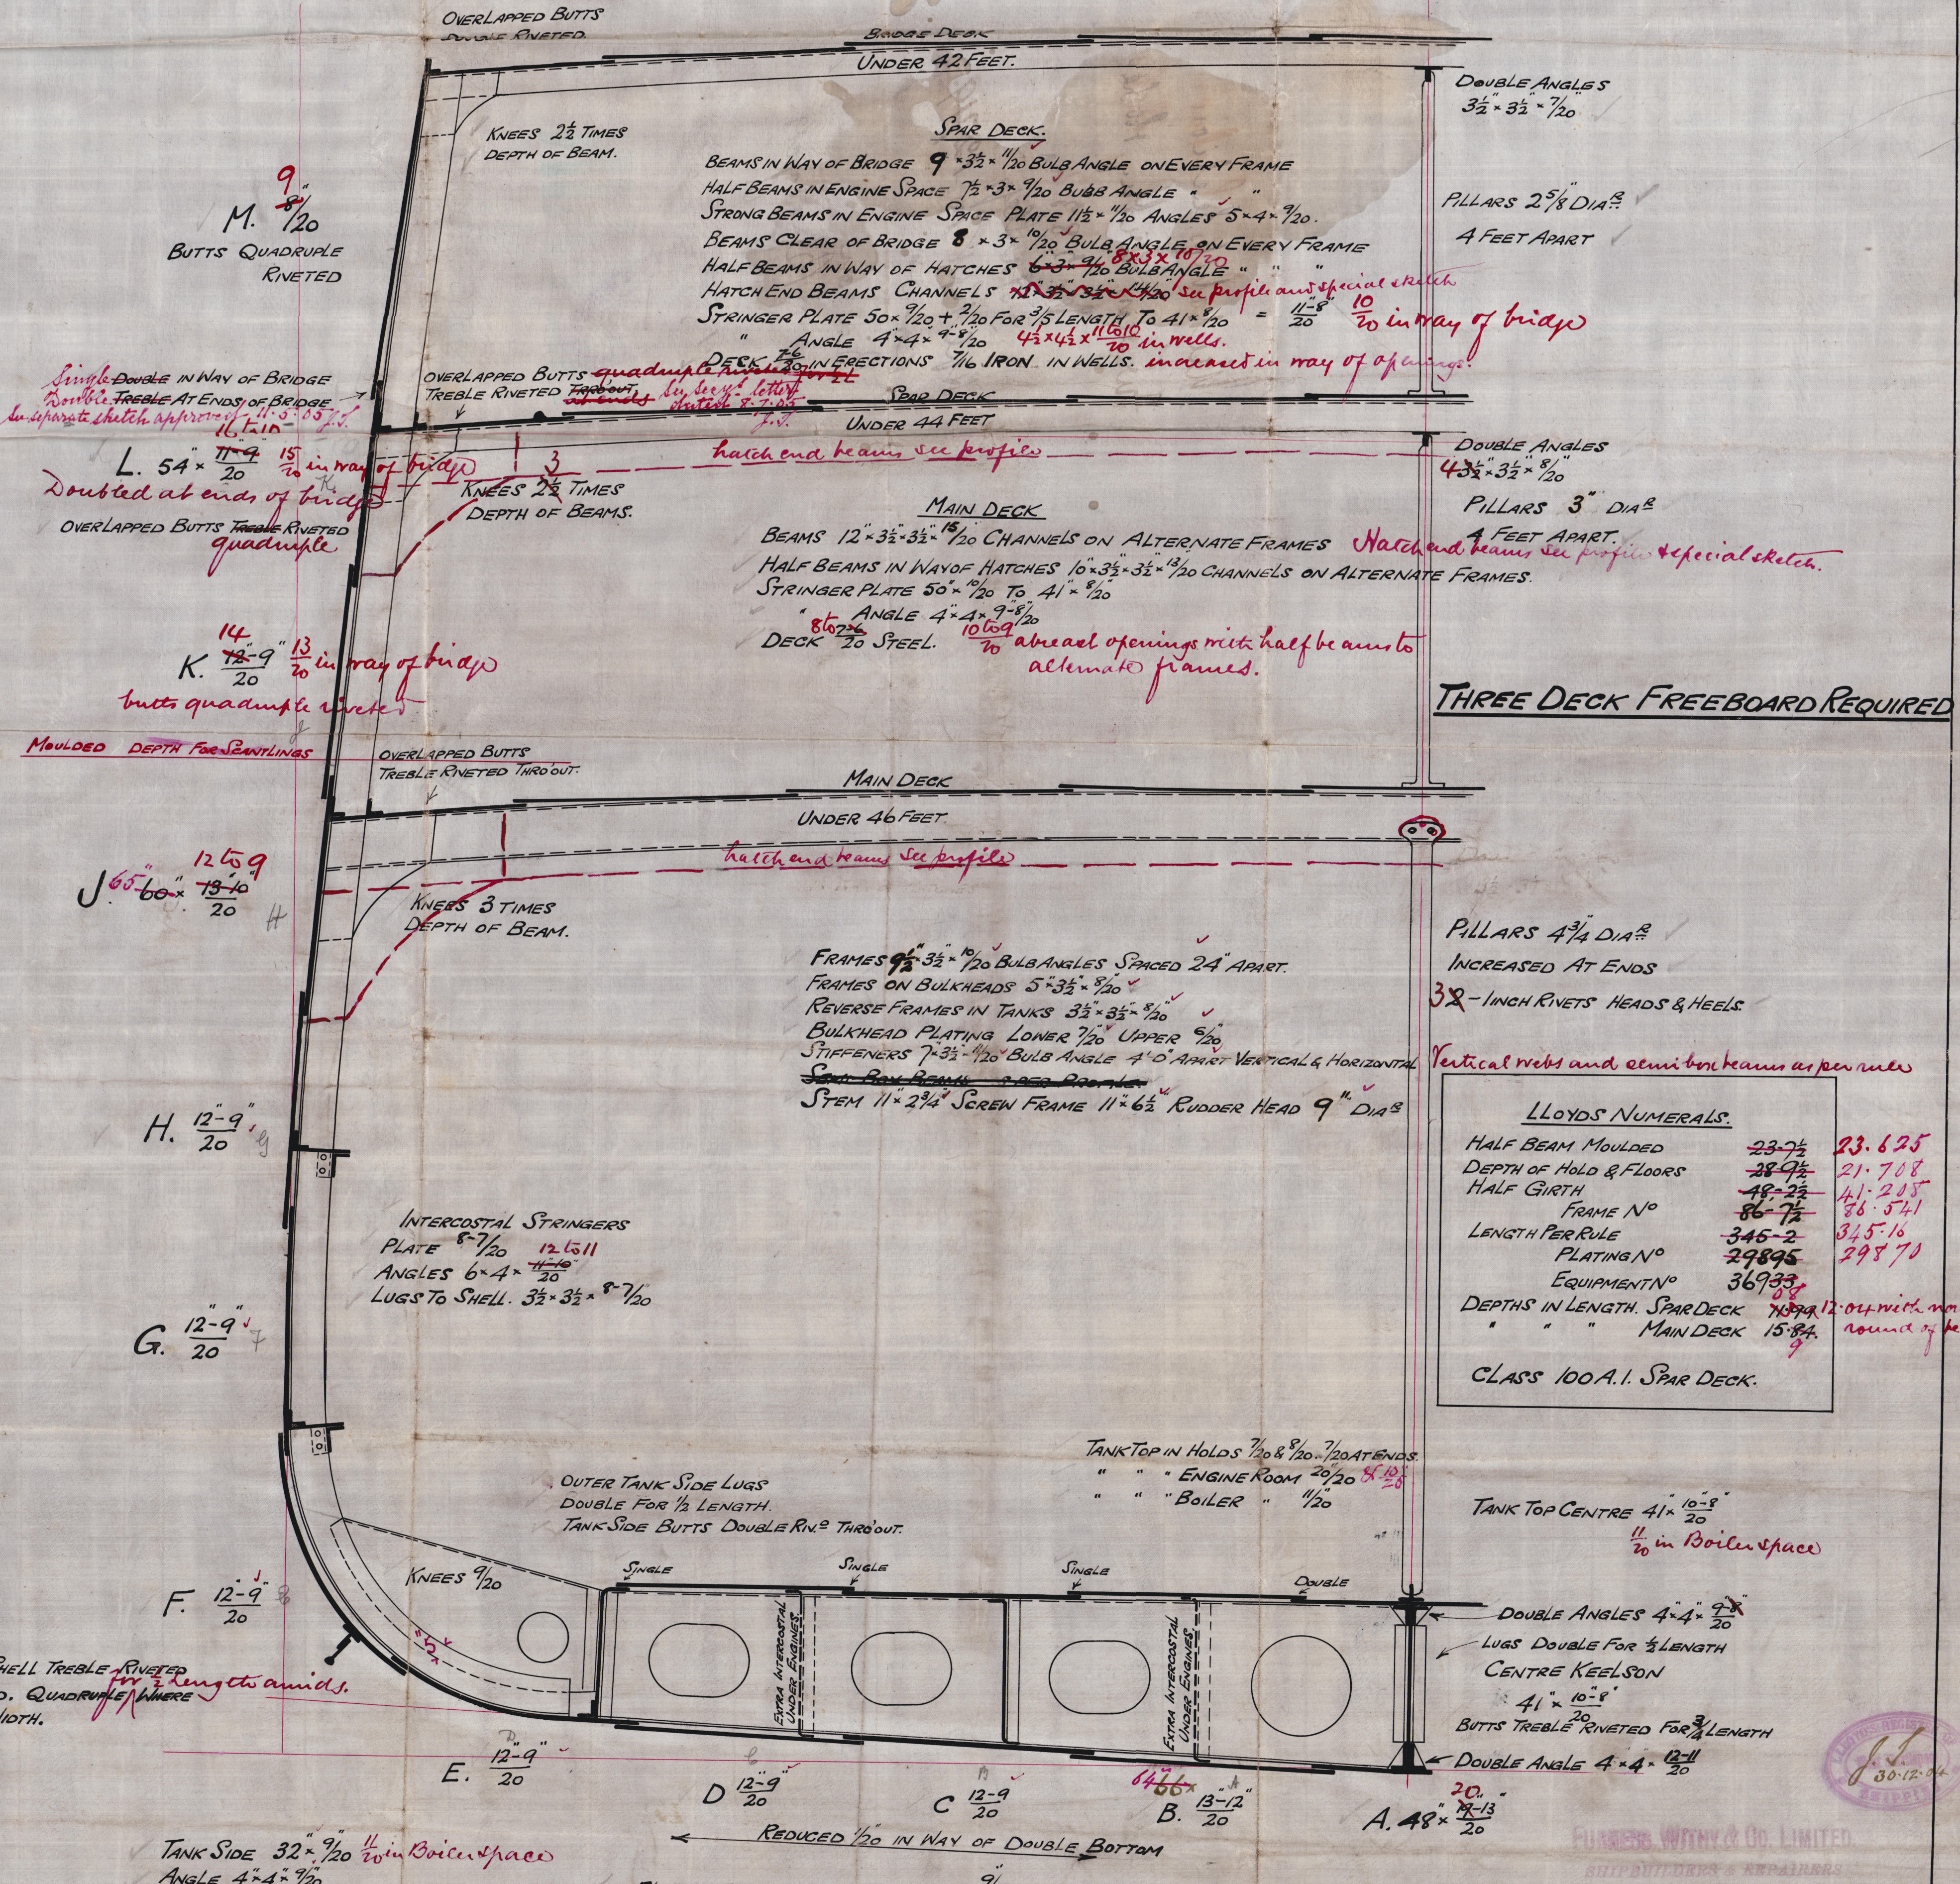

No 283.

7/1/05

WILKINS & CO. LIMITED
SHIPBUILDERS & REPAIRERS
WEST HARLEPOOL.
Dec. 24th 1904.

With ship section
Tuxen with the 16th

No. 1308
Hartley

Apr 18th 12719.

now

Baton
Brazers



© 2021

Lloyd's Register
Foundation

W553-0079