


7.1.05
13.1.05
11.5.05
8.7.05

PROFILE.
L.O.P. 347'-0" - 47'-3" - 27'-9" D.M.
SCALE 1/8" = 1 FOOT.

NOTE
PLAN OF HATCHES WILL BE SUBMITTED LATER

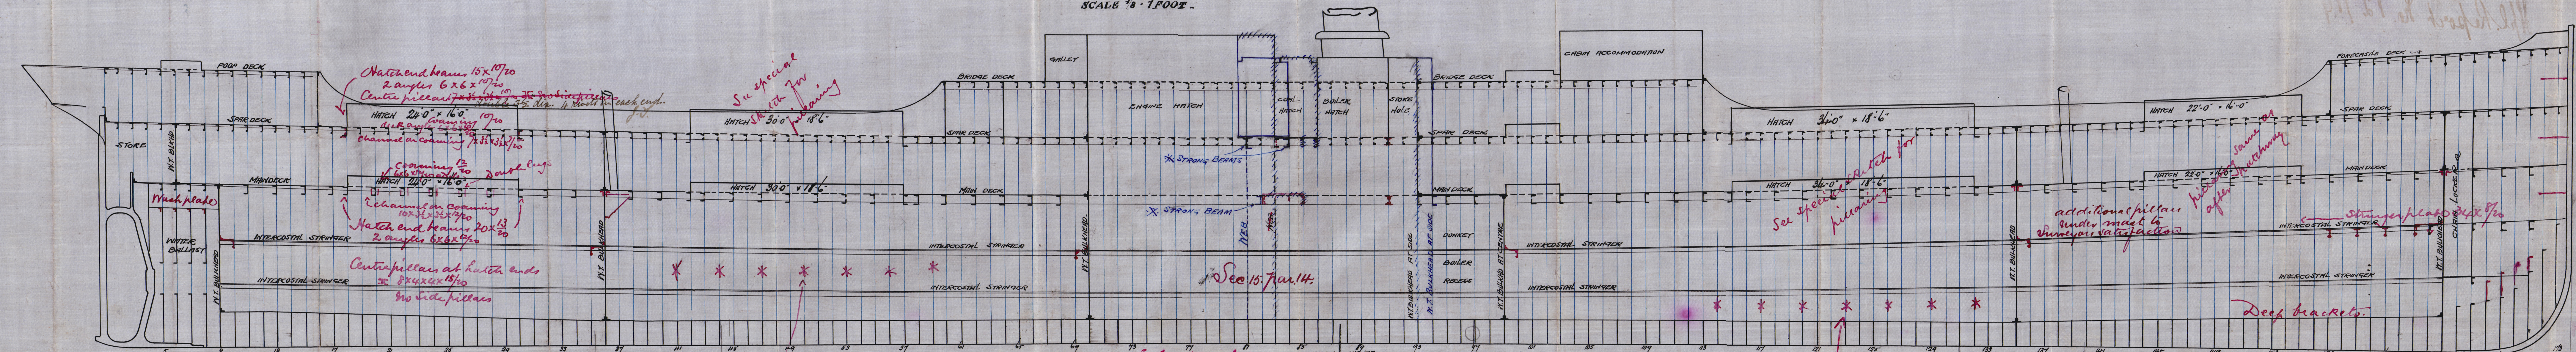

S.S. No 283.

← additional reversed frames
4 1/2 x 4 x 10/20 to upper deck →

* See Secretary's letter
dated 11.5.05
J.B.

← additional reversed frames
4 1/2 x 4 x 10/20 to upper deck →

Bottom forward strengthened as per rule



Profile

Jurassic, ~~Withey~~ & to hd.

No. 283

is "Harley"

Hpl. Report No. 12719

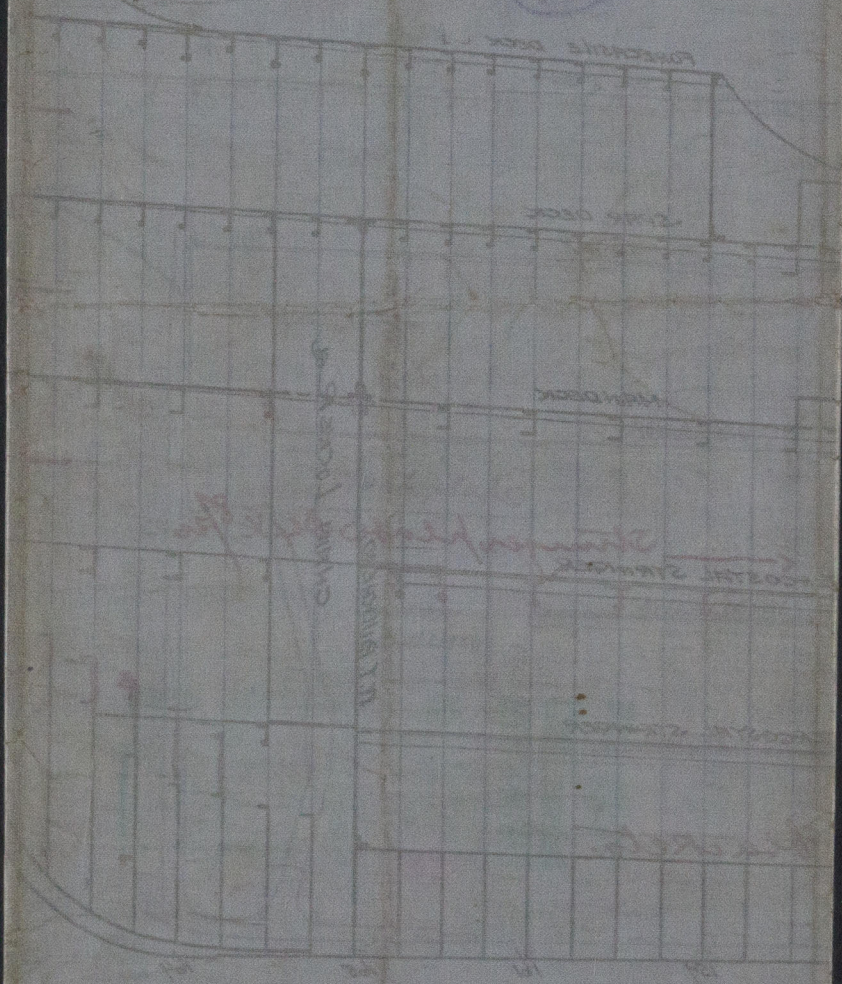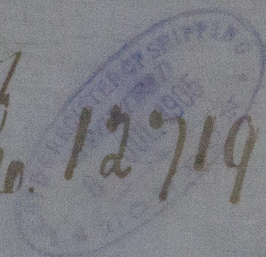

© 2021

Lloyd's Register
Foundation

W553-0080