


ALL CHARRED WOOD ON SHELTER DECK TO BE RENEWED.
WINCHES IN WAY OF FIRE TO BE THOROUGHLY OVERHAULED.

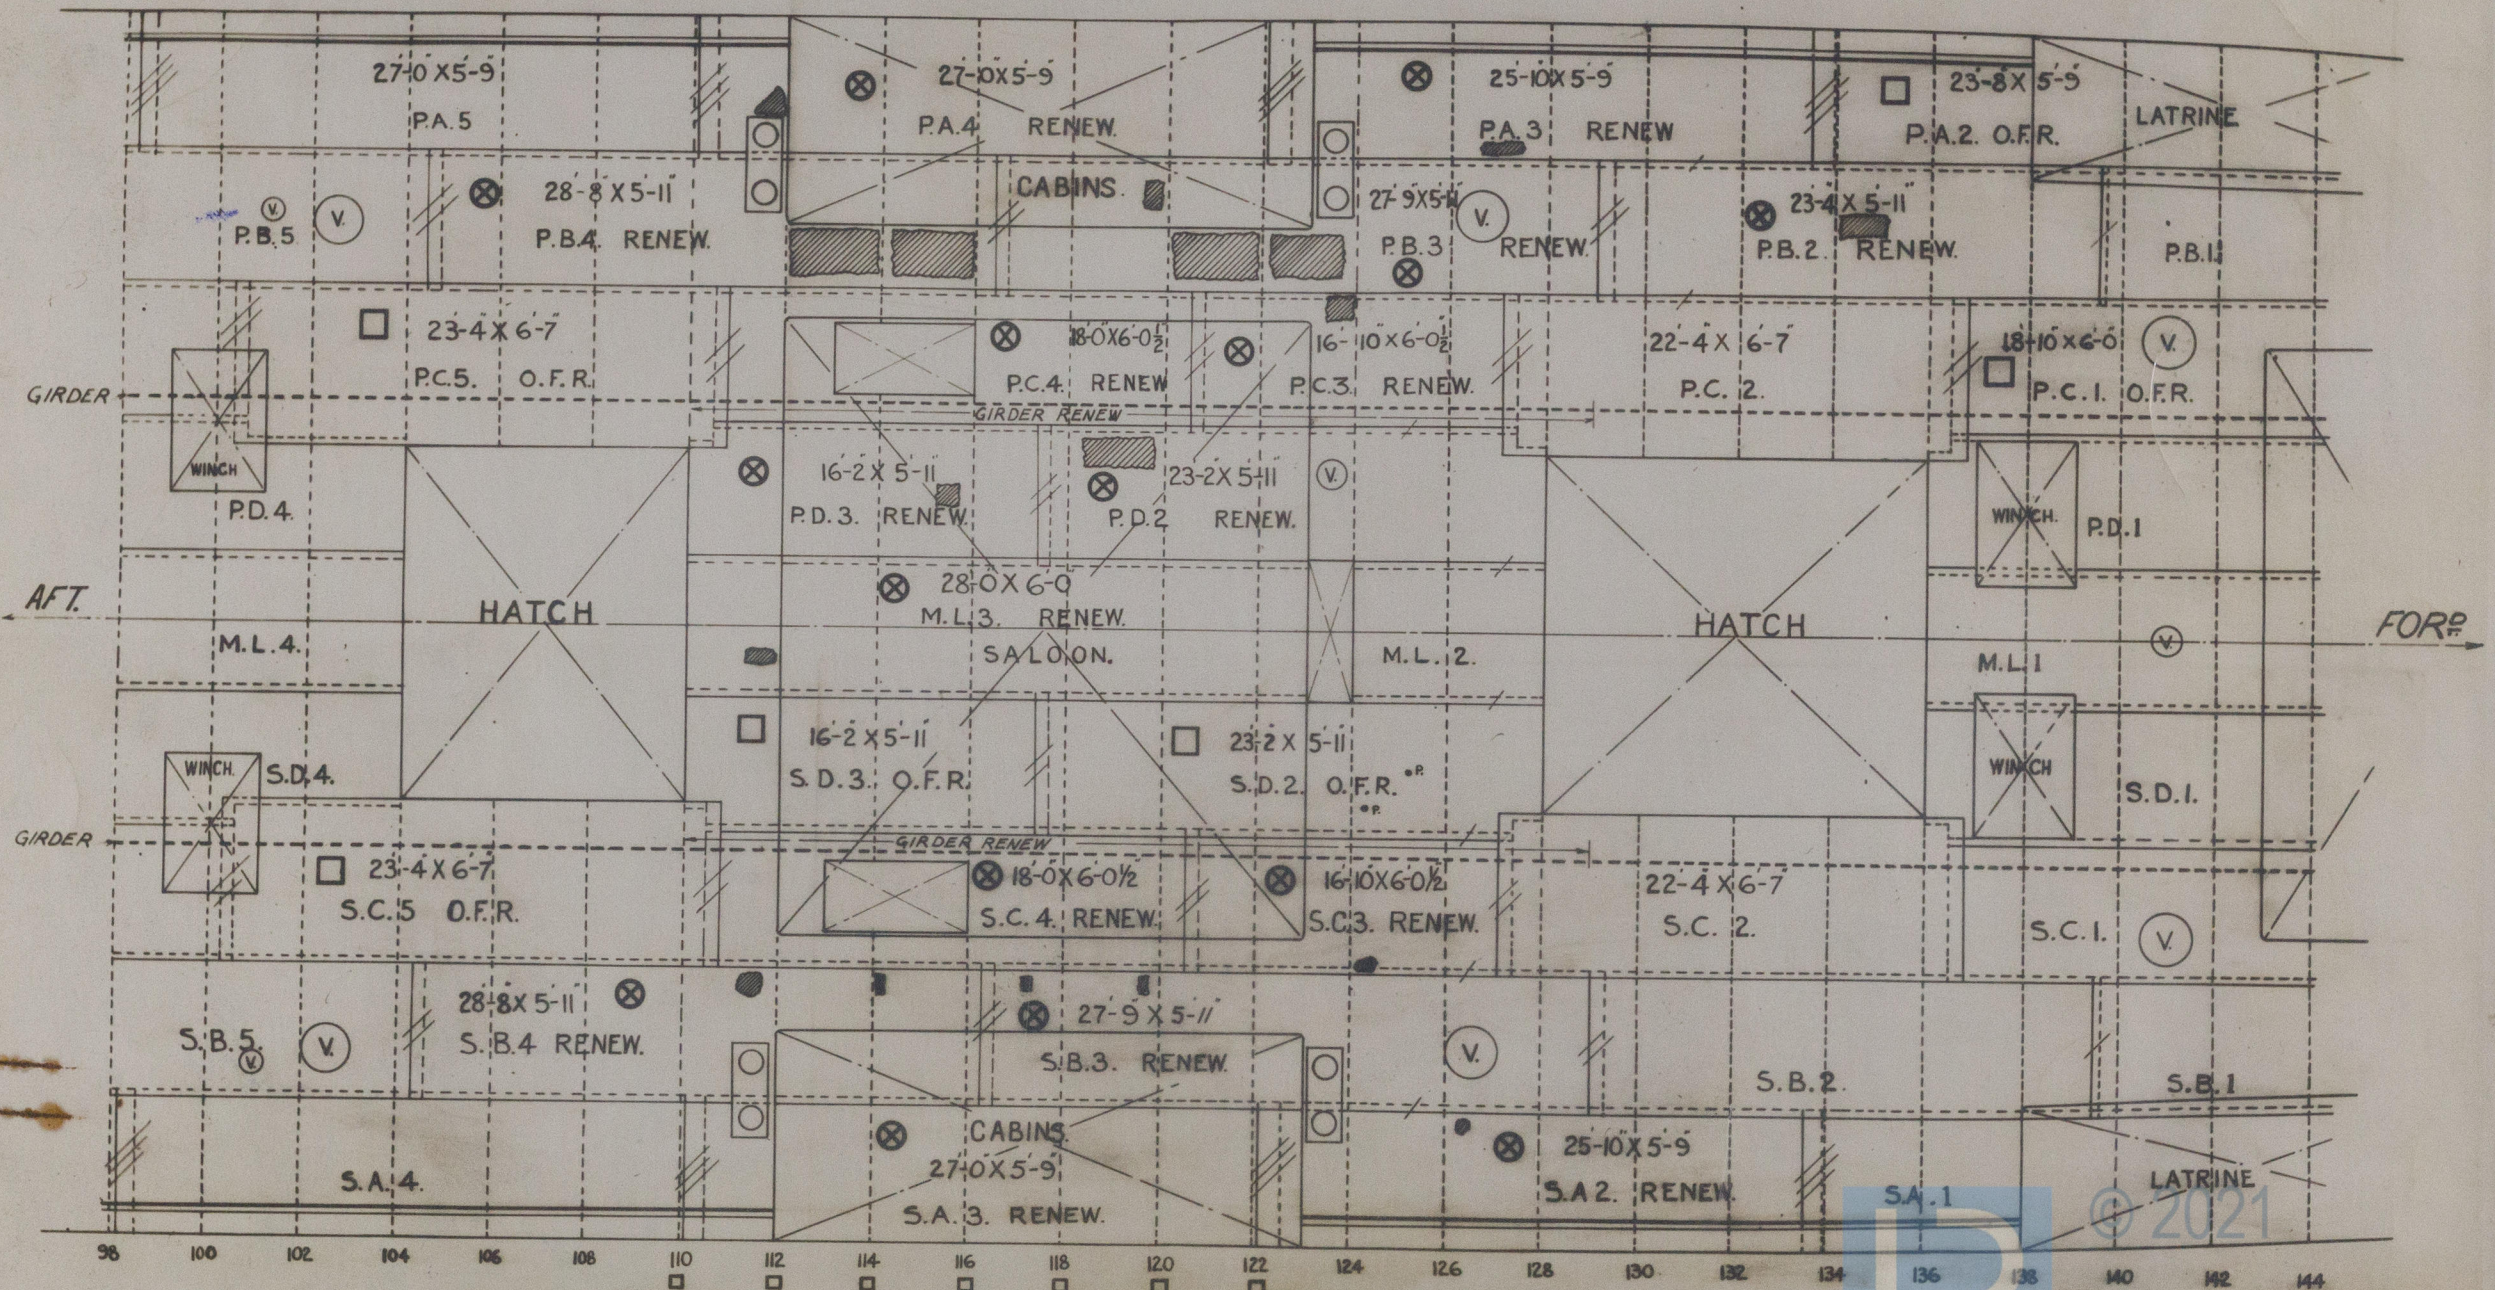

ACCOMMODATION :- SALOON, CABINS, BATHROOMS
AND CHART ROOM - ALL WOOD WORK, FURNITURE, ELECTRIC
WIRING & FITTINGS & EQUIPMENT TO BE REPAIRED OR
RENEWED AS NECESSARY.

S. S. DARA. SHELTER DECK.

HOLES CUT IN DECK PLATE FOR ACCESS TO FIRE.
⊗ OFF AND RENEW.
□ OFF FAIR AND RE-FIT.