


1.3.01  
 31.10.01  
 1906  
 altered 10/1/07

Longitudinal Elevation No 186 SS  
 Scale  $\frac{1}{8}$  = one foot


altered to 196 16/1/01  
 also No 196 appd 3/10/01

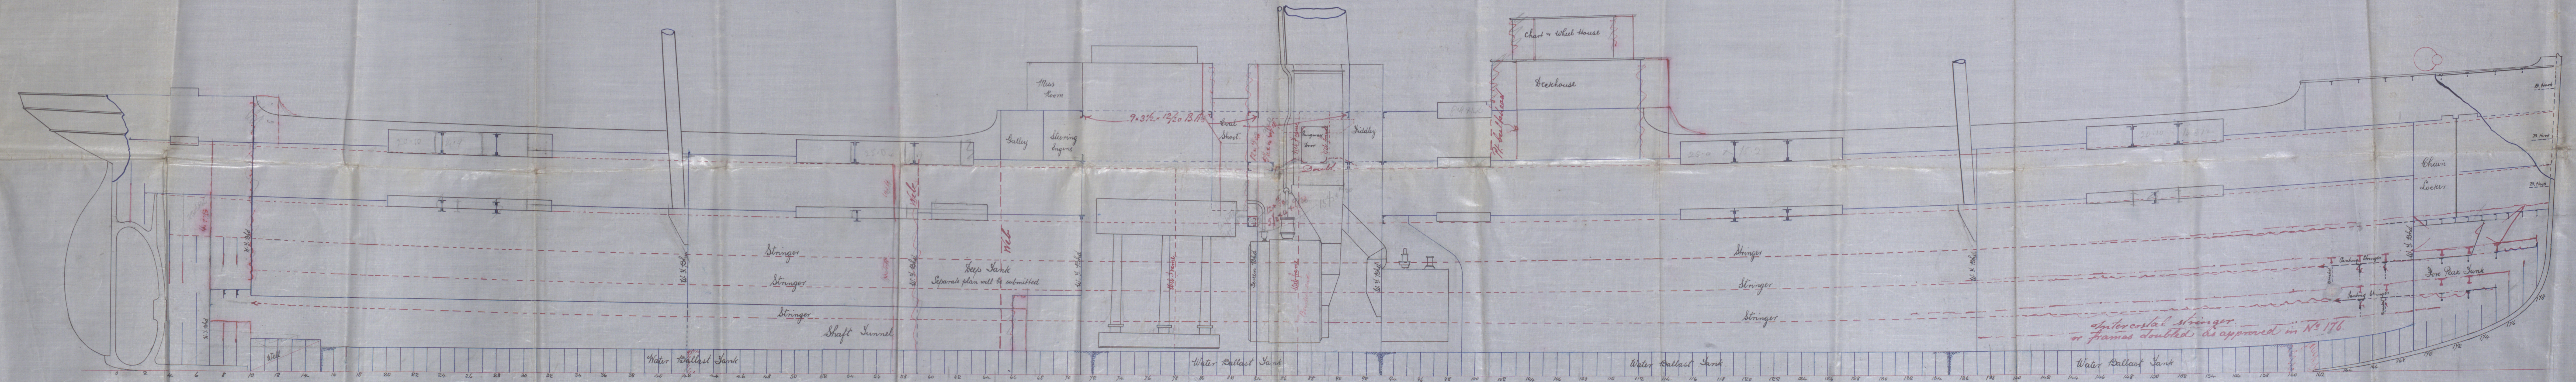

J.H.  
 1/3/07





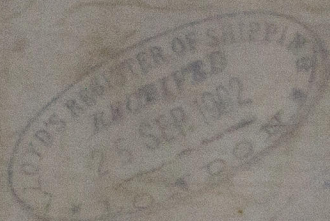

Pres<sup>re</sup> Workman Clerk & Co

85 No 186

~~8 1946~~

Accepted 16/11/01

Profile plan

Belfast - 25/2/01

Lord Antrim

Del 5410

REF

W554-0193



© 2021

Lloyd's Register  
Foundation