

Timbre	7 ^h 4	Working pressure = 100 lbs per sq. inch.
Surface de chauffe	39 ^m 50	Boasting Surface = 445 sq. ft.
Surface de grille	2 ^m 02	Grate Surface = 28 sq. ft.
Volume de vapeur	2 ^m 480	Steam Room = 88 Cubic feet
Volume d'eau	6 ^m 192	Water Room = 218 Cubic feet
Capacité totale	8 ^m 672	Total Capacity = 306 Cubic feet


Steamer N^o 5 de 6200 t^x

Chaudière auxiliaire

CAILLARD & C^{IE}
INGÉNIEURS-CONSTRUCTEURS
→ HAVRE ←
Plan N° 20068
Expédition 7275




Dunkley Boiler in Steel
intended for Vessel N^o 5 in building
to Dunkerque.

5th November 18 1902

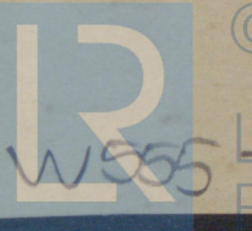

© 2020

WS55-10037 Lloyd's Reg Foundation

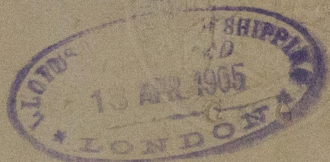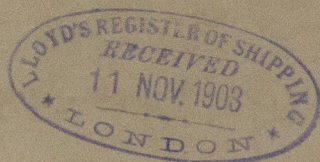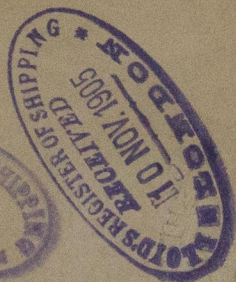

Dunkey Boiler. Plan
intended for Vessel n^o 5. Built
by the Chantiers de France. to Dunkerque
also for Vessels N^{os} 6-7 & 8.

n ^o 5	S.S. Ville de Paris.	Dunkirk	1024	X
"6.	S.S. "Velle du Havre."	- " -	1054.	
"7	S.S. Louisiane	- " -	1129	
"8	S.S. Californie	- " -	1152.	


RETIRED



© 2020

Lloyd's Register
Foundation

W555-0037

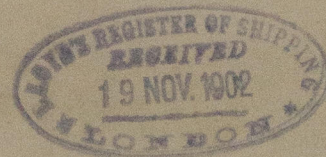

© 2020

Lloyd's Register
Foundation