





24-6-04
2-7-04
5-1-05

(AMENDED)
— PROFILE. —

S.S. 342'-0" x 49'-6" x 25'-2" MLD

SCALE 8" = 1 FOOT

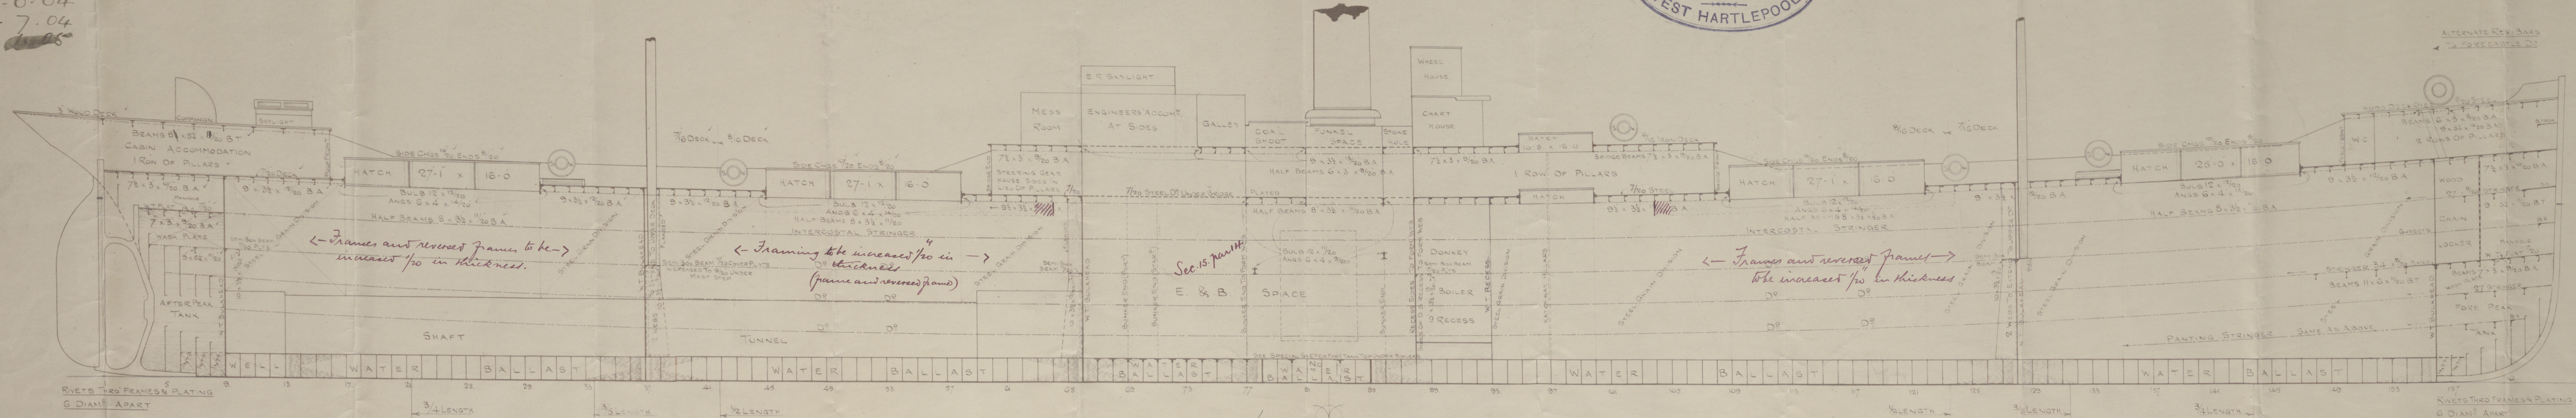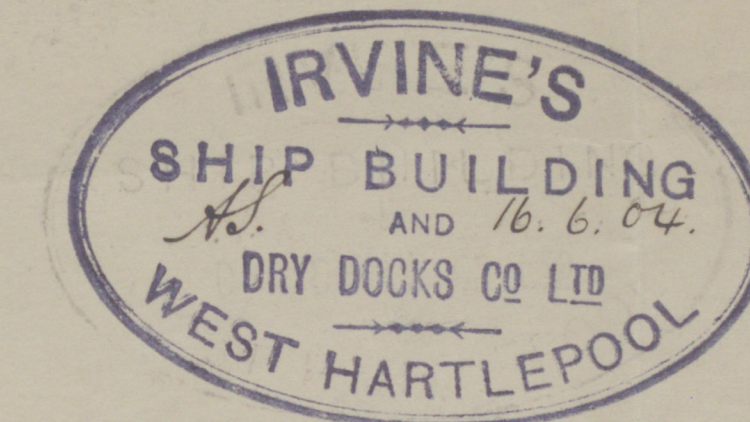

S.S. 140.

J.H.
24/6/04

Irvine's 8 B & D Co Ltd
No 140
Profile

SS *Serravallo*

Wpl. Report No. 12

RETAIN



© 2020

Lloyd's Register
Foundation

W555-0098