
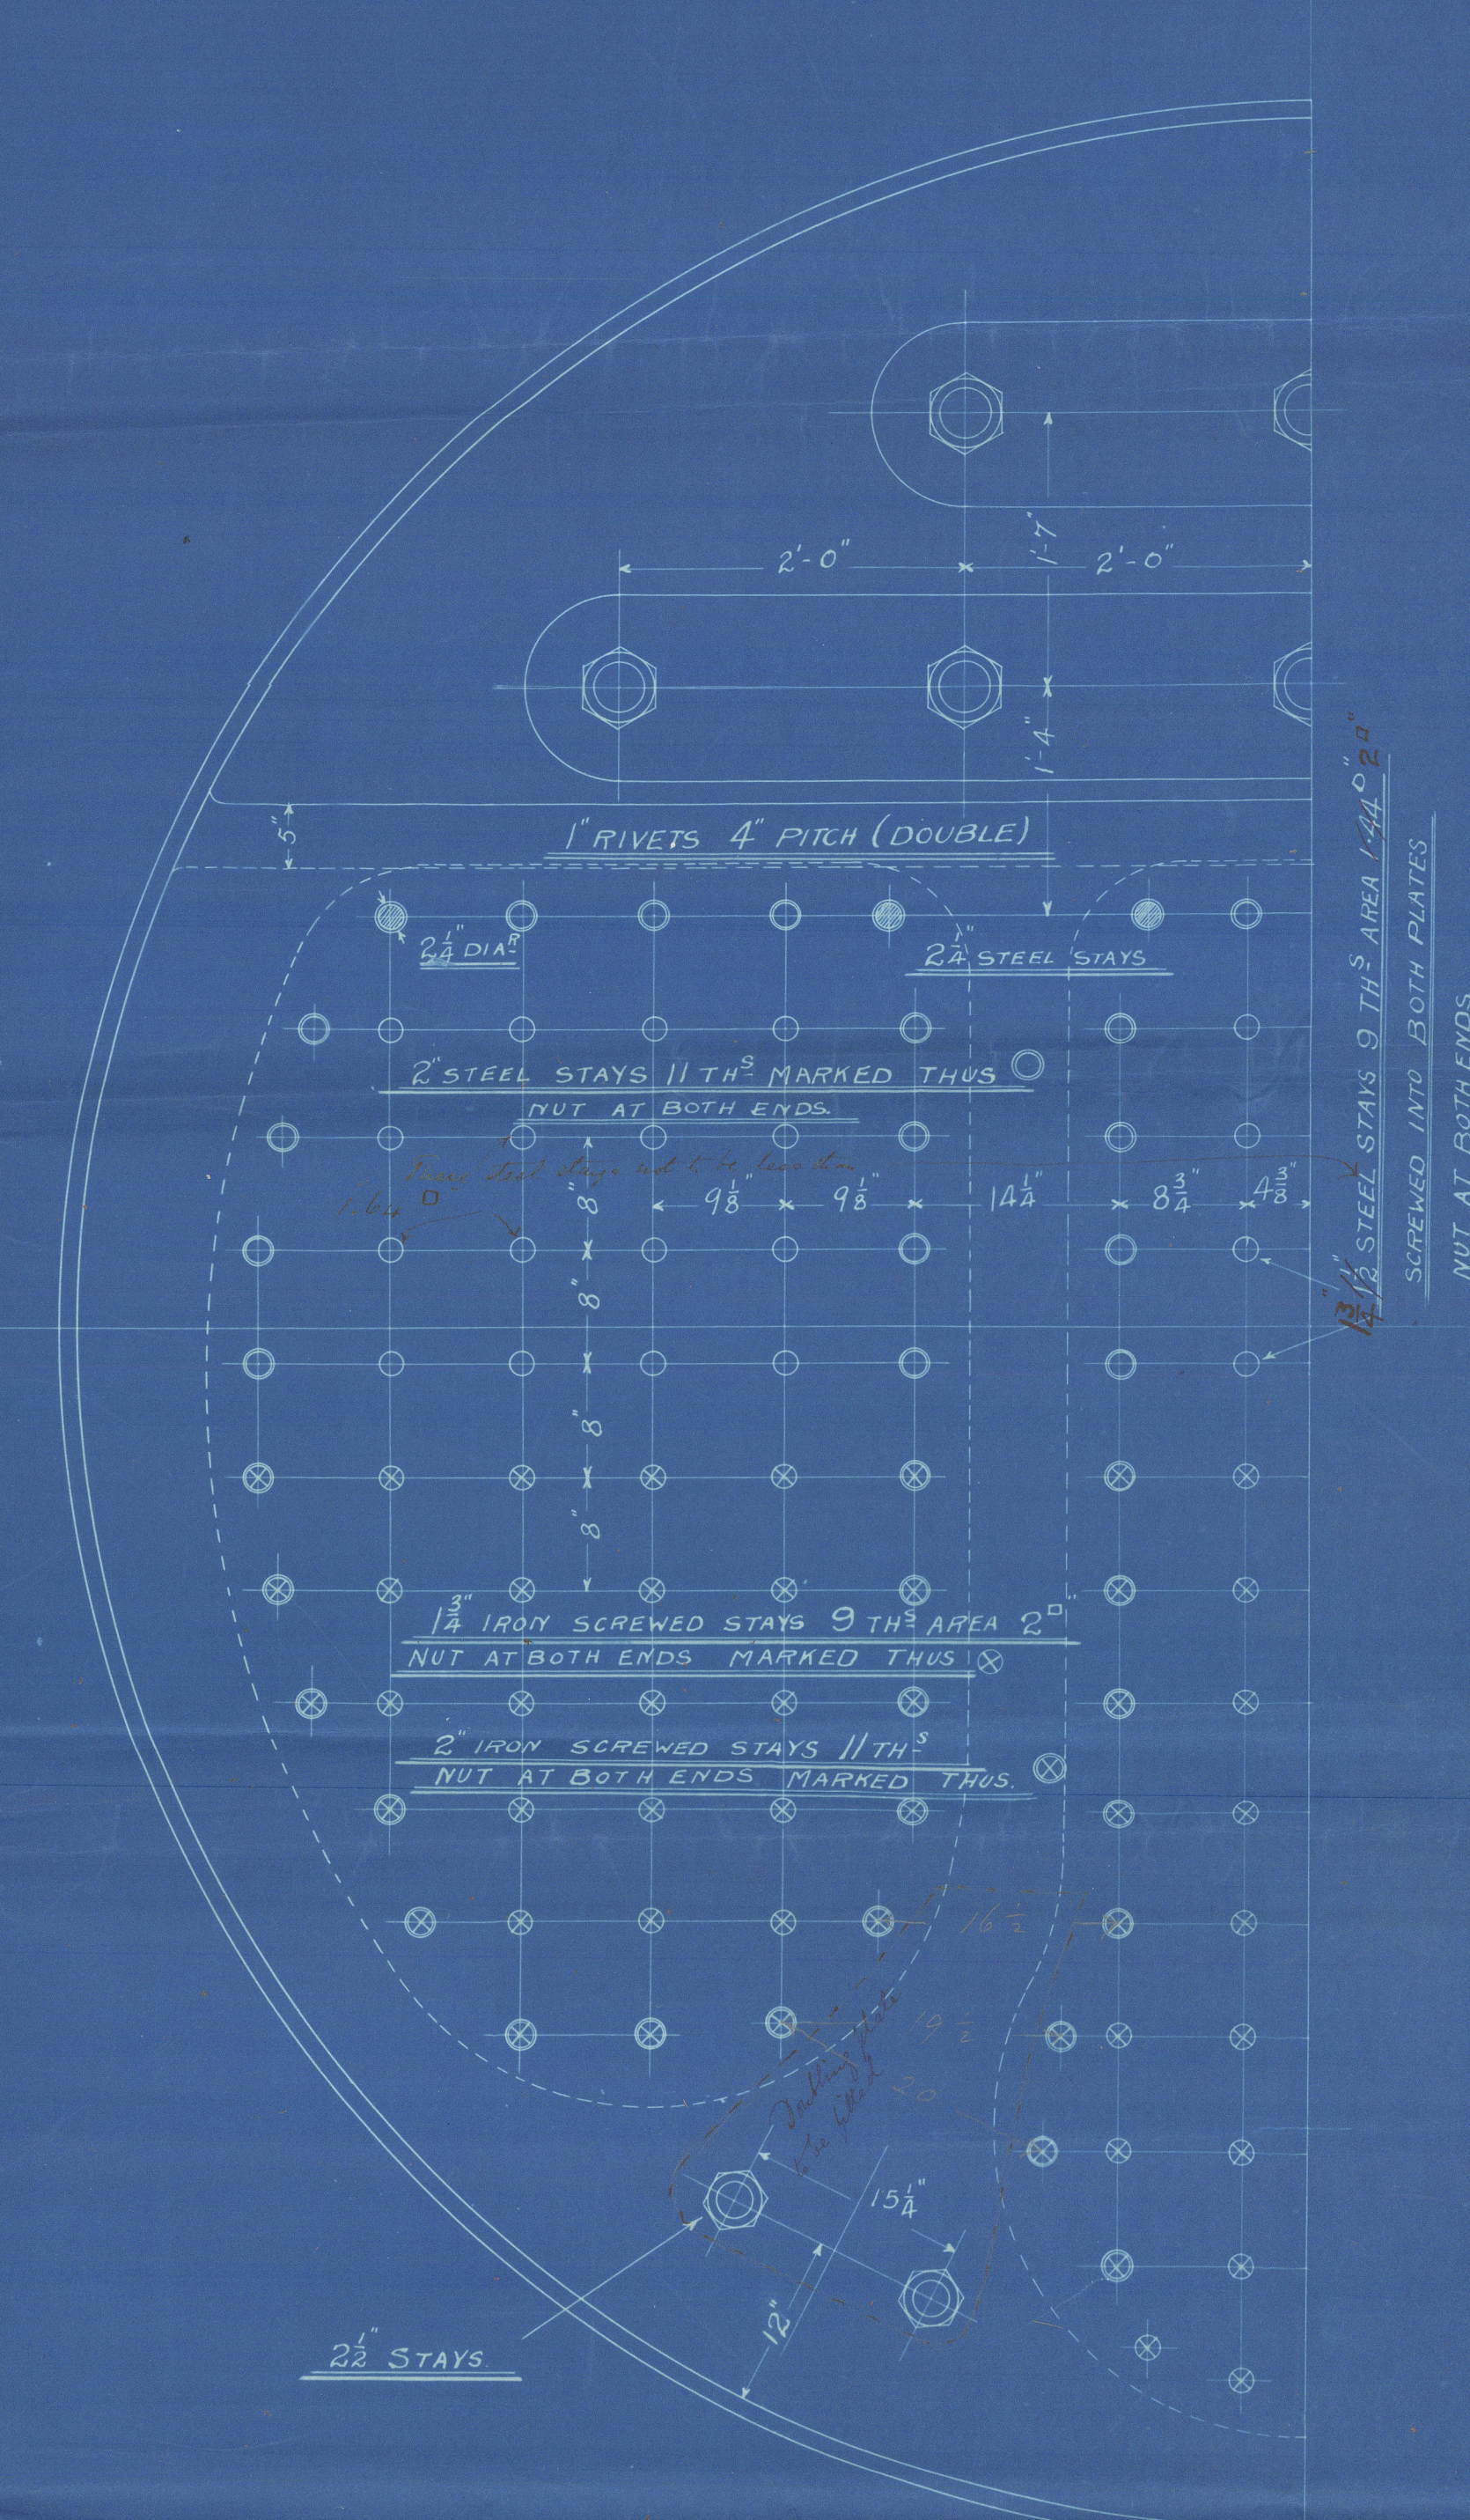
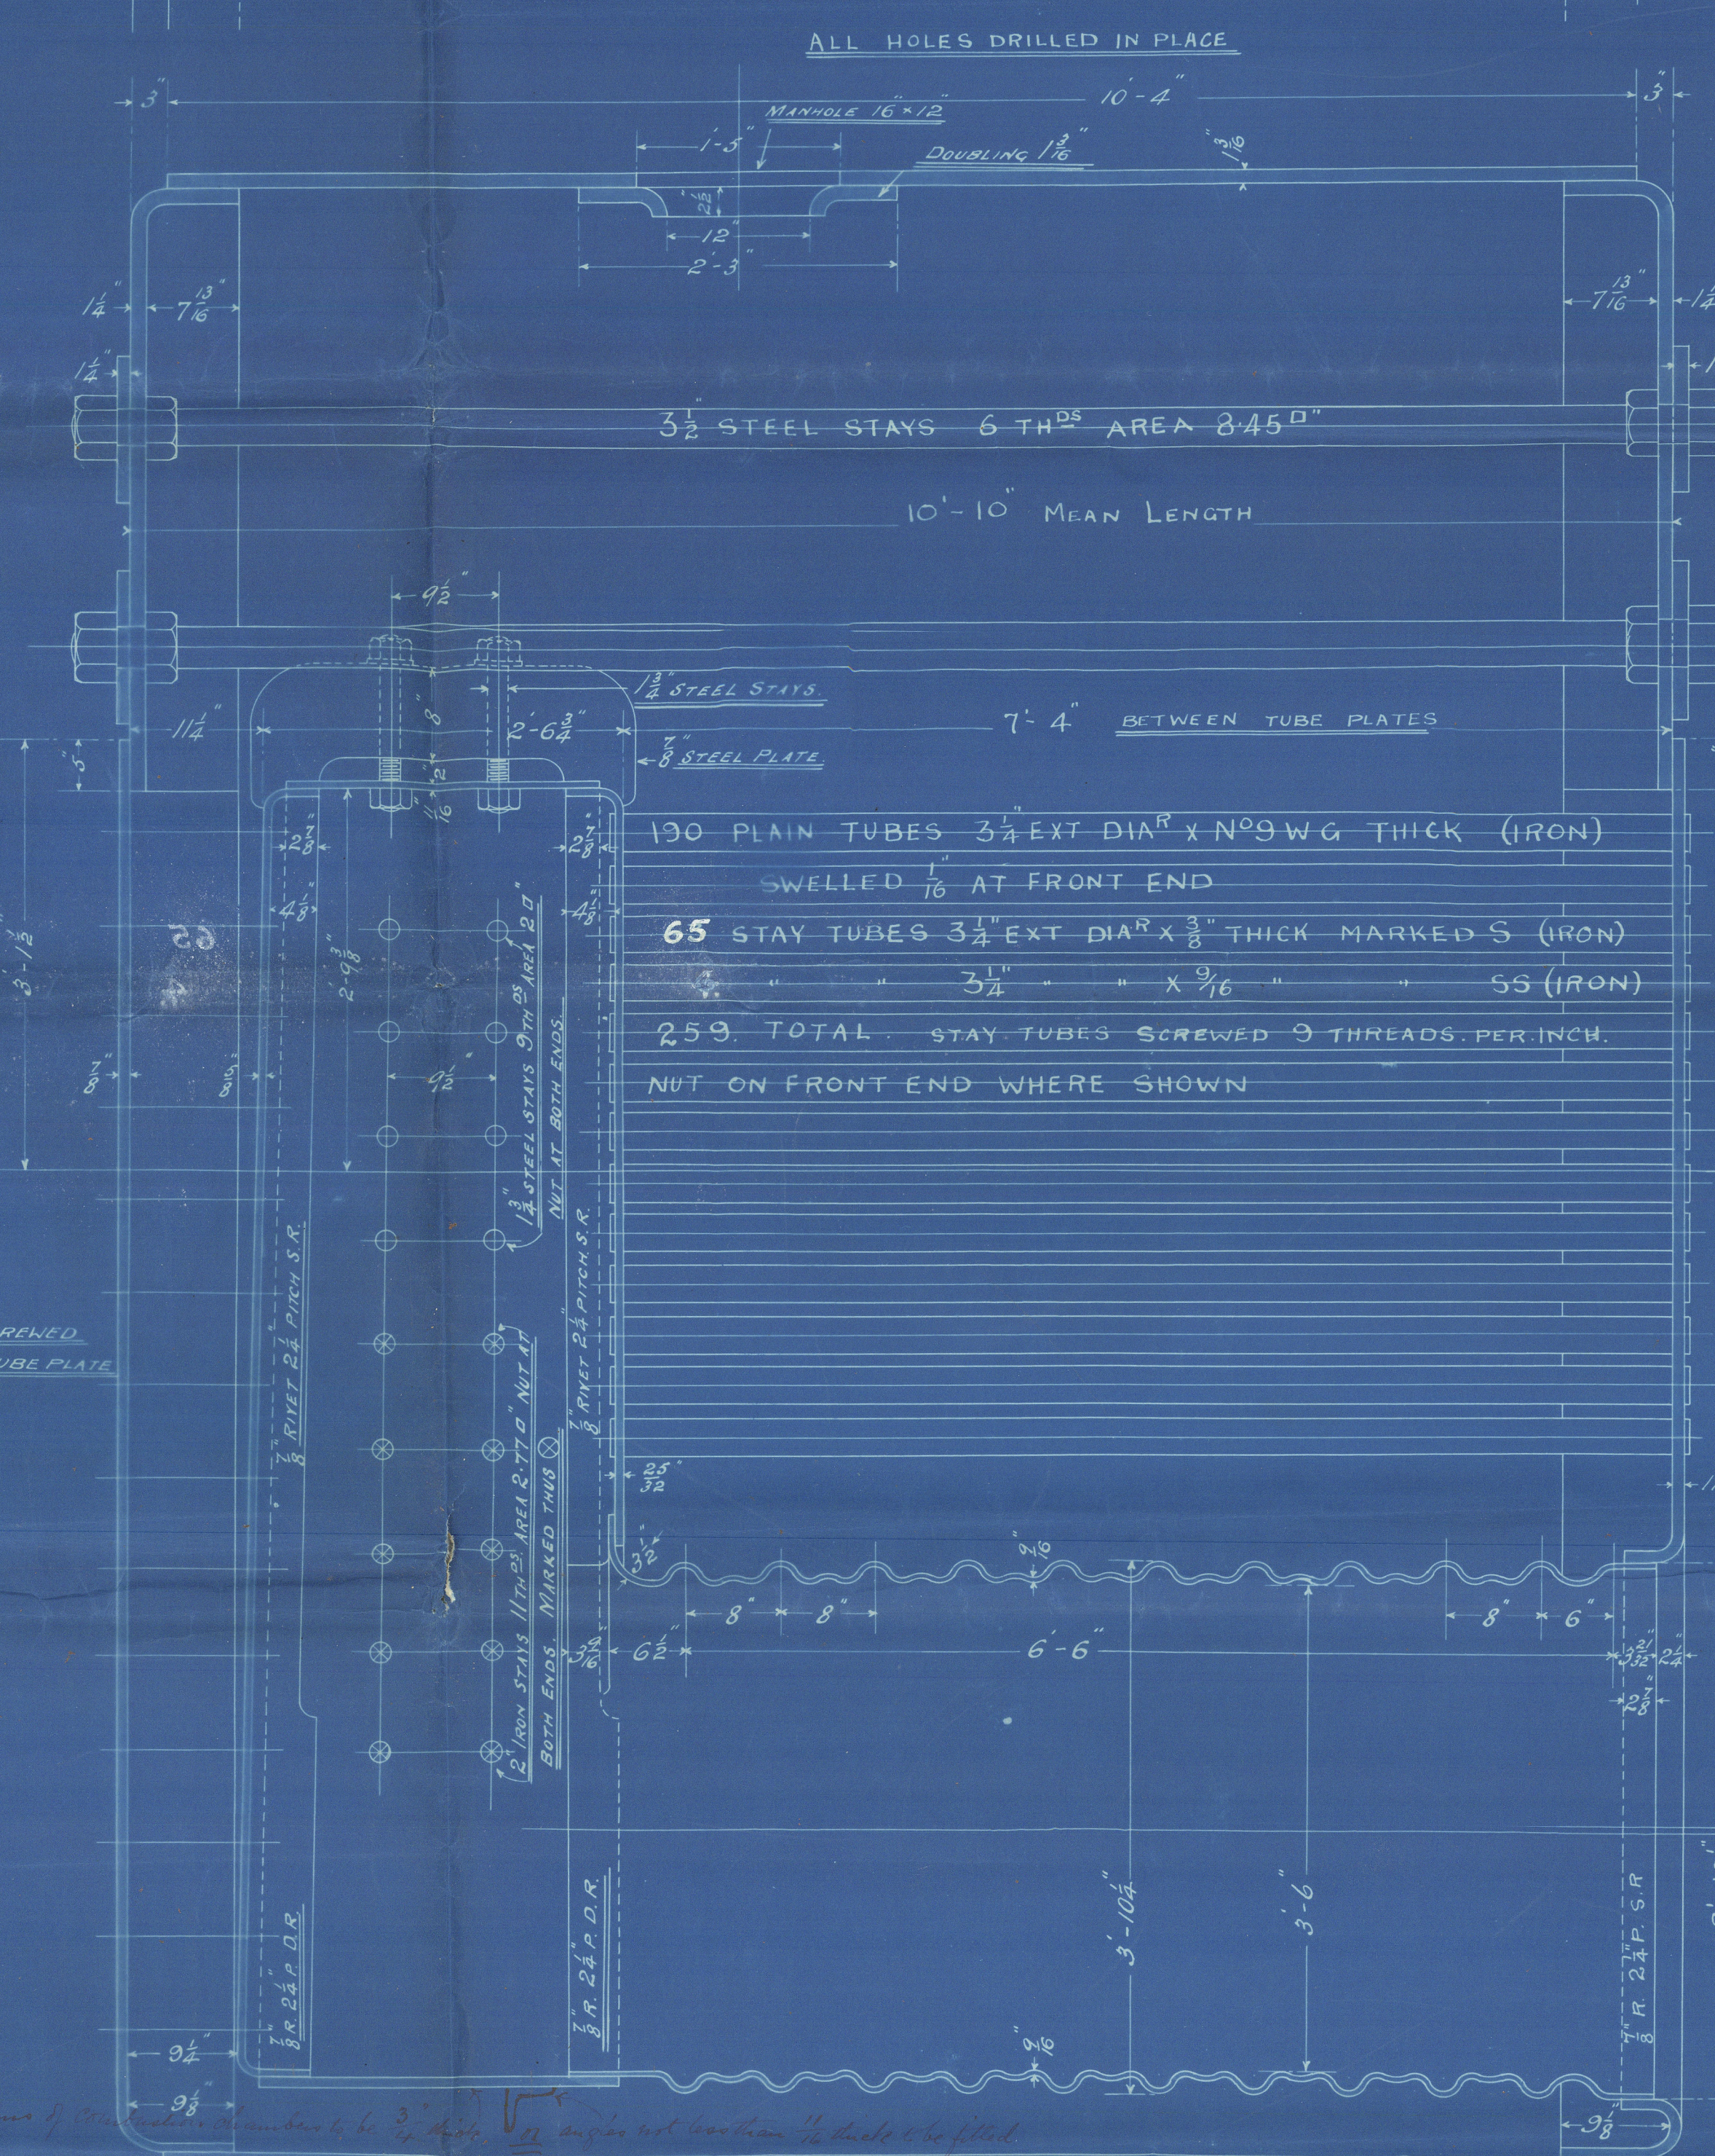


18.6.03.

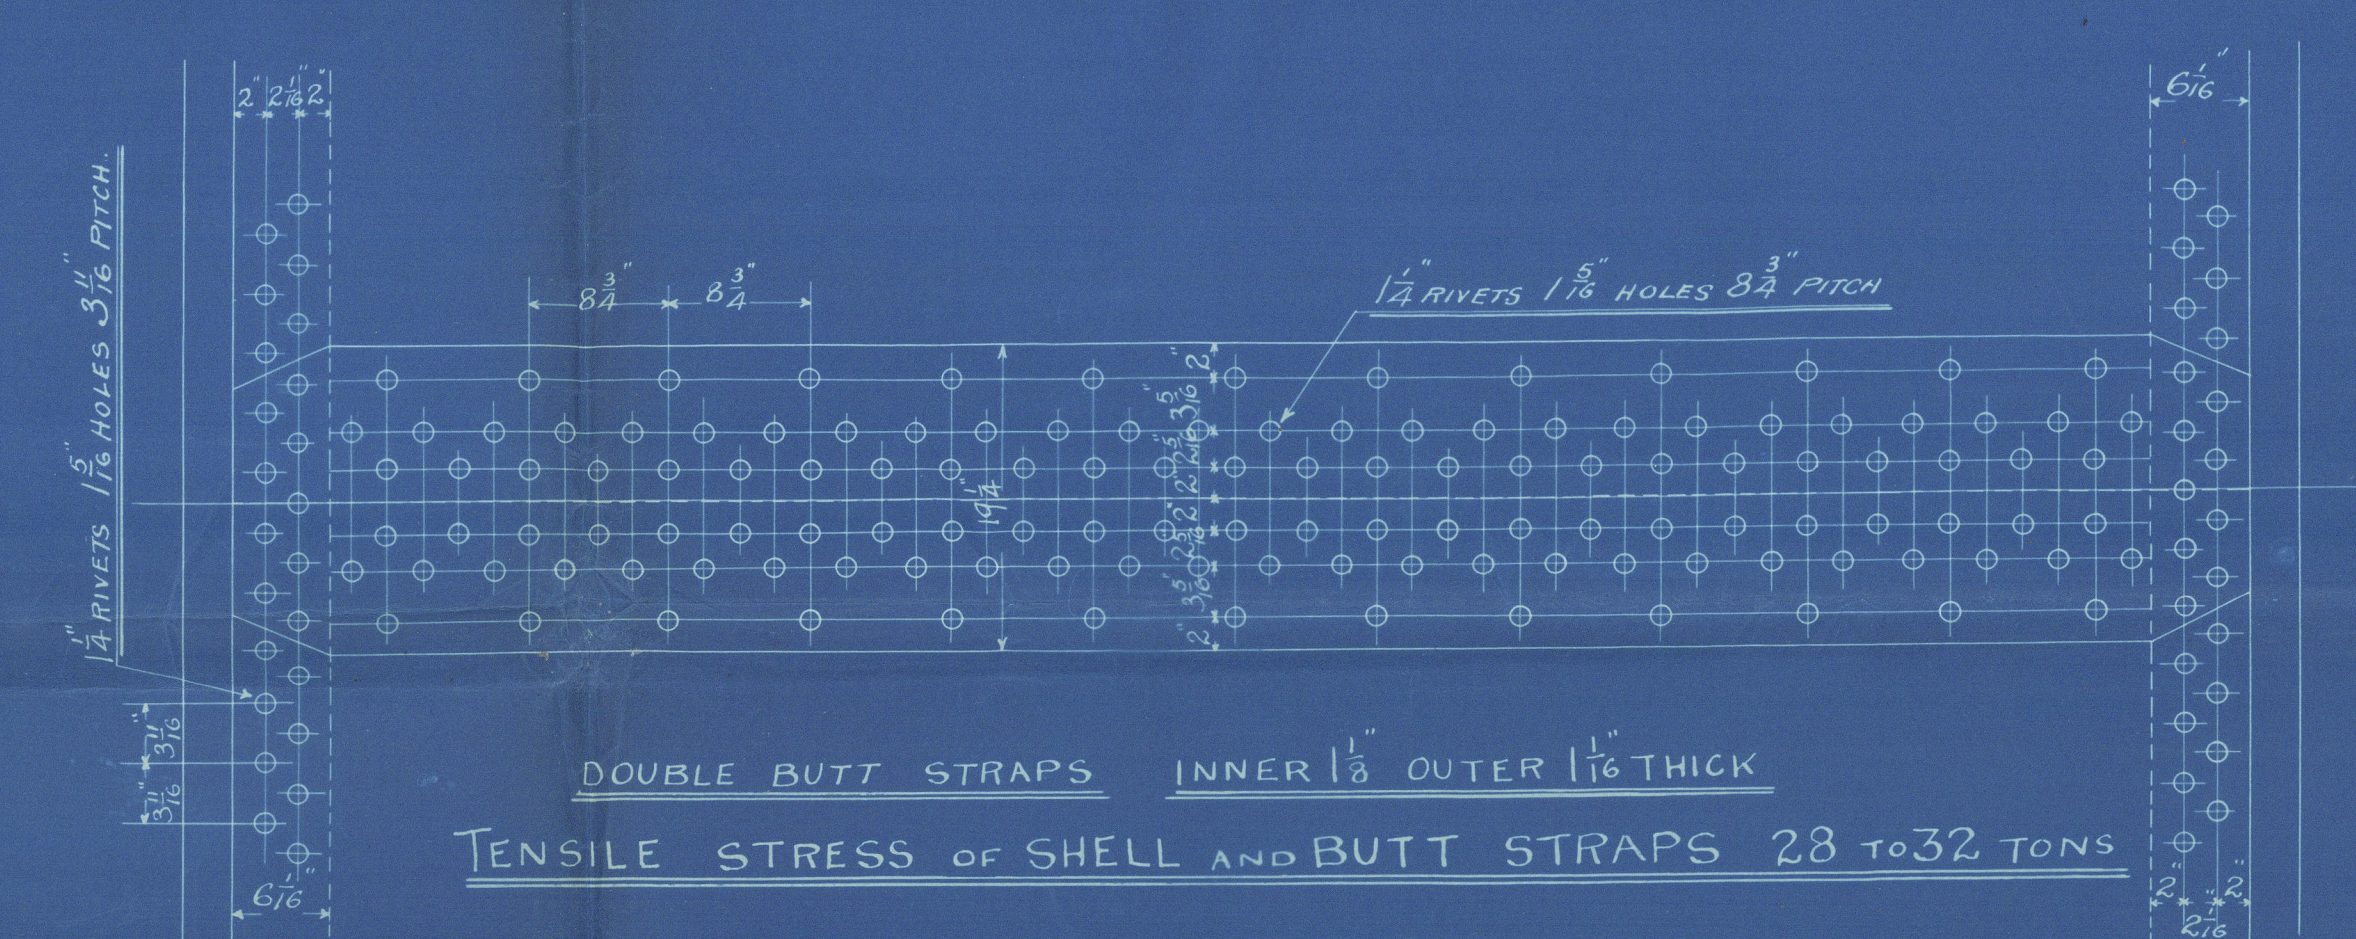

PARTICULARS.	
HEATING SURFACE TUBES	1612 #
" CHAMBERS	123 #
" FURNACES	225 #
" TOTAL	1960 #

— STEEL BOILER 14'-3" INT^l DIA^B x 10'-10" MEAN LENGTH 180 LBS W.P. —

— To LLOYD'S SURVEY —


— SCALE 1"=1 FOOT —

— ORDER N^o 916 —



Rees. Anderson & Co.
Boiler No 916.
180 lbs w.P.

s/s "Fraternity."

Murdoch & Murray's 195.
Engine 498. Rees. Anderson & Co.
Dry Boiler 917. Dry Boiler "
Main " 916. Main "

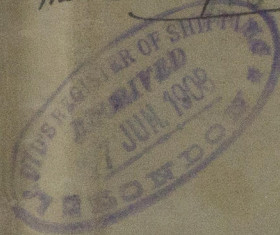

Gh. Rpt to 21854

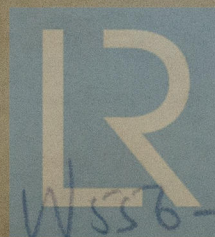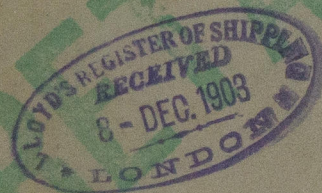

© 2021

Lloyd's Register
Foundation

W556-0222