

stem frame

Montrose No 19

S. S. "Souverain"

Dundee

Rpt No. 4054.

© 2020

Lloyd's Register
Foundation

W559-0018

Lloyd's Register of British and Foreign Shipping.

(Report on Vessel No. 4054 Port Dundee)

No. 1130 SHIP FORGINGS OR ~~CASTINGS~~.

The words FORGINGS or CASTINGS, IRON or STEEL, should be struck out as may be required.

I have to report that the undermentioned Iron or ~~Steel~~ Forgings or ~~Castings~~, manufactured by Thom Gasbarrichal & Co of Dundee for the Vessel No. 19, being built by Montrose S.S. Co of Montrose have been inspected by me as set forth below and found to be, so far as can be seen, sound and good.


Mark on Forgings.

Lloyd's
No. 995
WM-19.7.04

W^m Morrison
Dundee

	STERN FRAME.	RUDDER FRAME.	STEM.
Material*	<u>Scrap iron</u>		
How made	<u>Forged</u>		
Dimensions	<u>7 1/2 x 4 3/4</u>		
Progress on Inspection	<u>Forged & finished</u>		
Date when Inspected	<u>June 1. 15. 28</u> <u>July 4. 19 - 1904</u>		

SKETCHES OF FRAMES SHOWING POSITION AND DESCRIPTION OF WELDS OF FORGINGS, OR PARTICULARS OF TESTS APPLIED TO CASTINGS.

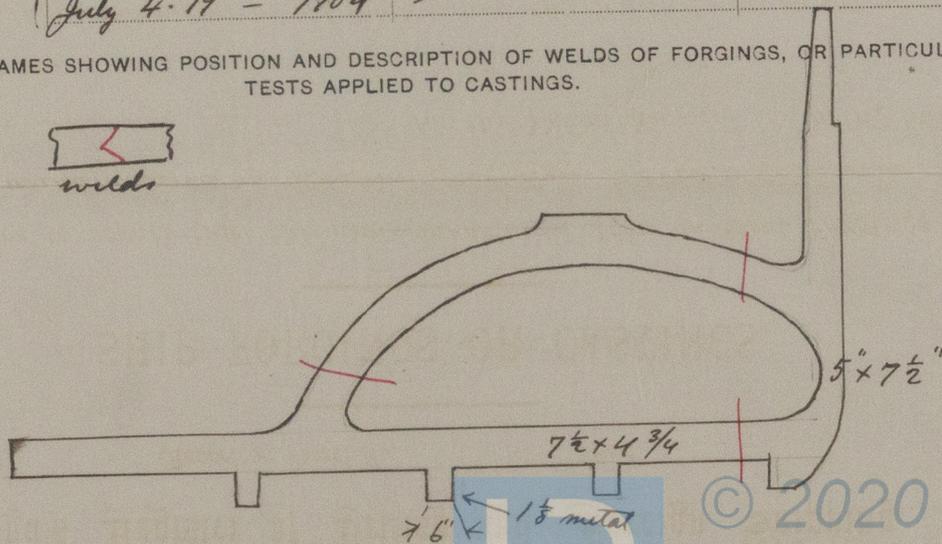

Fee (if any chargeable) £

To be paid at _____

* If of Iron, state whether scrap or puddled Iron.

