


SS. "BOSNIA".
PROFILE & DECK PLAN.

292.0 L.B.P. x 45.0 B.T. EXT. x 22.6 DEPTH M.O.

SCALE 5' = 1 FOOT.



SCANTLING OF HATCHES, BULKHEADS, ETC.
HAS BEEN SUBMITTED.

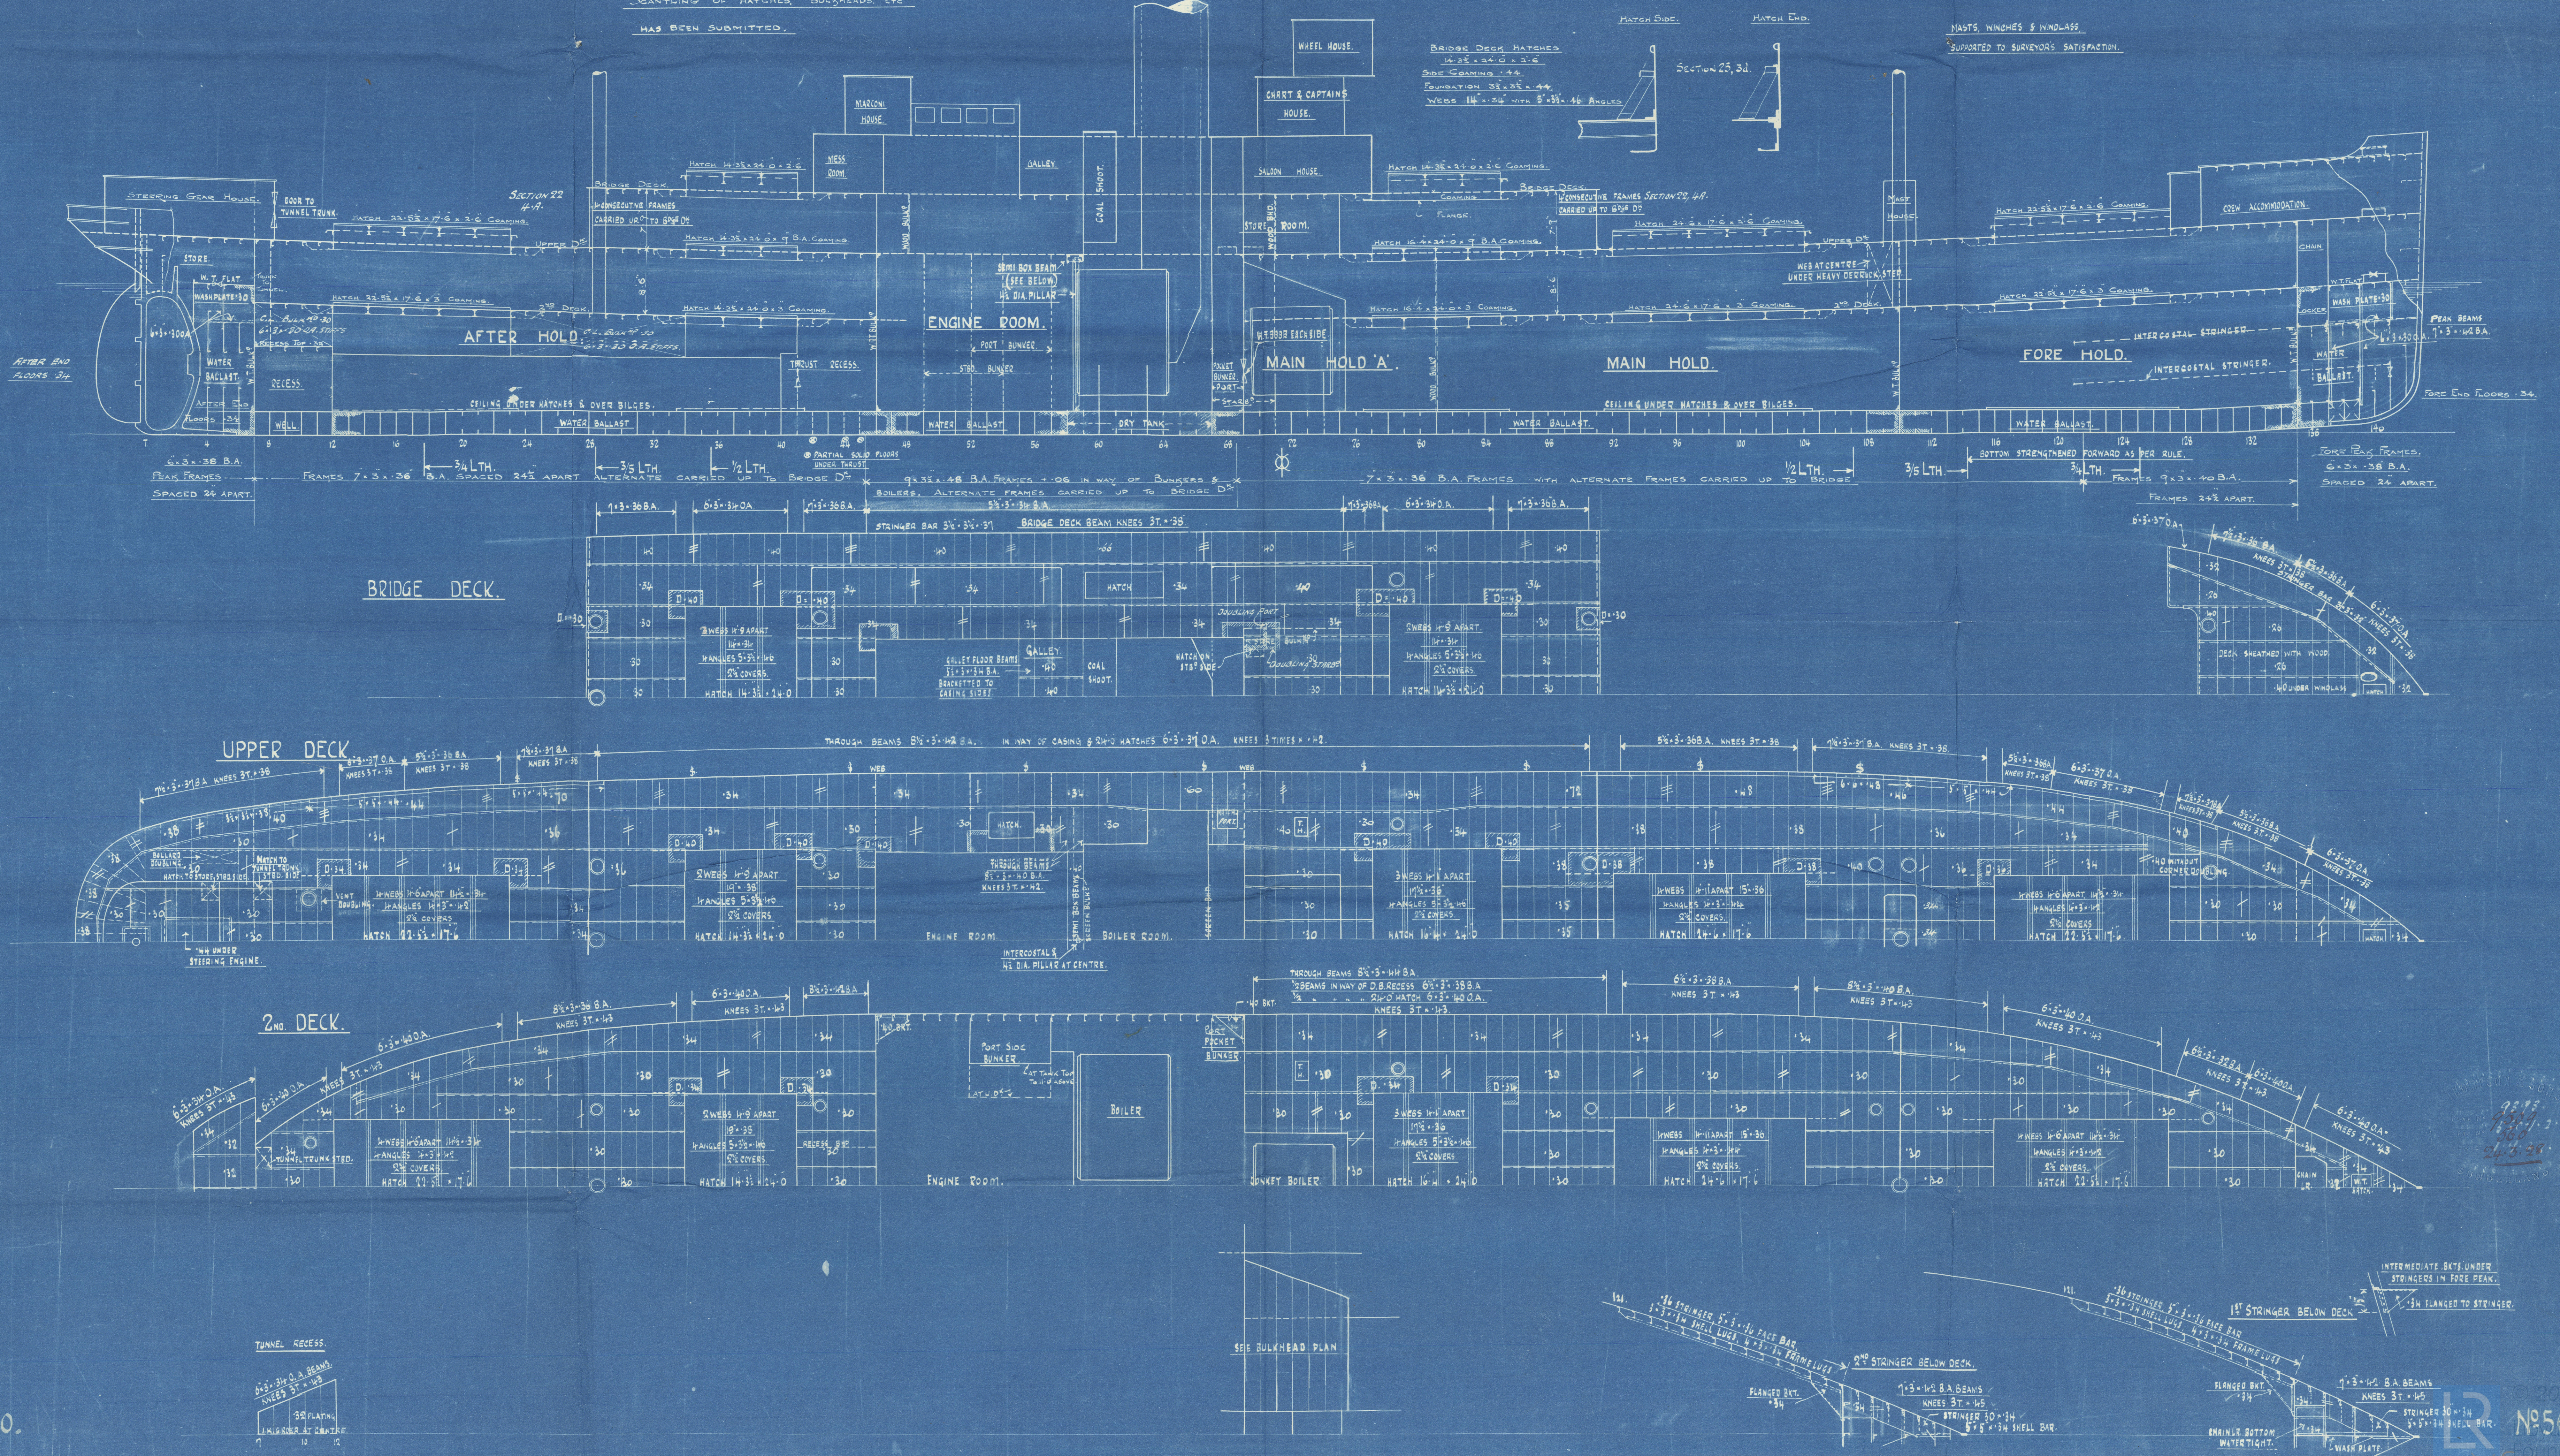

Sunderland.

J. L. Thompson & Sons.

Profile & Decks.

— No 560. —


S.S. "BOSNIA".

(— as built. —)



SUNDERLAND RPT. NO. 29682

RETAIN

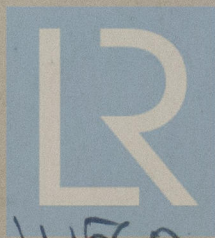

© 2020

Lloyd's Register
Foundation

W560-0118