


24. 2-10

No 297 I.S.S.

Longitudinal Section of I.S.S. 470'-0" x 58'-0" x 34'-5" to Upper Deck.
- To Class 100 R.I. Lloyds -

- Scale 1/4" = 1' -

Deck plans to be submitted.

 

Bulkheads etc. stepped 1 Mac forward

New plan will be forwarded
when prepared by Building


C.F.

24/2/10

R

© 2021 Lloyd's Register Foundation
W561-0139


Star of India
Bel 1855.

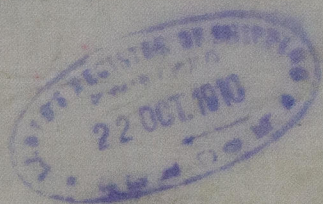

Workman Clark & Co.

No 297

Profile

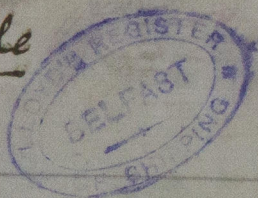

© 2021

Lloyd's Register
Foundation

W561-0139