

# MIDSHIP SECTION

LBP 359'10" - DEX 50'3" - DM 29'0"

SCALE 1/2" = ONE FOOT


RULE DIMENSIONS  
358'0" - 50'0" - 30'0"

11.11.05  
15.11.05  
18.11.05  
10.1.06  
10.7.06  
12.7.06

POOP DECK  
BEAMS 6" x 3 1/2" x 9/16" D.A. EVERY FRAME  
STRINGER PLATE 4 1/2" x 7/16"  
STRINGER ANGLE 3 1/2" x 3 1/2" x 7/16"  
STEEL DECK 9/16"  
SIDE PLATING 7/16"

BRIDGE DECK  
BEAMS 7 1/2" x 3" x 9/16" D.A. ON EVERY FRAME  
STRONG BEAMS IN ENGINE SPACE AND  
HATCH ENDS 9" x 3 1/2" x 3/16" D.A.  
HALF BEAMS 6" x 3" x 9/16" D.A. ON EVERY FRAME  
STRINGER PLATE 4 1/2" x 10/16" ANGLE 4 1/2" x 4 1/2" x 9/16"  
STEEL DECK 9/16"

FORECASTLE DECK  
BEAMS 7 1/2" x 3" x 9/16" BUILT ANGLES EVERY FRAME  
STRINGER ANGLE 3 1/2" x 3 1/2" x 7/16"  
STEEL DECK 5/16" WOOD SHEATHED

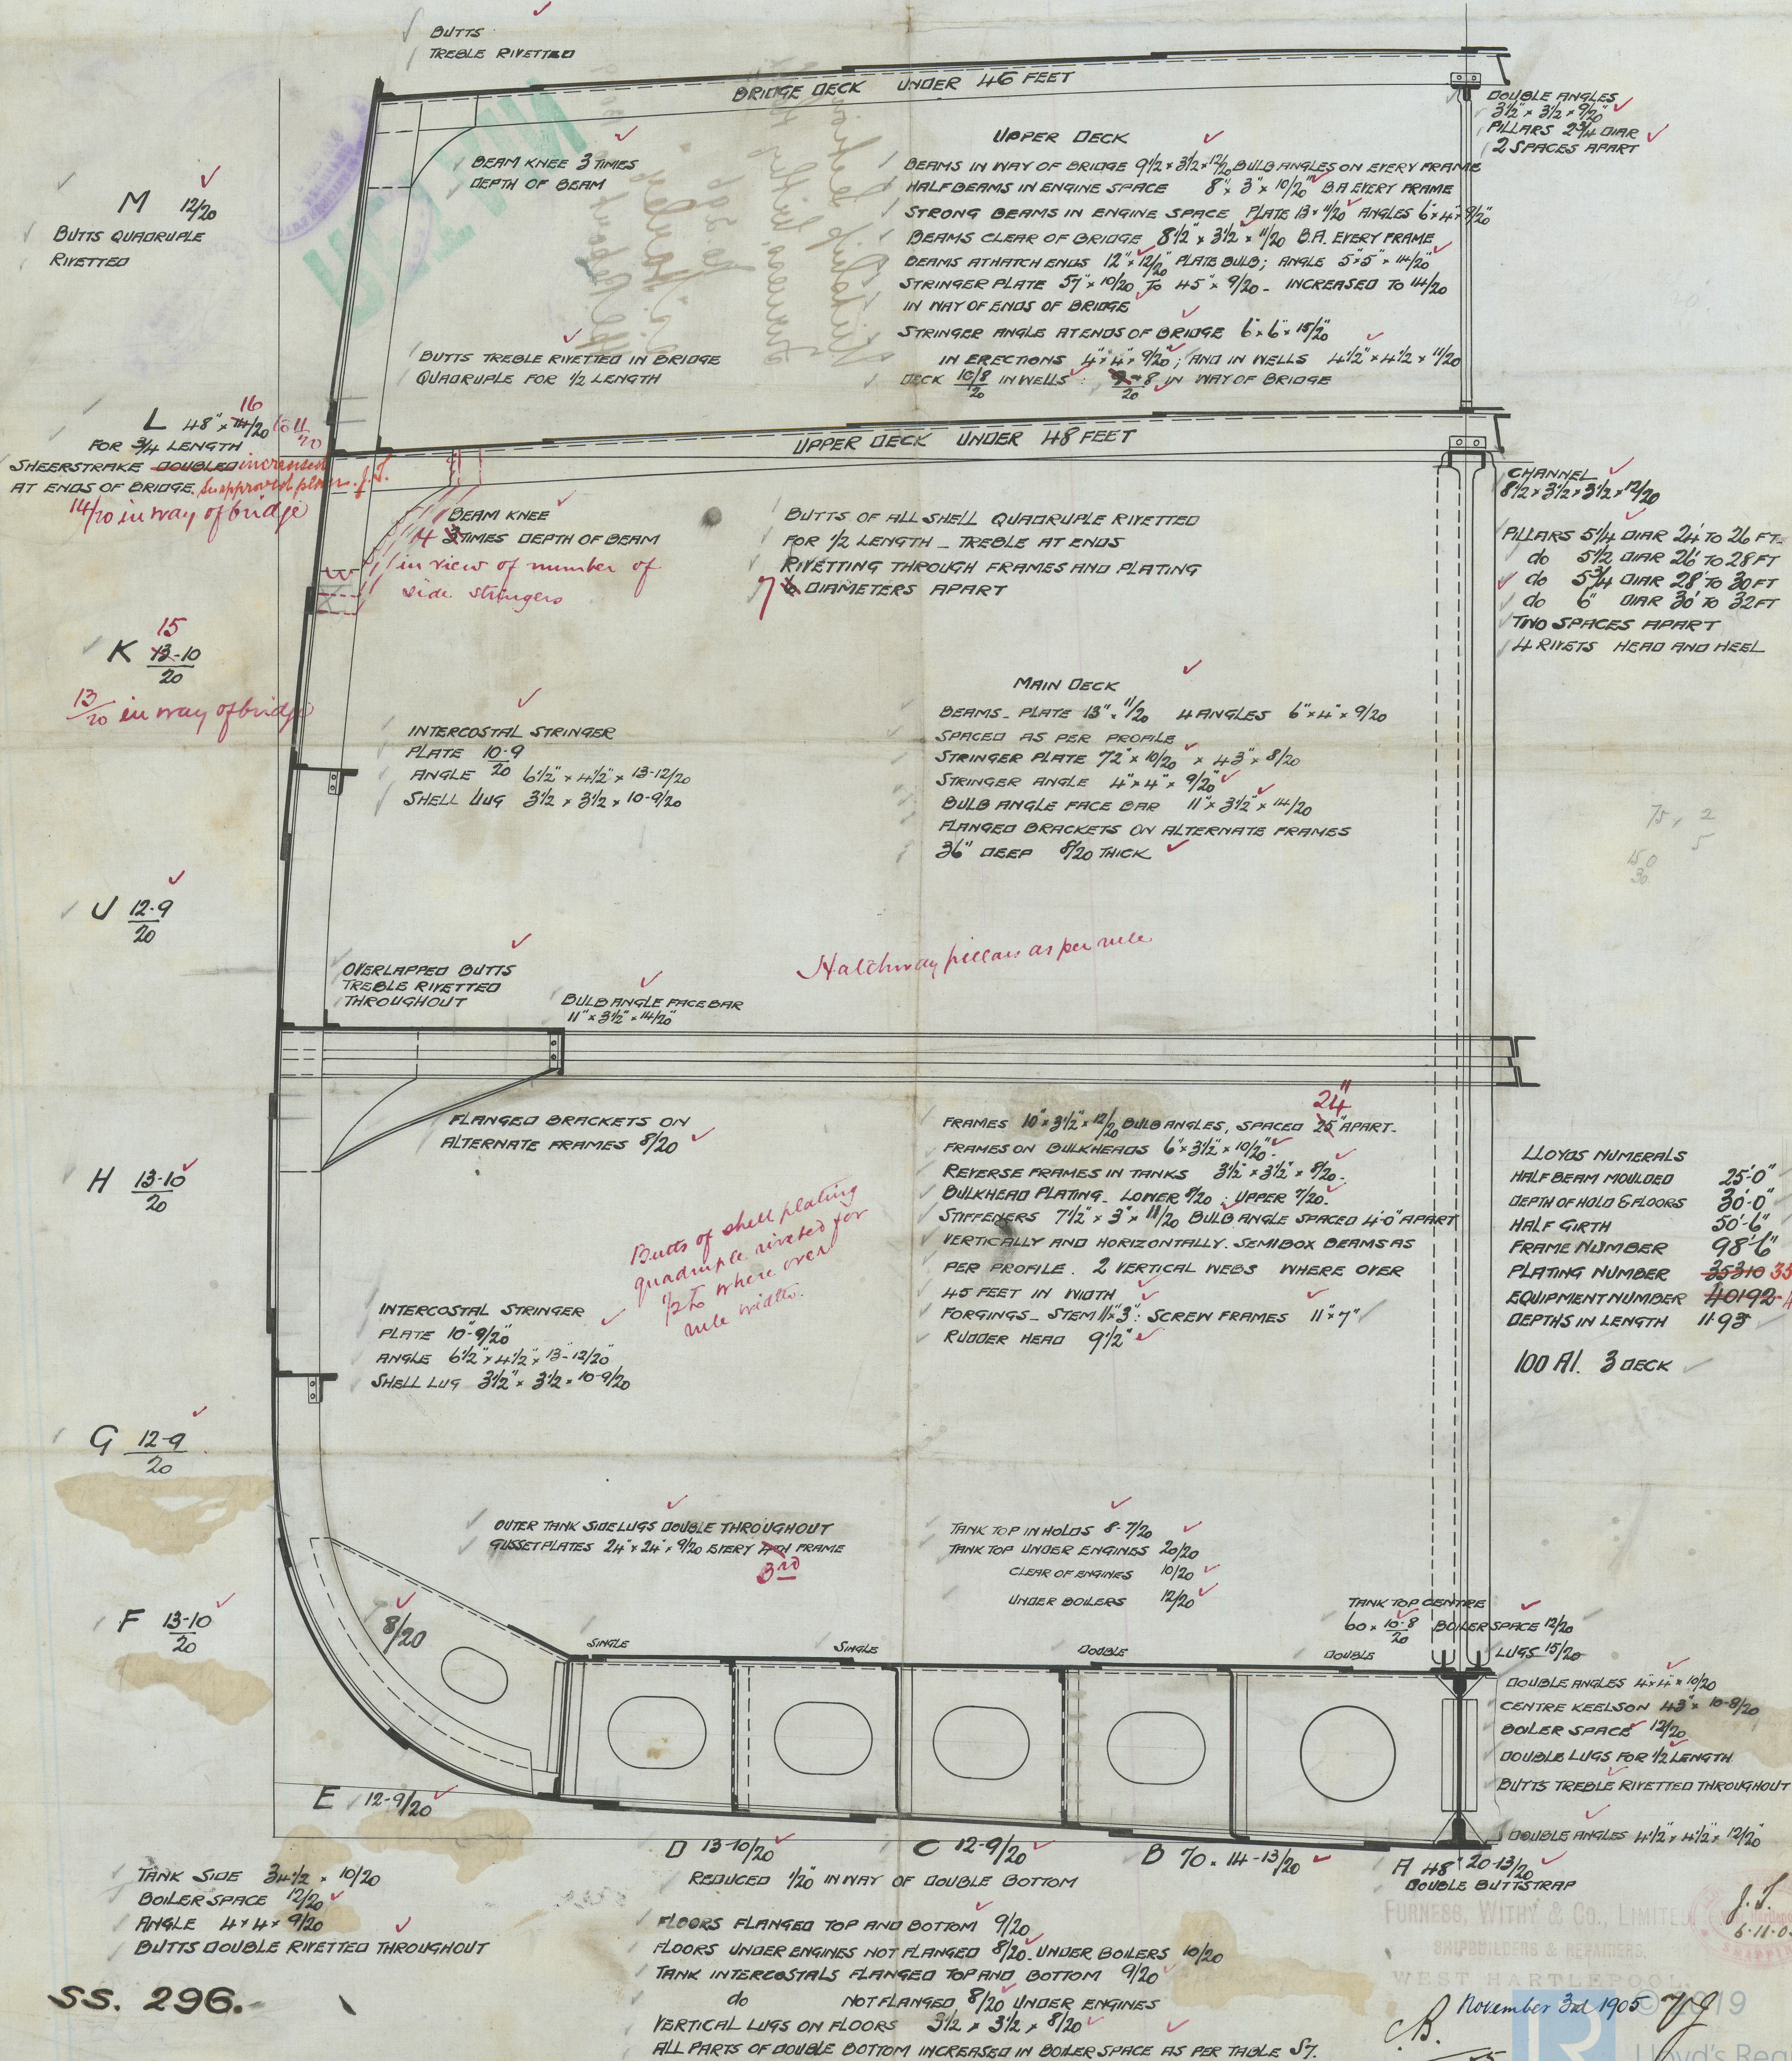




Kidship Section  
Turners, withy 160 h.

No. 296

J. S. Harley

Hpl. Report No. 13099

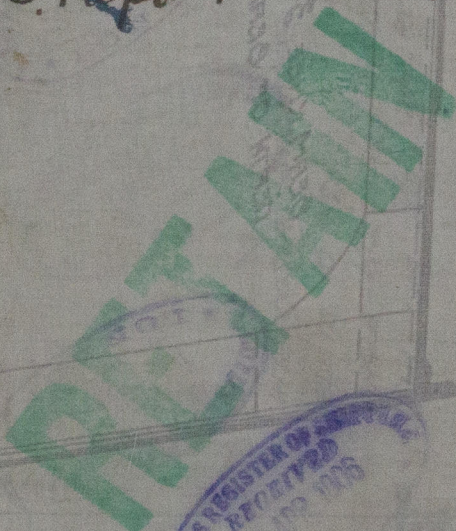

RECEIVED  
LLOYD'S REGISTER OF SHIPING



© 2019

Lloyd's Register  
WS62 Foundation