


PROFILE
№ 296.

LENGTH. 358'-0" x 50'-0" x 30'-0"

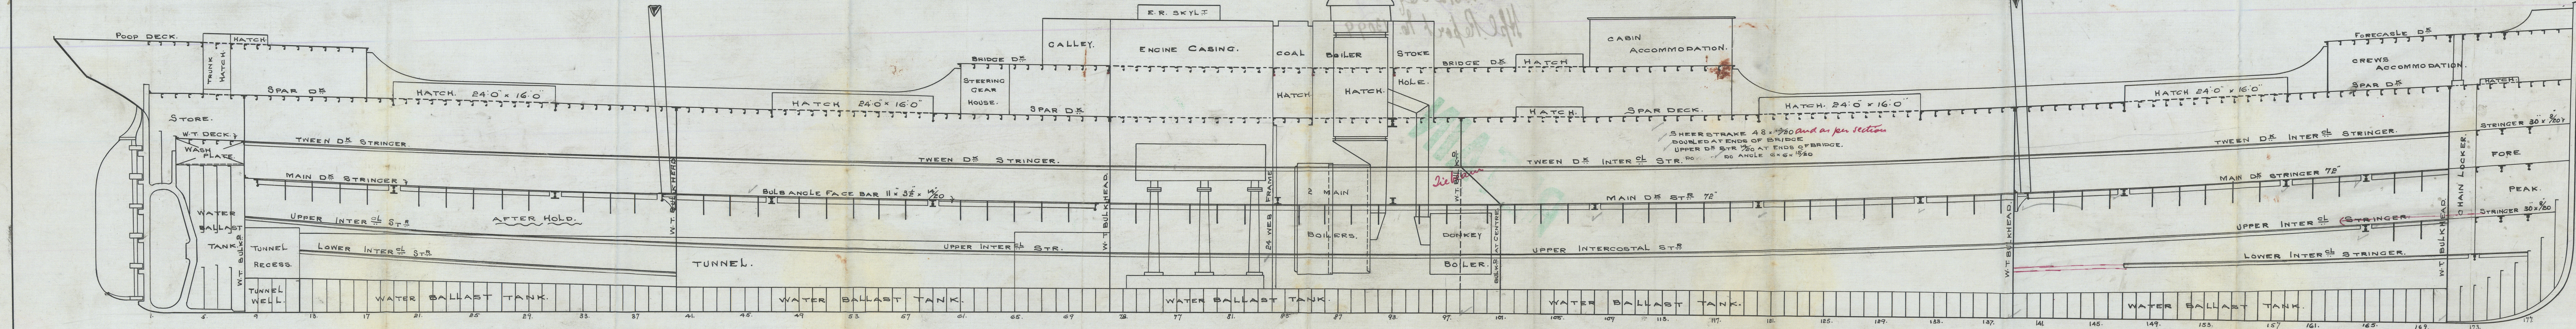

C.B.
10-7-06

J. J.
9.7.06

FURNESS, WITHEY & CO., LIMITED,
SHIPBUILDERS & REPAIRERS,
WEST HARBOR, 1901.

© 2019 Lloyd's Register Foundation

July 9/06

NS562

97569-0046
Reg
tion

W562-0096 Lloyd's Register Foundation