

25.3.19.

EQUIPMENT

ANCHOR $8\frac{1}{2}$ CWT STOCKLESS
" $8\frac{1}{2}$ " " "
" $3\frac{1}{2}$ " EX STOCK
180 FATHOMS $1\frac{1}{8}$ " STUD LINK CABLE
60 " 7" HAWSER
60 " $5\frac{1}{2}$ " WARP

N^o 368.

MIDSHIP SECTION.

SCALE $\frac{1}{2}$ " = 1 FOOT

DIMENSIONS 140' 0" B.P. x 25' 0" MLD x 13' 10" MLD.


CLASS 100A STEAM TRAWLER

STEEL.

LLOYD'S NUMBERS


L = 140' 0" -
B+D = 38' 83" -
d = 12' 41" -
L x (B+D) = 5436' 20" -
 $\frac{L}{D}$ = 10' 12" -

NUMERAL FOR RUDDER 73 SPEED 10 1/2 KNOTS

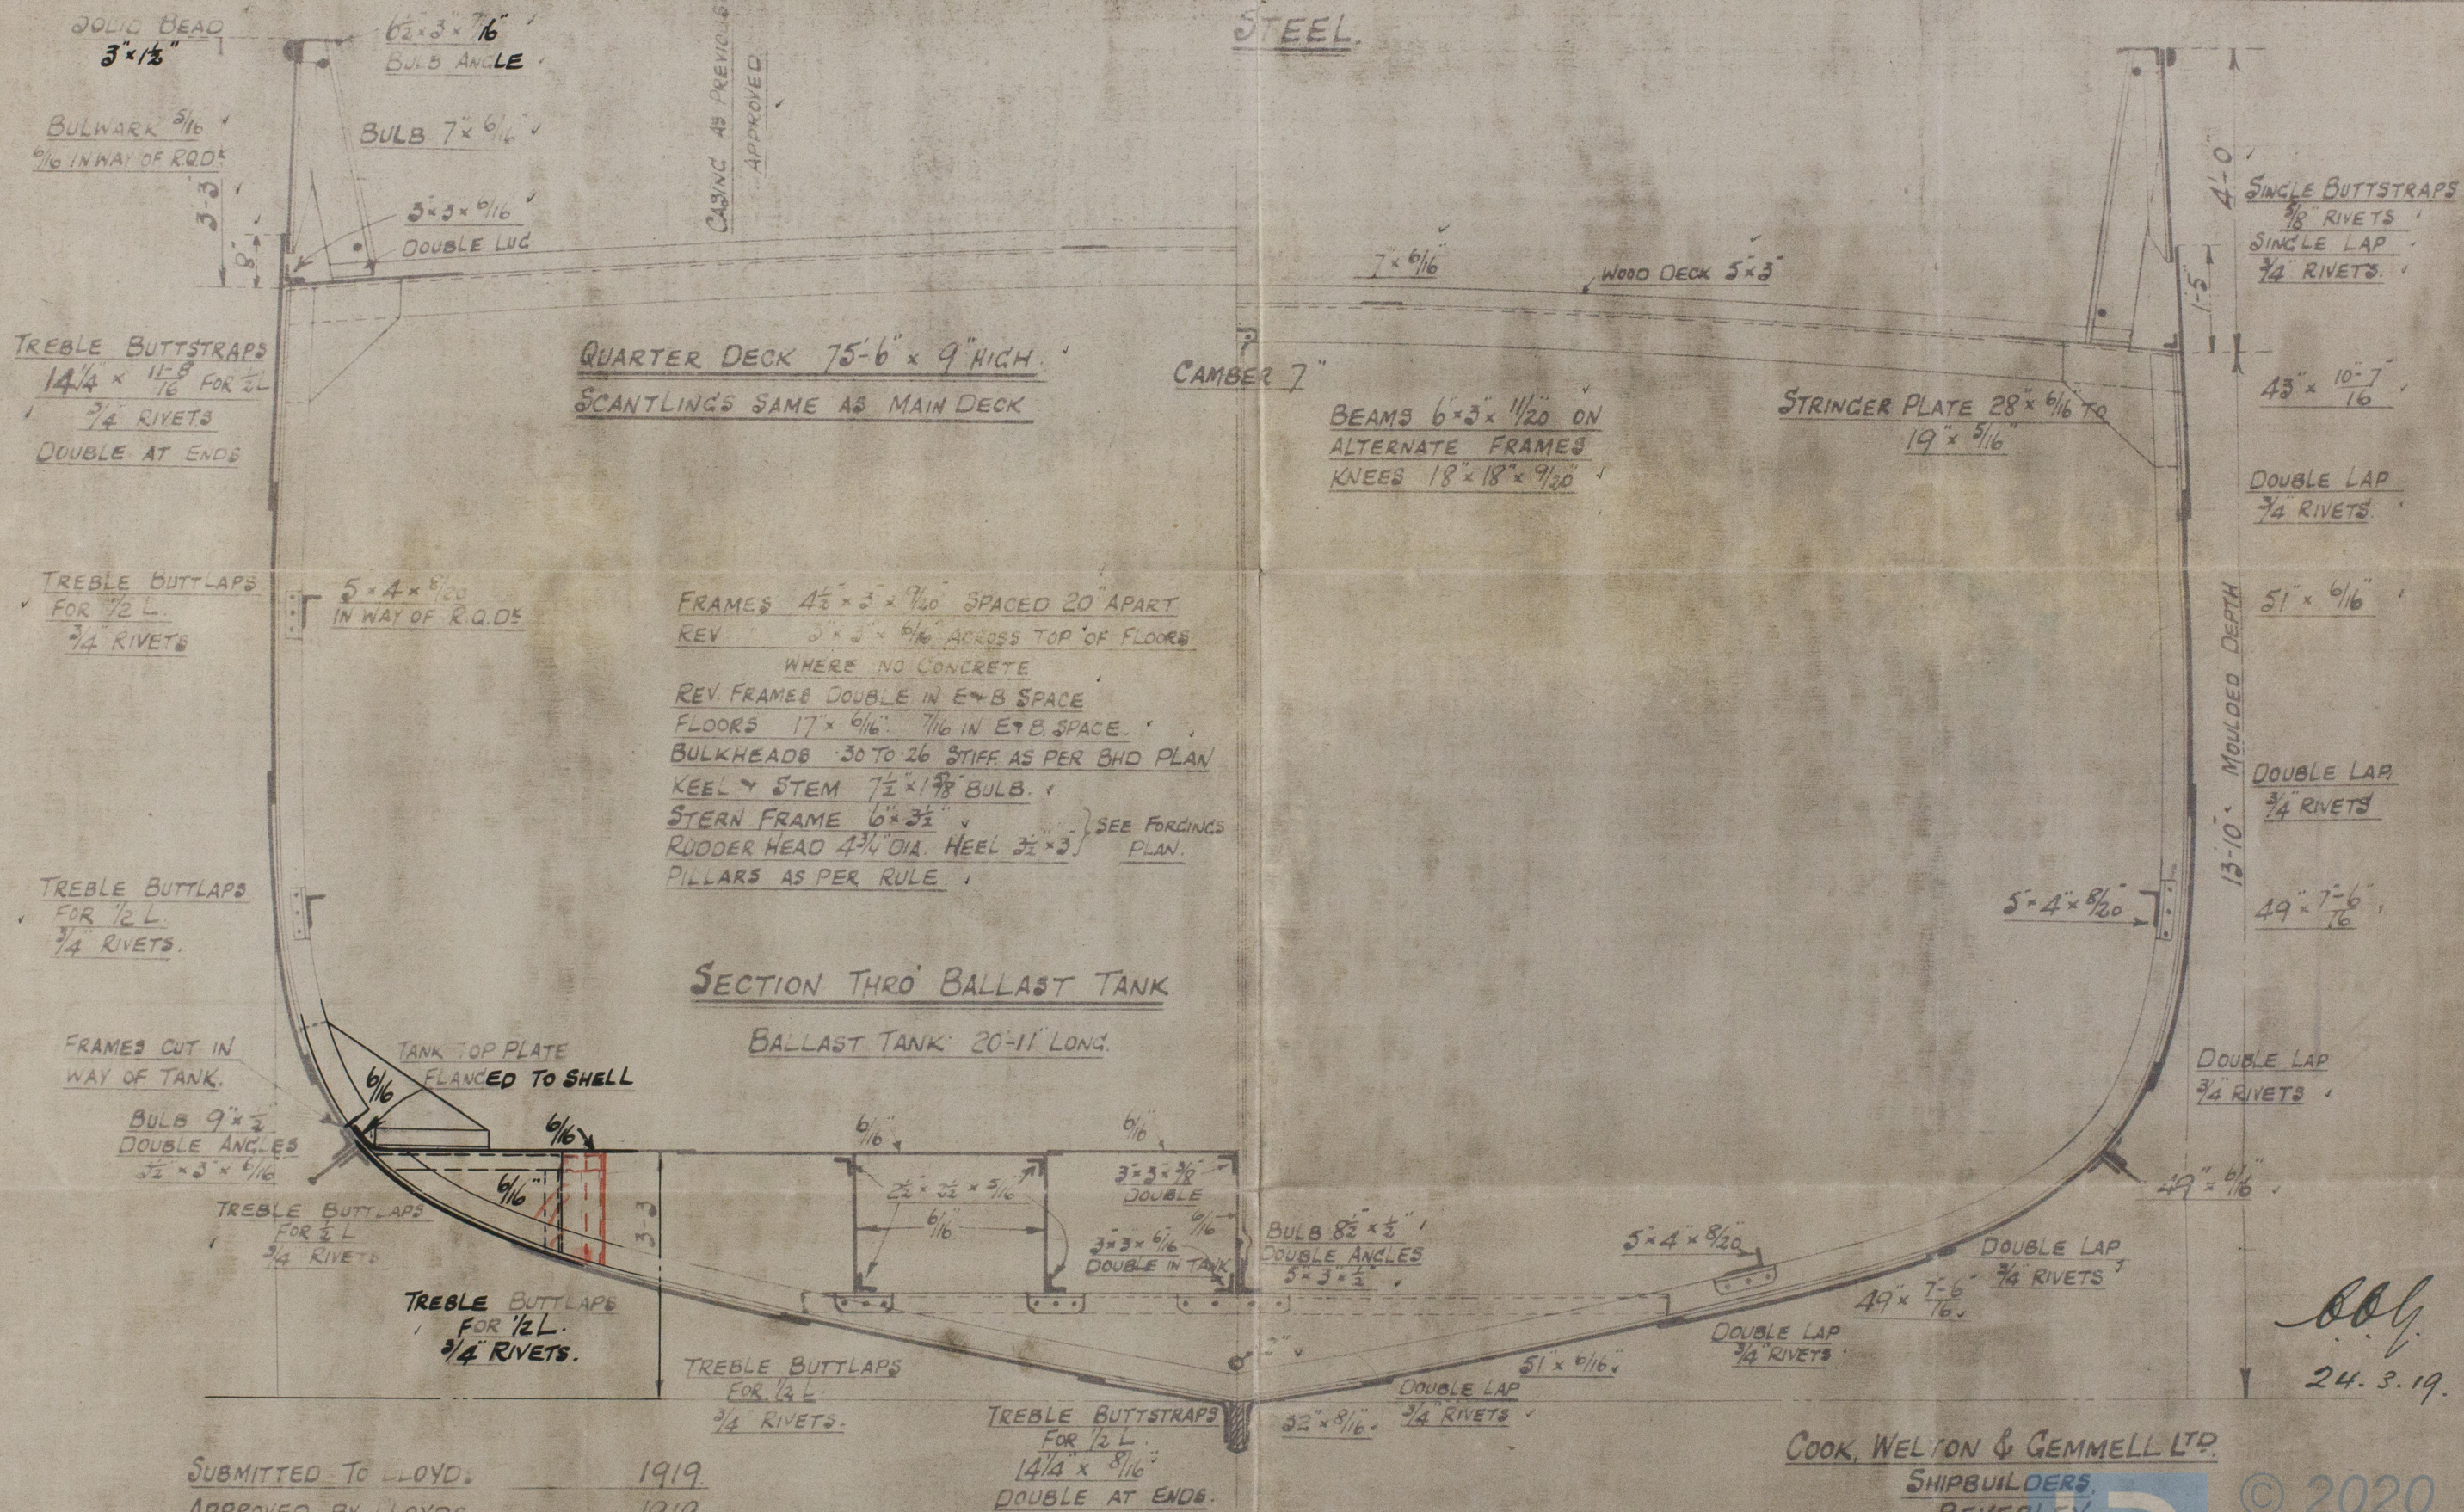

COOK, WELTON & GEMMELL LTD.
SHIPBUILDERS,
BEVERLEY.

24.3.19.

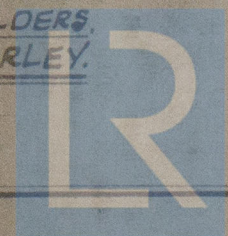

© 2020
Lloyd's Register
Foundation
W 563 0114

MIDSHIP SECTION.

COOK WELTON Y GEMMELL

N^o 368

s/s. Skuli Fogeti Hull R/bk 31801



RETAIL



© 2020

Lloyd's Register
Foundation

W563-0114