


28.3.01
 1.4.01 (N. 261)
 17.5.01
 8.7.01
 16.8.01

28.3.01
 1.4.01 (N. 261)
 17.5.01
 8.7.01
 16.8.01

PROFILE

SCALE 1" = 100 FT
 DIMENSIONS 400 x 52 x 32-1 1/2 D.M.

28.3.01
 1.4.01 (N. 261)
 17.5.01
 8.7.01
 16.8.01

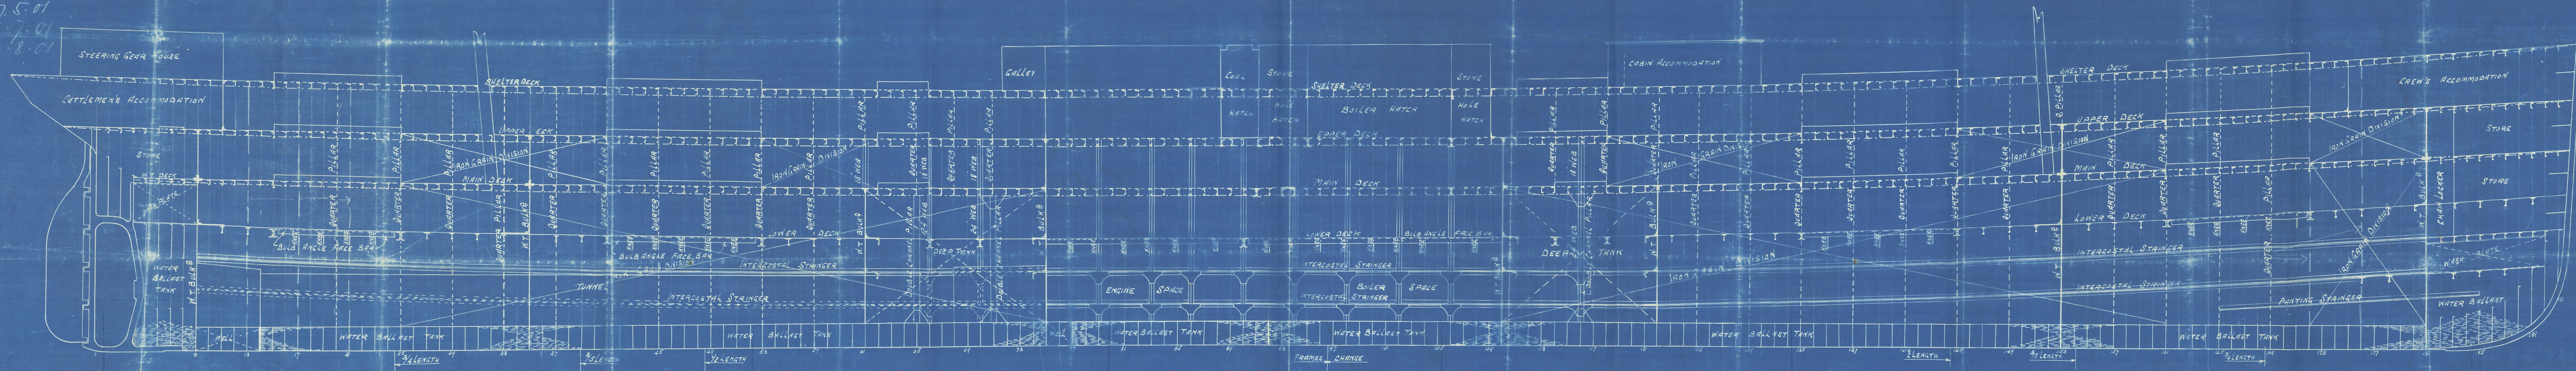

No 260
 Also N. 261
 app. 1/4/01.

Bottom is to be strengthened in accordance with the amended
 No 260.
 March 25th 1901
 Lloyd's Register
 W 563-0161


MAILED

Mepp: Jarmess. Nithy TC
N-260. S. S. Slotendyk

Copy of P Profile

Hpl. Report No. 11984

© 2020

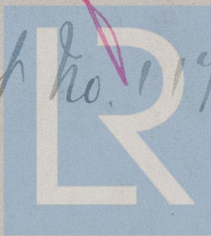

Lloyd's Register
Foundation

W563-0161