


8.1.06

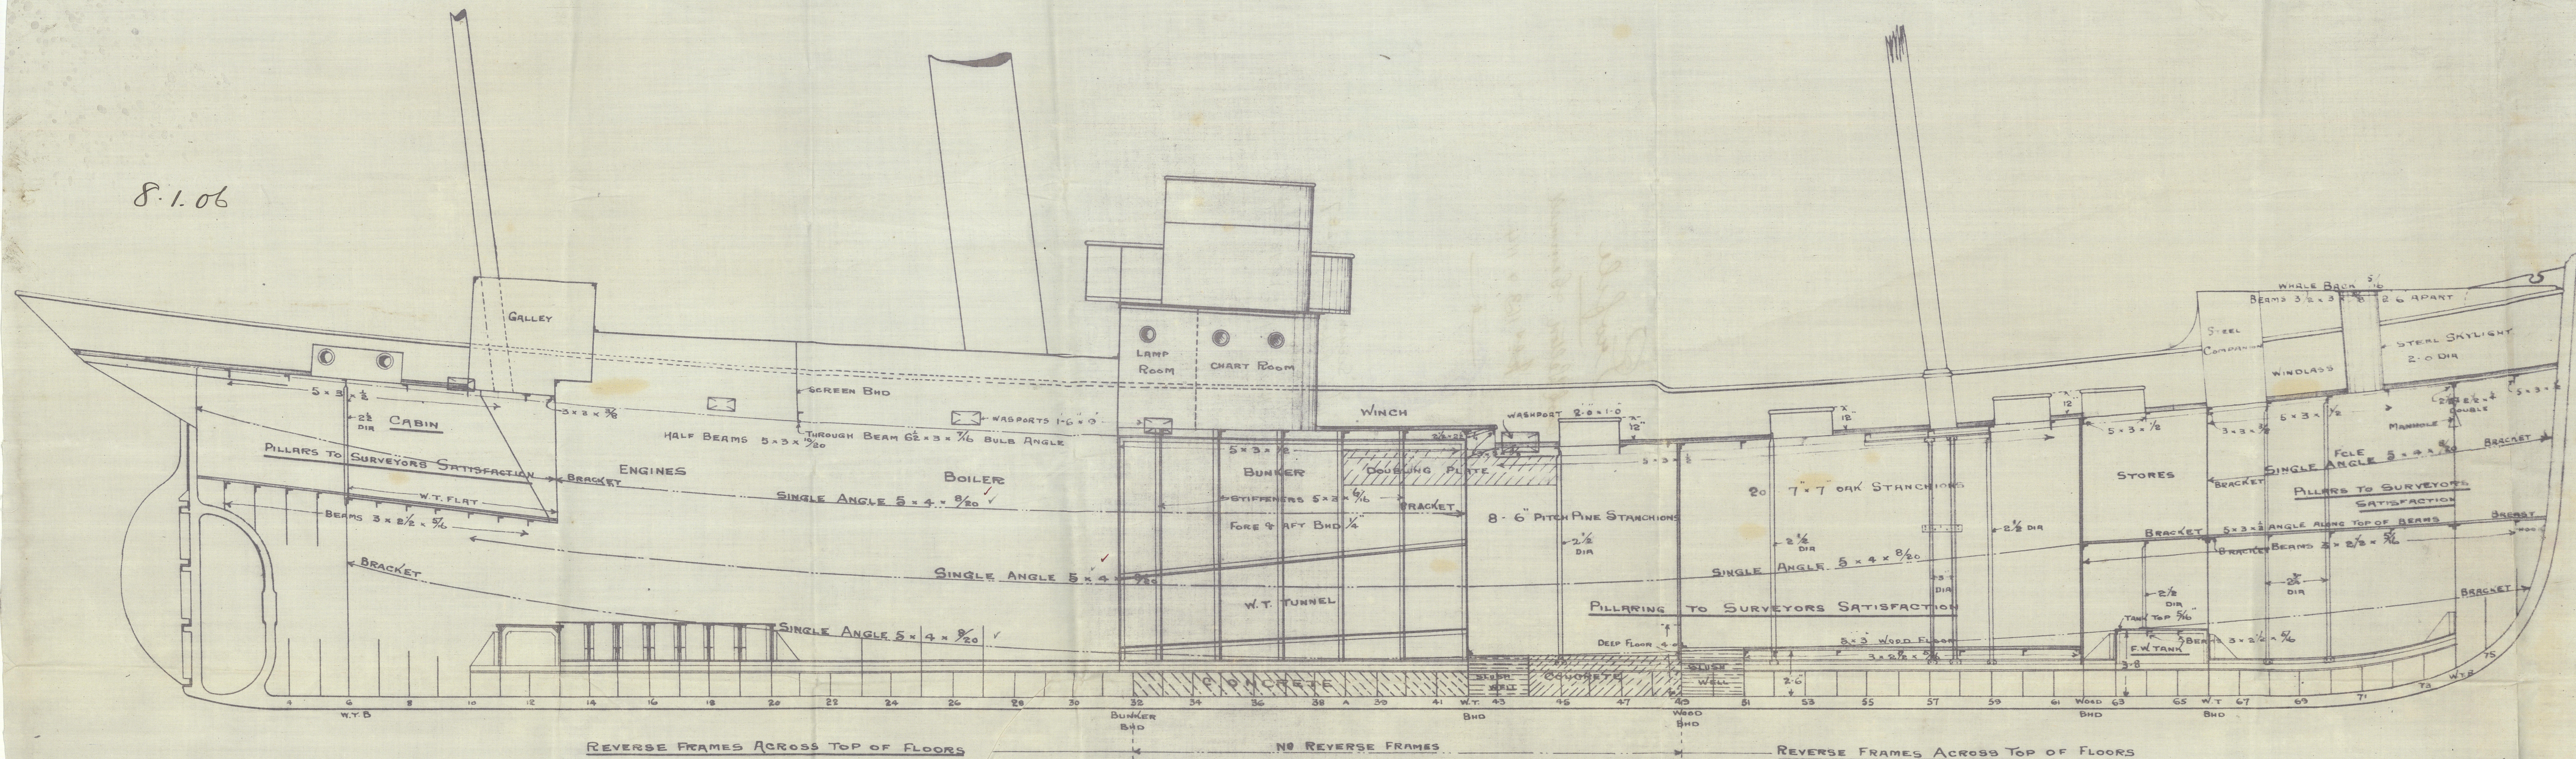


# — BEAM ARRANGEMENT —

SCALE 1/4" = ONE FOOT

— S.S. No 113 & 114 —

— ALL PILLARING TO SURVEYORS SATISFACTION —

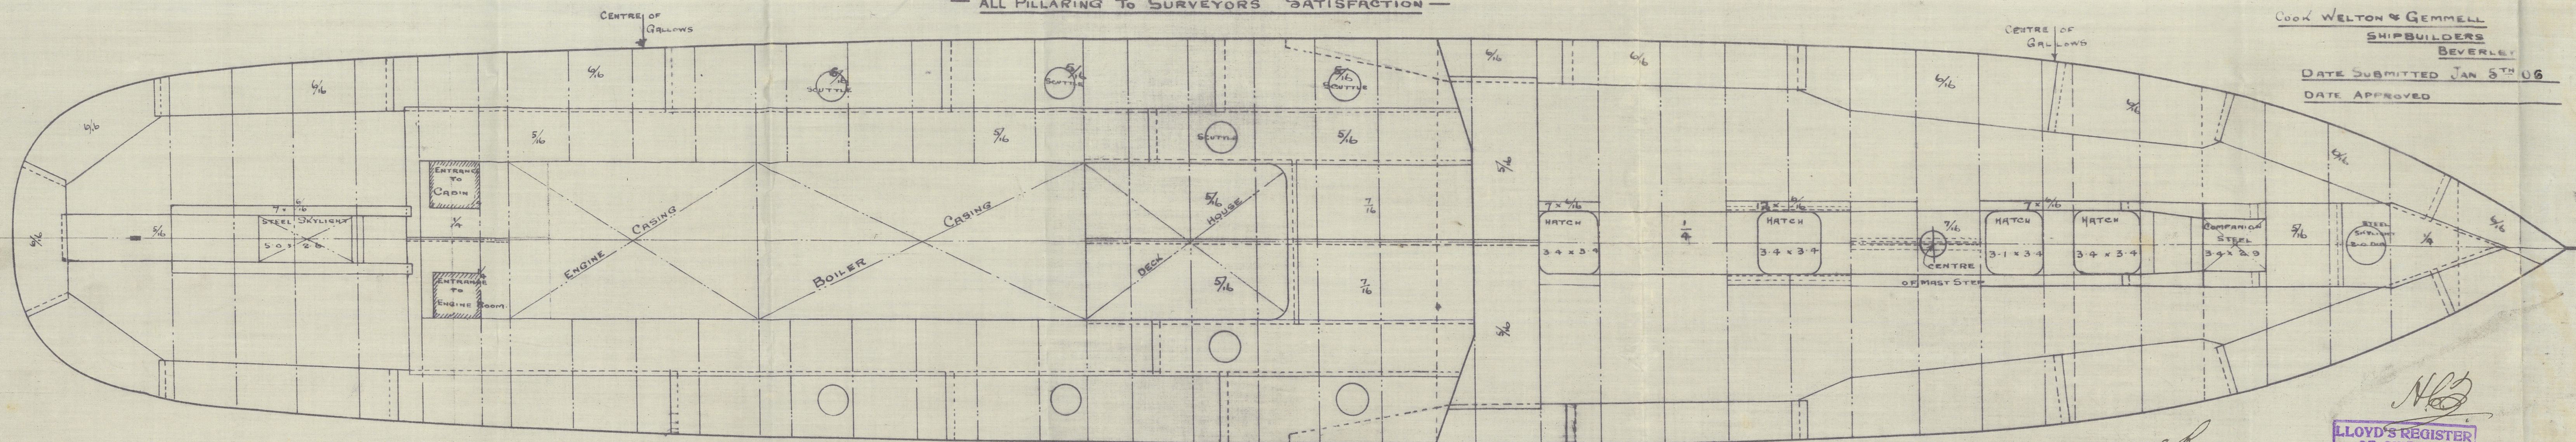

COOK WELTON & GEMMELL

SHIPBUILDERS

BEVERLEY

DATE SUBMITTED JAN 5<sup>TH</sup> 06

DATE APPROVED

8.1.06

LLOYD'S REGISTER  
OF SHIPPING  
6<sup>TH</sup> JAN. 1906  
+ HULL

© 2020


Lloyd's Register  
W56310270



# Profile

Cook Welton & Gemmell

nos 113 & 114

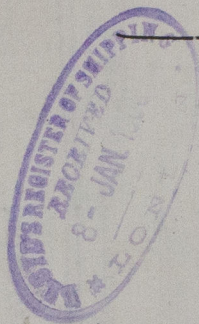

RETAIN

s/s "Sicyon"  
Hull Report no. 18287

s/s Pretoria  
Hull Report no 182<sup>99</sup>~~87~~

W563-0270



© 2020

Lloyd's Register  
Foundation