

# MIDSHIP SECTION

SCALE  $\frac{1}{2} = 1$  FOOT —

DIMENSIONS: 130-0 BP x 22.3 Ex x 12.3 HOLD —

— CLASS 100.A.1. —


— FOR FISHING PURPOSES —

- STEEL -

- EQUIPMENT -			
ONE ANCHOR	5 <sup>3</sup> / <sub>4</sub>	CWT EX	STOCK
" "	5 <sup>1</sup> / <sub>4</sub>	" "	" "
" "	3	" "	" "
105 FTHMS 1 <sup>1</sup> / <sub>2</sub>	CHAIN	✓	✓
60 " 6"	HAWSER	✓	✓
60 " 5"	WARP	✓	✓

— LLOYD'S N<sup>OS</sup> —

<u>2</u> GIRTH	20 30 ✓	
<u>2</u> BREADTH	11 04 ✓	
<u>DEPTH</u>	<u>13 58</u> ✓	
	45 12 ✓✓	1 <sup>ST</sup> N <sup>O</sup>
<u>LLOYD'S LENGTH</u>	<u>128 83</u>	
	58 12 80 ✓✓	2 <sup>ND</sup> N <sup>O</sup>
$\frac{L}{B} =$	<u>5 8</u>	$\frac{L}{D} =$ <u>9 4</u> ✓

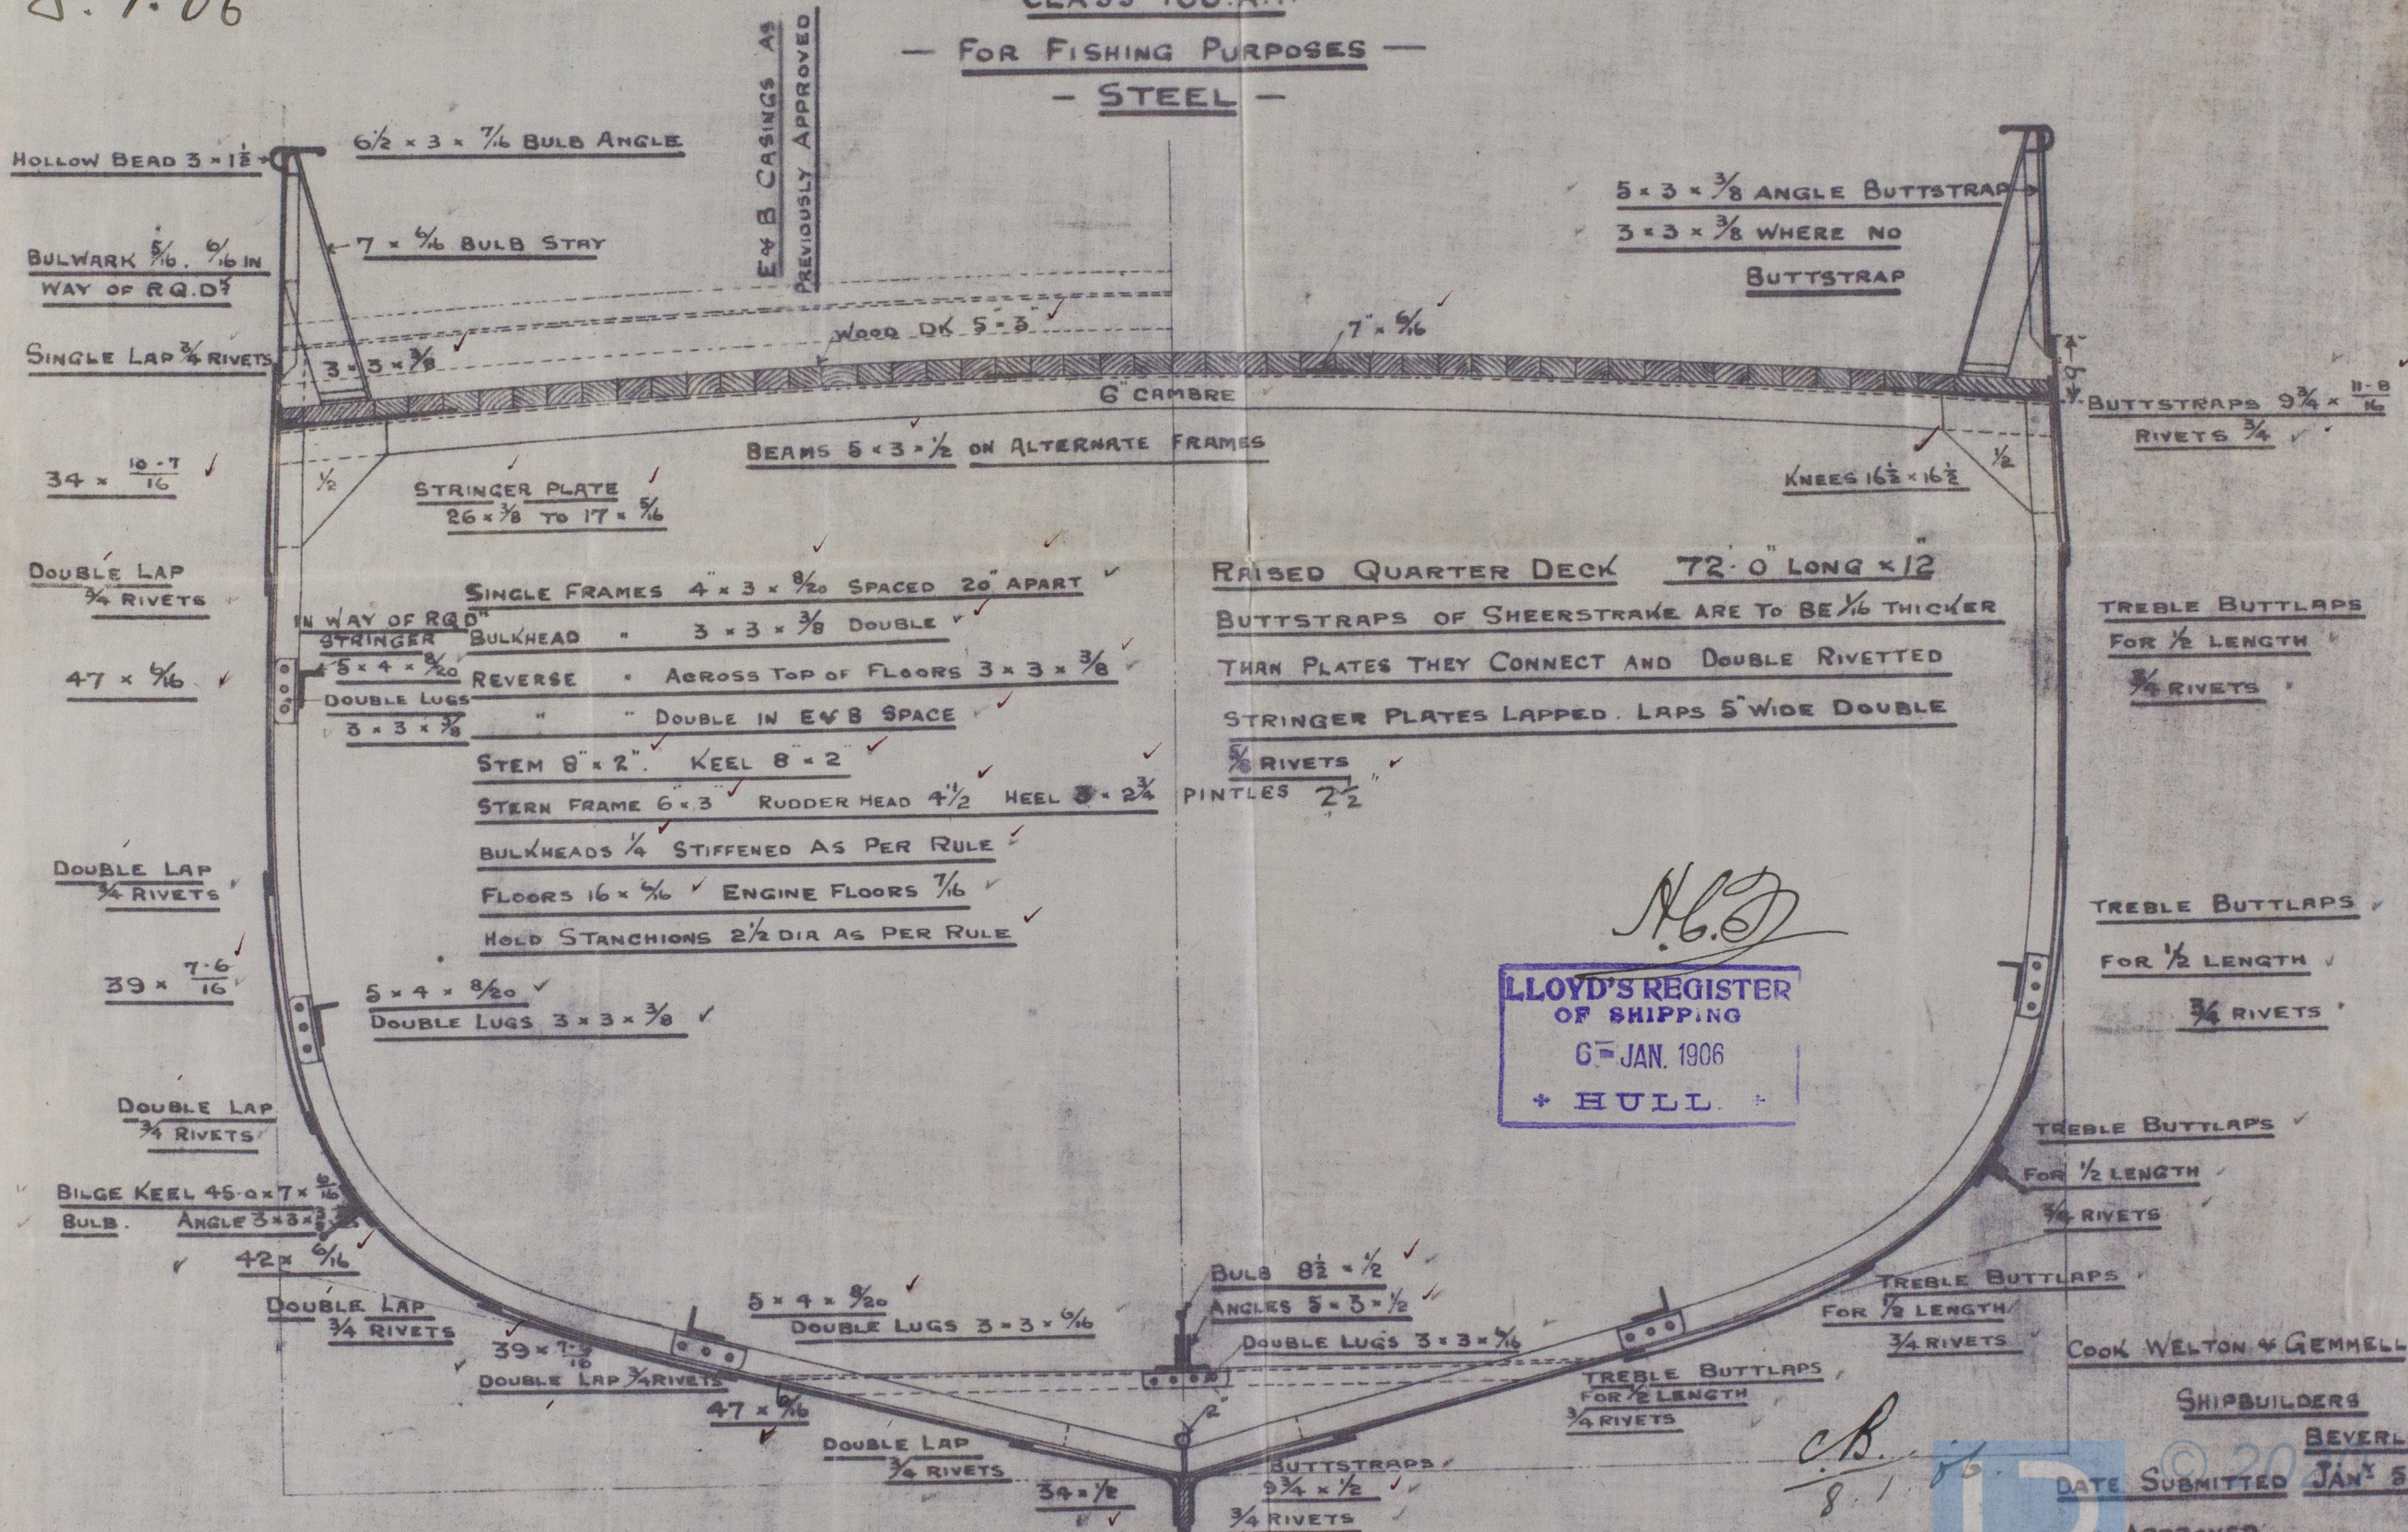

LLOYD'S REGISTER  
OF SHIPPING  
6 JAN. 1906  
\* HULL \*

COOK WELTON & GEMMELL

SHIPBUILDERS

BEVERLEY

DATE SUBMITTED JAN 5<sup>TH</sup> 06


APPROVED


Lloyd's Register  
F563-027



Midship Section  
Cook Welton & Gemmells

No. 113 & 114

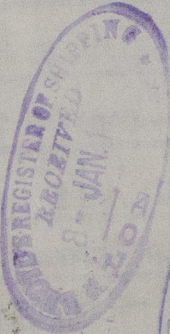  
1/5 Sicily 18287  
Hull Report ~~18230~~

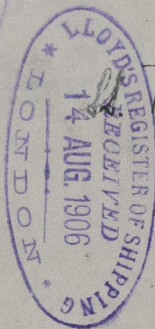

Pretoria  
Jul. 18299

RETAIN

W563-0271



© 2020

Lloyd's Register  
Foundation