

7000-V

PROPOSAL 33
PLAN L.I.
DATE 29.11.04

Nº 607

PROPOSED TWIN SCREW STEAMER.

MOULDED DIMENSIONS

255-0 x 38-0 x 14-9

S. RAMA

TO CLASS A.I. AT LLOYDS
Rivers Parana & Plate
FOR RIVER PURPOSES ONLY.

SCALE 1/2" = 1 FOOT

PROPORTIONS

DEPTHS IN LENGTH = 16.32

BREADTHS IN " = 6.676

NUMERALS

1/2 BREADTH	19.00
DEPTH	15.54
1/2 GIRTH	31.60
	66.14 = 1 ST N°
	66.14 x 253.85 = 16793 = 2 ND N°

EQUIPMENT - Nº 19965 -

1 POWER ANCHOR 200 CWT STOCKLESS

1 STREAM 7 1/2" x 1/2" E.K. STOCK

240 250 FATHOMS STUD CHAIN CABLE 1 1/2" x 10


70 " 1 1/2" STREAM CHAIN OR 3/4" WIRE 3/4

90 " 10 HEMP OR 3/4" WIRE

2-90 " 6"

2-90 " 5"

See plate 9. 6.5/20 See Deck plan plates at machinery Stanchion plate

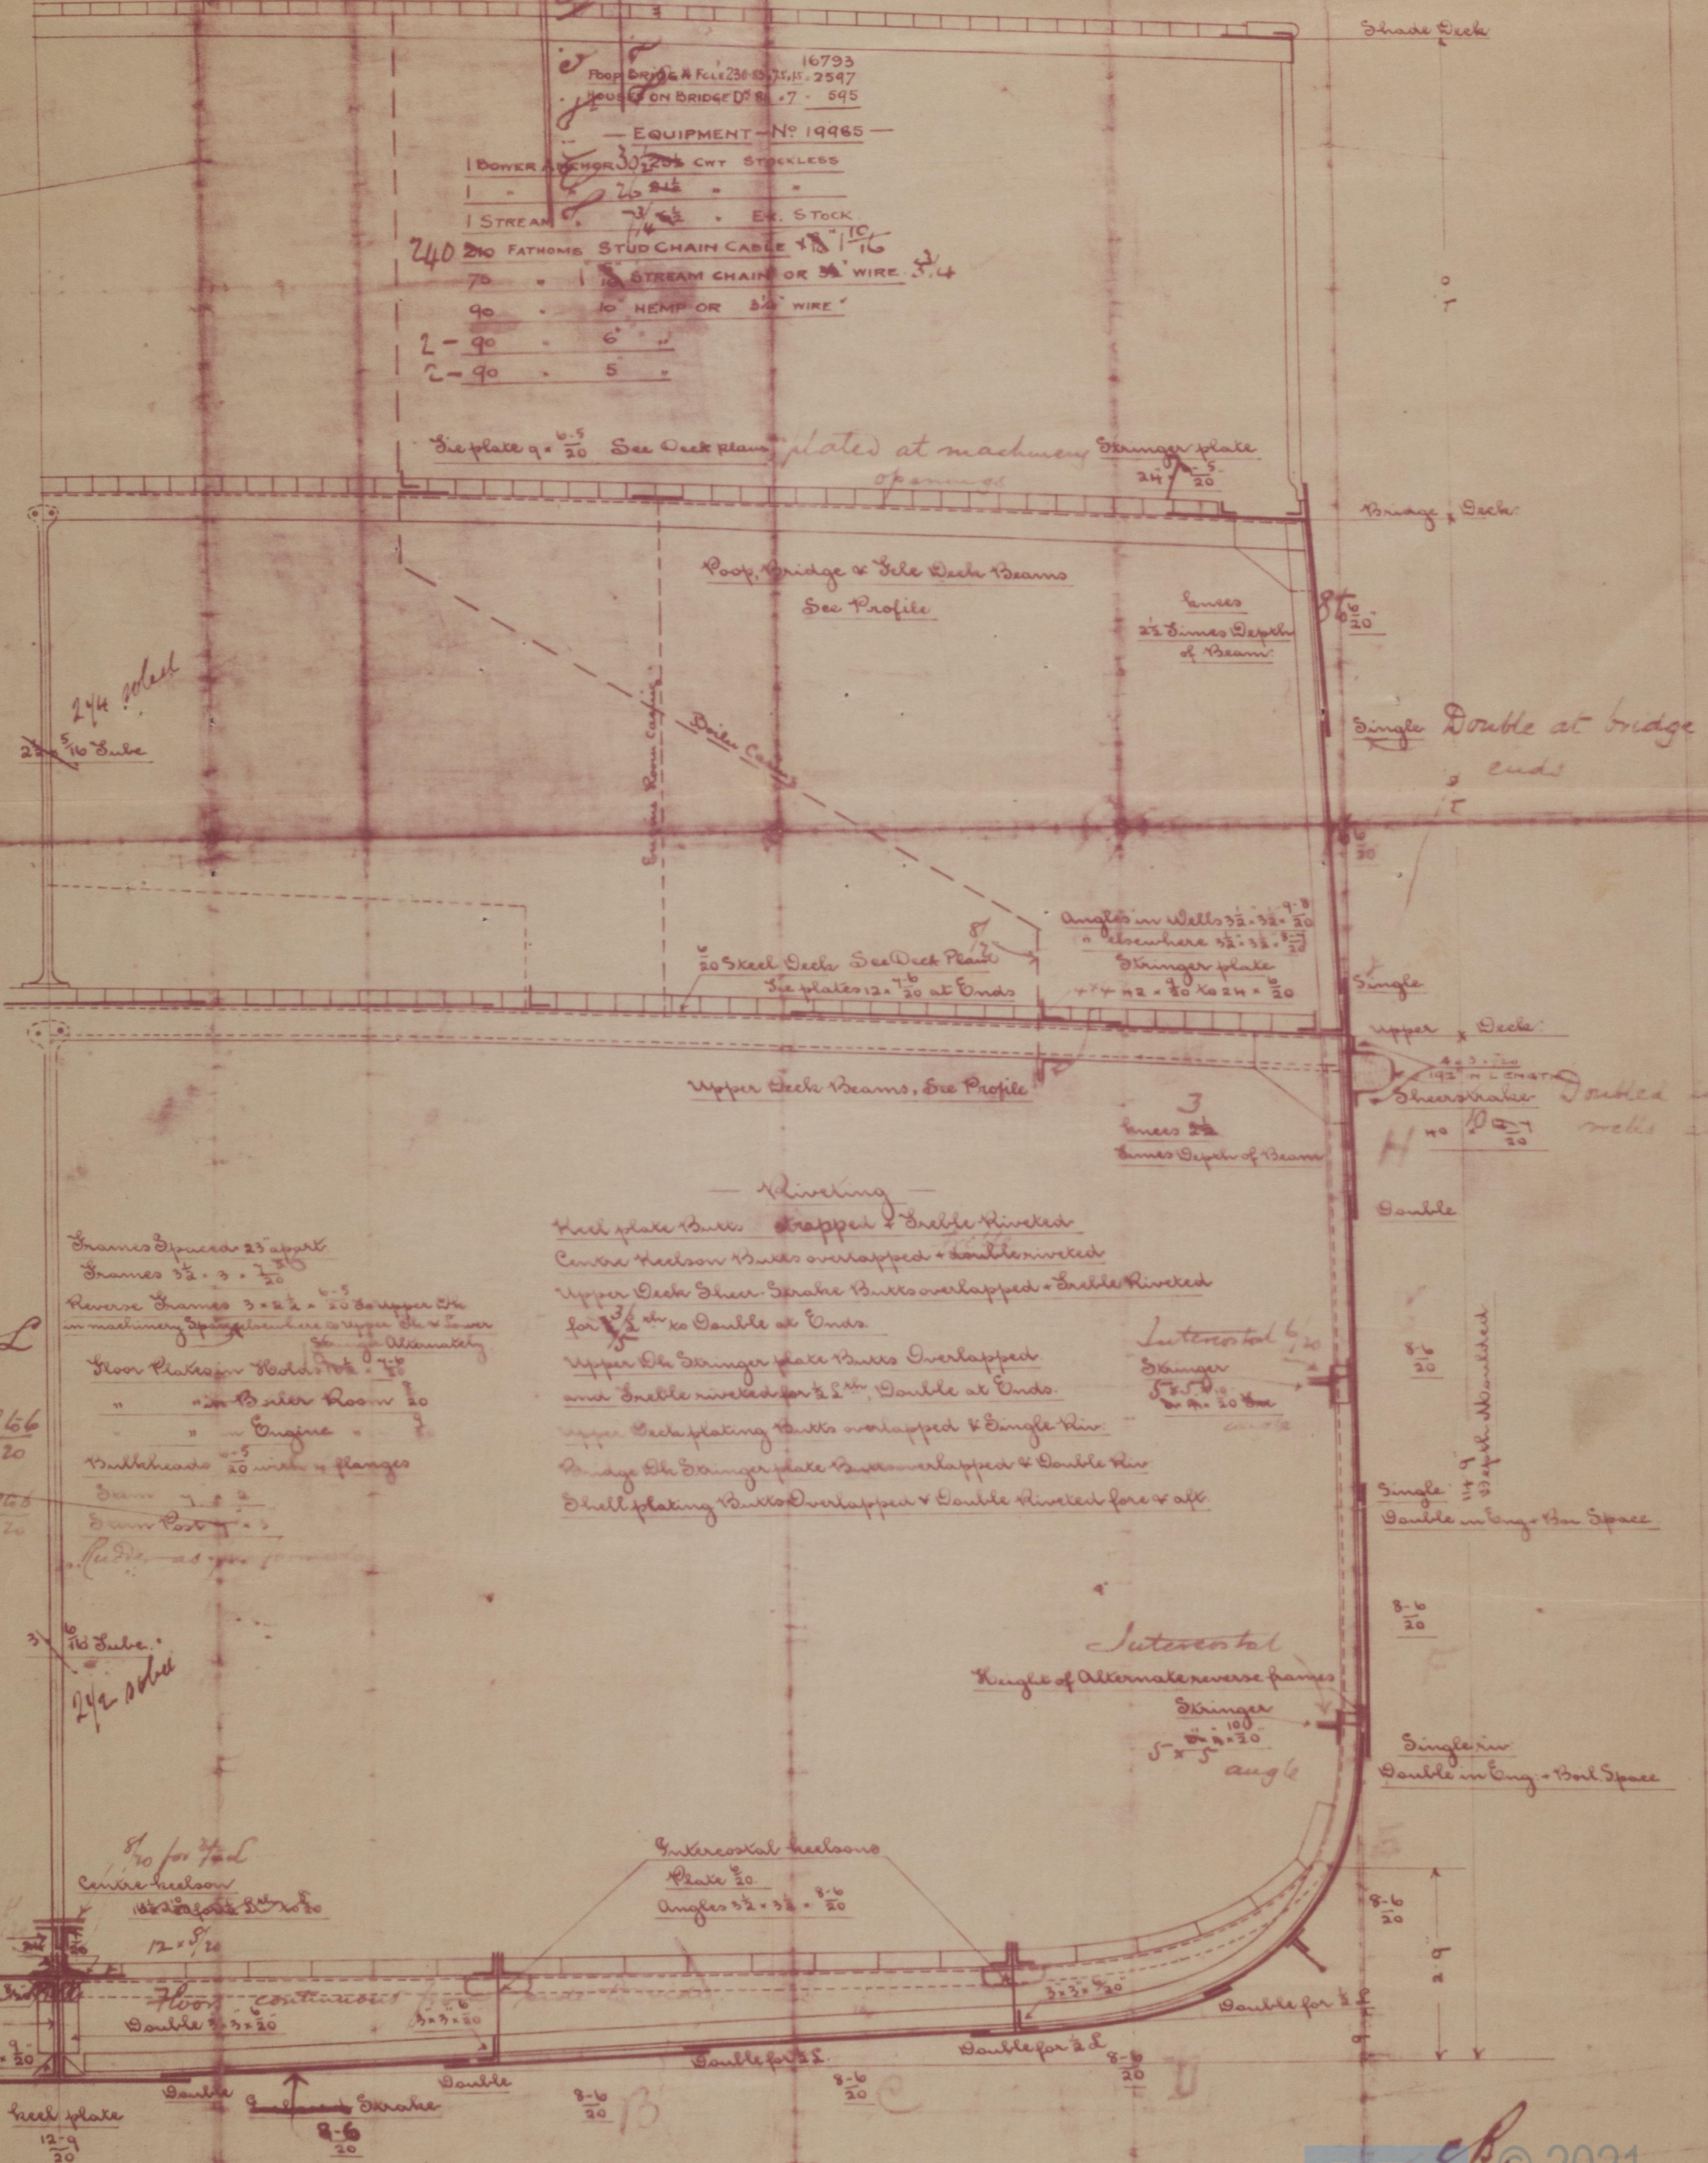

and for 3/8 L

Bull-Head 5.32 8.66
with room as
proposed 16.5 16.6

16 Sub.
242 sub.

120 for 1/2
Curve Nelson
102 2 1/2 x 3 1/2 x 20

12 x 9
Floor continuous
Double 3 x 20

hull plate
12 x 9
20

St. Y. Se. RAMA.

Midship Section

RETAIA



© 2021

Lloyd's Register
Foundation

W565-0072