

S.S. No 161

Length between J.P. 290'-0"
 Breadth moulded 38'-0"
 Depth moulded 21'-2"
 Depth midships 21'-11 1/2"

Numbers $\frac{G}{2} = 36,73$ $\frac{B}{2} = 19,0$ $D = 21,95$

$B + G + D = 77,6$

$290,0 \times 77,6 = 22533$. $\frac{G}{2} = 13-14$. $\frac{B}{2} = 7,63$

Class: 100 A. 1. Engl. Lloyd (Two decks with Shelterdeck). Steel.

Scale 1:25



Floors continuous from middle line to margin plate.

In Engine-room on every frame 1/2" thick.

In Boiler-room on every frame 1/2" thick.

In Holes " " " 1/2" if changed to 1/2" thick.

Floors and other parts of double bottom in Boiler space to be increased in thickness beyond Table S. 7.

5/6 *Prins der Nederlanden*


Ham. Rept. N° 7076

MIDSHIP SECTION.

S. S. N° 161

MESSRS BLOHM & VOSS HAMBURG.

HAM. LETTER 28/10/01.

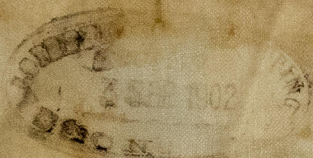

RETAIN

RETAIN

*Ham. letter as
previously*



© 2021

Lloyd's Register
Foundation

W505-0246