


PROFILE.SS.93.

JOHN PRIESTMAN & CO

SUNDERLAND

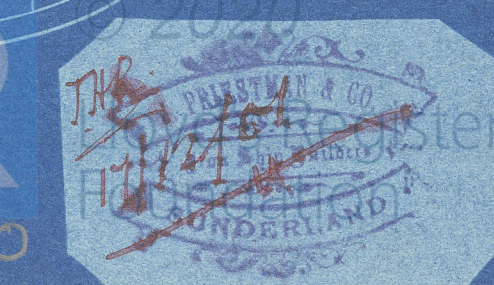

Messrs J. Priestman & Co
S.S. "No 92"

Profile as built

SS No 92 =
SS "Manabon".

Sunderland. No 20858.



© 2020

Lloyd's Register
Foundation

W566-0140