

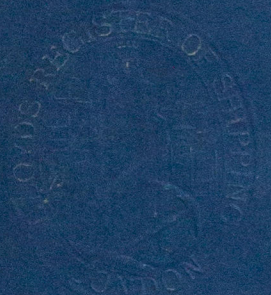


PILLAR PLAN. S.S.92.

SCALE $\frac{1}{2}$ " = ONE FOOT.

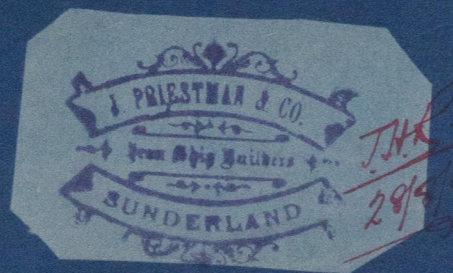

3.9.01
9.4.02
18.4.02

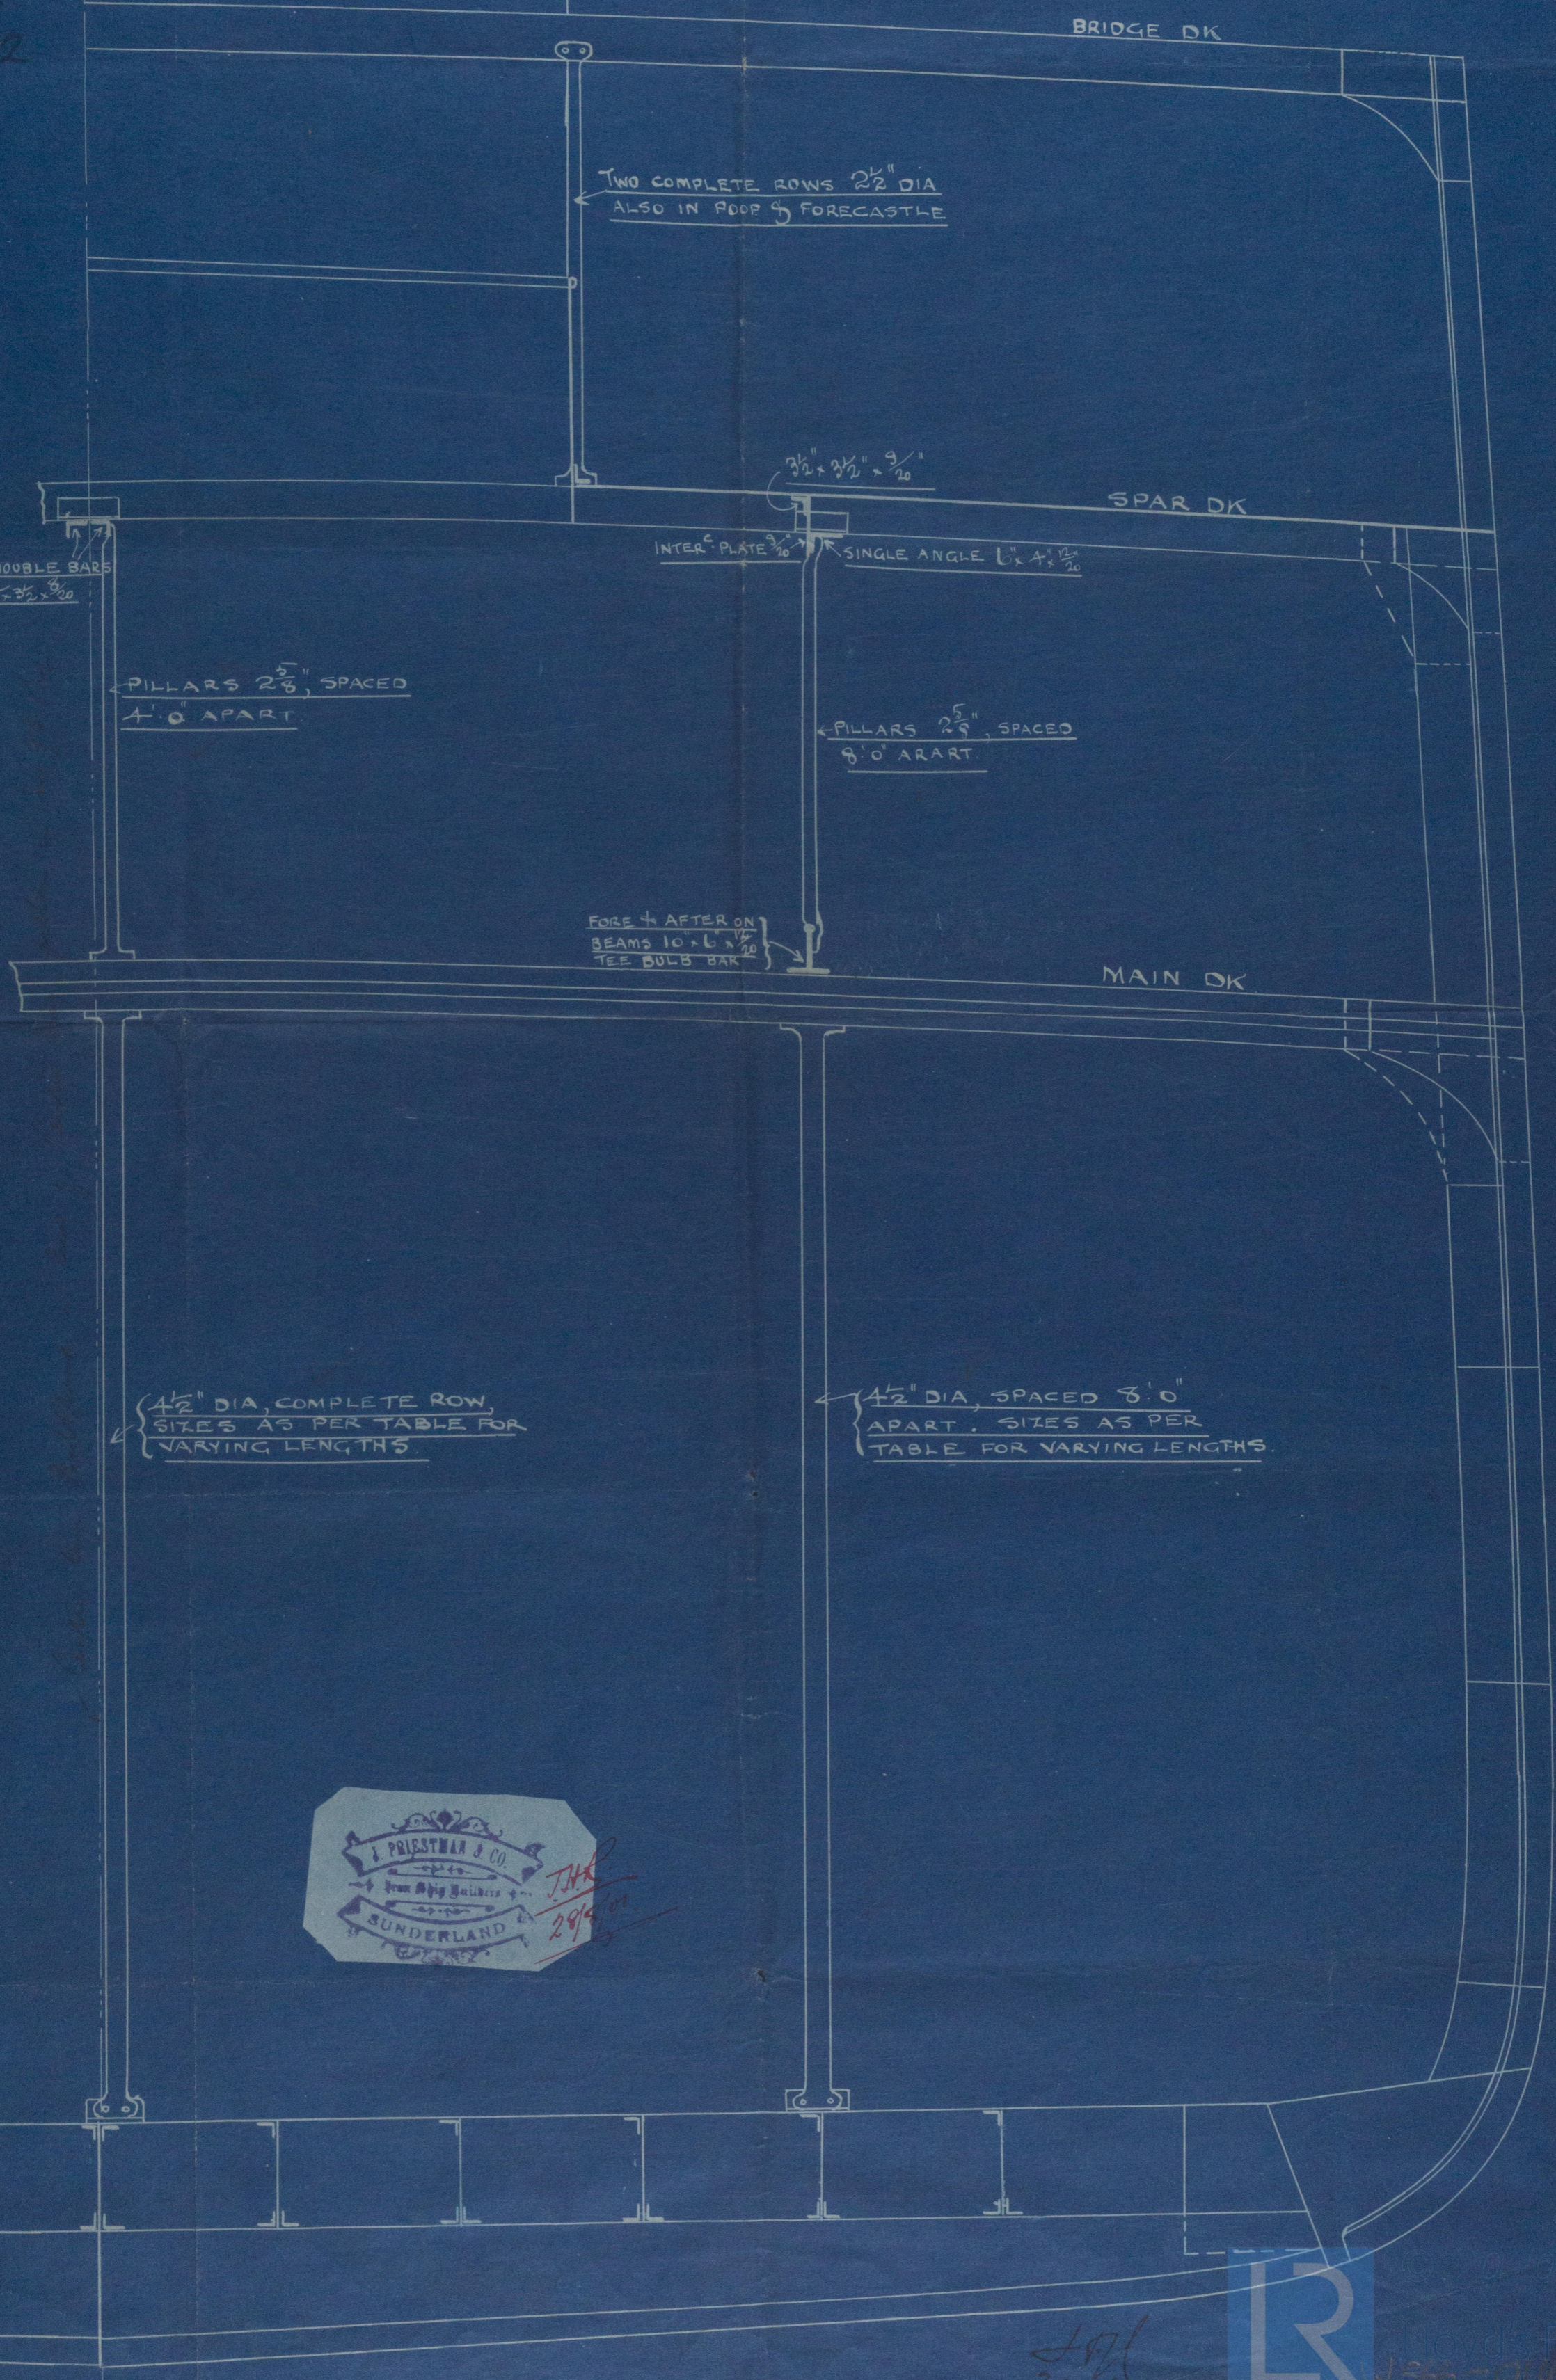

J.H.R.
3/9/01



Lloyd's Register
1000-0143

Messrs J. Priestman & Co



~~X~~ Pillar Plan

No. 92. Shear

No 92 = SS "Manaton"

~~No 93 =~~

Sunderland No 20858

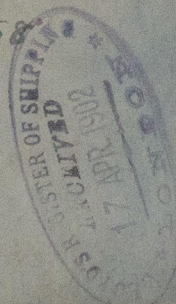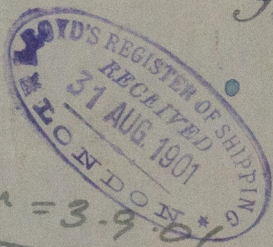


See Letter = 3.9.01



S.S. "Burrafield"

Sunderland No. 21103.

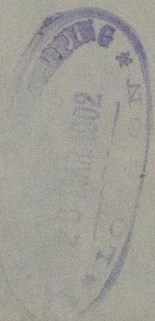

RETAIL



© 2020

Lloyd's Register of Shipping