


2.1.13
24.9.13
29.10.13 (10337)
26.1.14
23.2.14

LONGITUDINAL SECTION OF SINGLE SCREW STEAMER
DIMENSIONS 470' x 58'-0" x 35' MLD.
TO CLASS 100 A1 AT LLOYDS
SCALE 1/8" INCH = 1 FOOT
Nos 336 & 337

 

submitted to surveyors satisfaction.

C.B.
2.7.13.





Profile

Messrs. Workman Clark & Co.

No. 336

Also No. 337

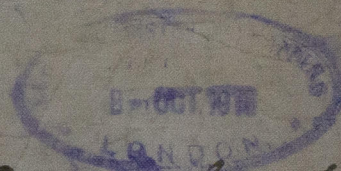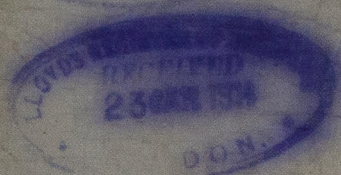

s/s Carmarthenshire
Rel 7495.



s/s Pembrokeeshire
Rel 207517.



Lloyd's Register
Foundation

N568-0317

THE SCREW STEAMER
DIMENSIONS
SCALE 1/4" = 1'

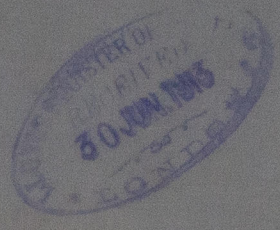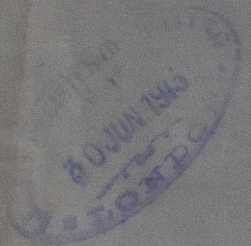

Deck Plans - Quarters, Galley, etc.

