


AWNING DECK IRON PLAN

Altualine in Red "St-Andre"
No. 387

D¹ PLATING TO HAVE LAPPED BUTTS, DOUBLE RIVETED
 1/2" LENGTH TO SINGLE BEYOND
 D¹ PLATING LANDINGS TO BE SINGLE RIVETED
 STRINGER TO HAVE LAPPED BUTTS TREBLE RIVETED
 FOR 3/4" LENGTH TO DOUBLE AT ENDS.

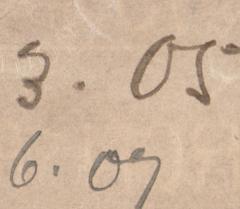


15 17/2/6

Running deck

J. Brown & Co.

No. 370 + 371 382

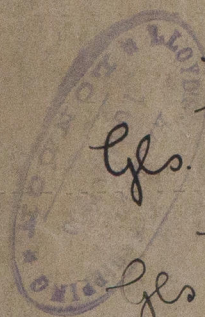

"St. David"

Gls. rpt. No. 24351

"St. Patrick"

Gls. rpt. No. 24353



No 382. St. "St. Andrew"

Glasgow report. No. 26561

RETAIN



© 2020

Lloyd's Register
Foundation